



Samþykkt þann  
 15. mars 2022  
 F.h. byggingarfulltrúans í Hafnarfirði,  
 Hjálmar A. Jónsson  
 T 193


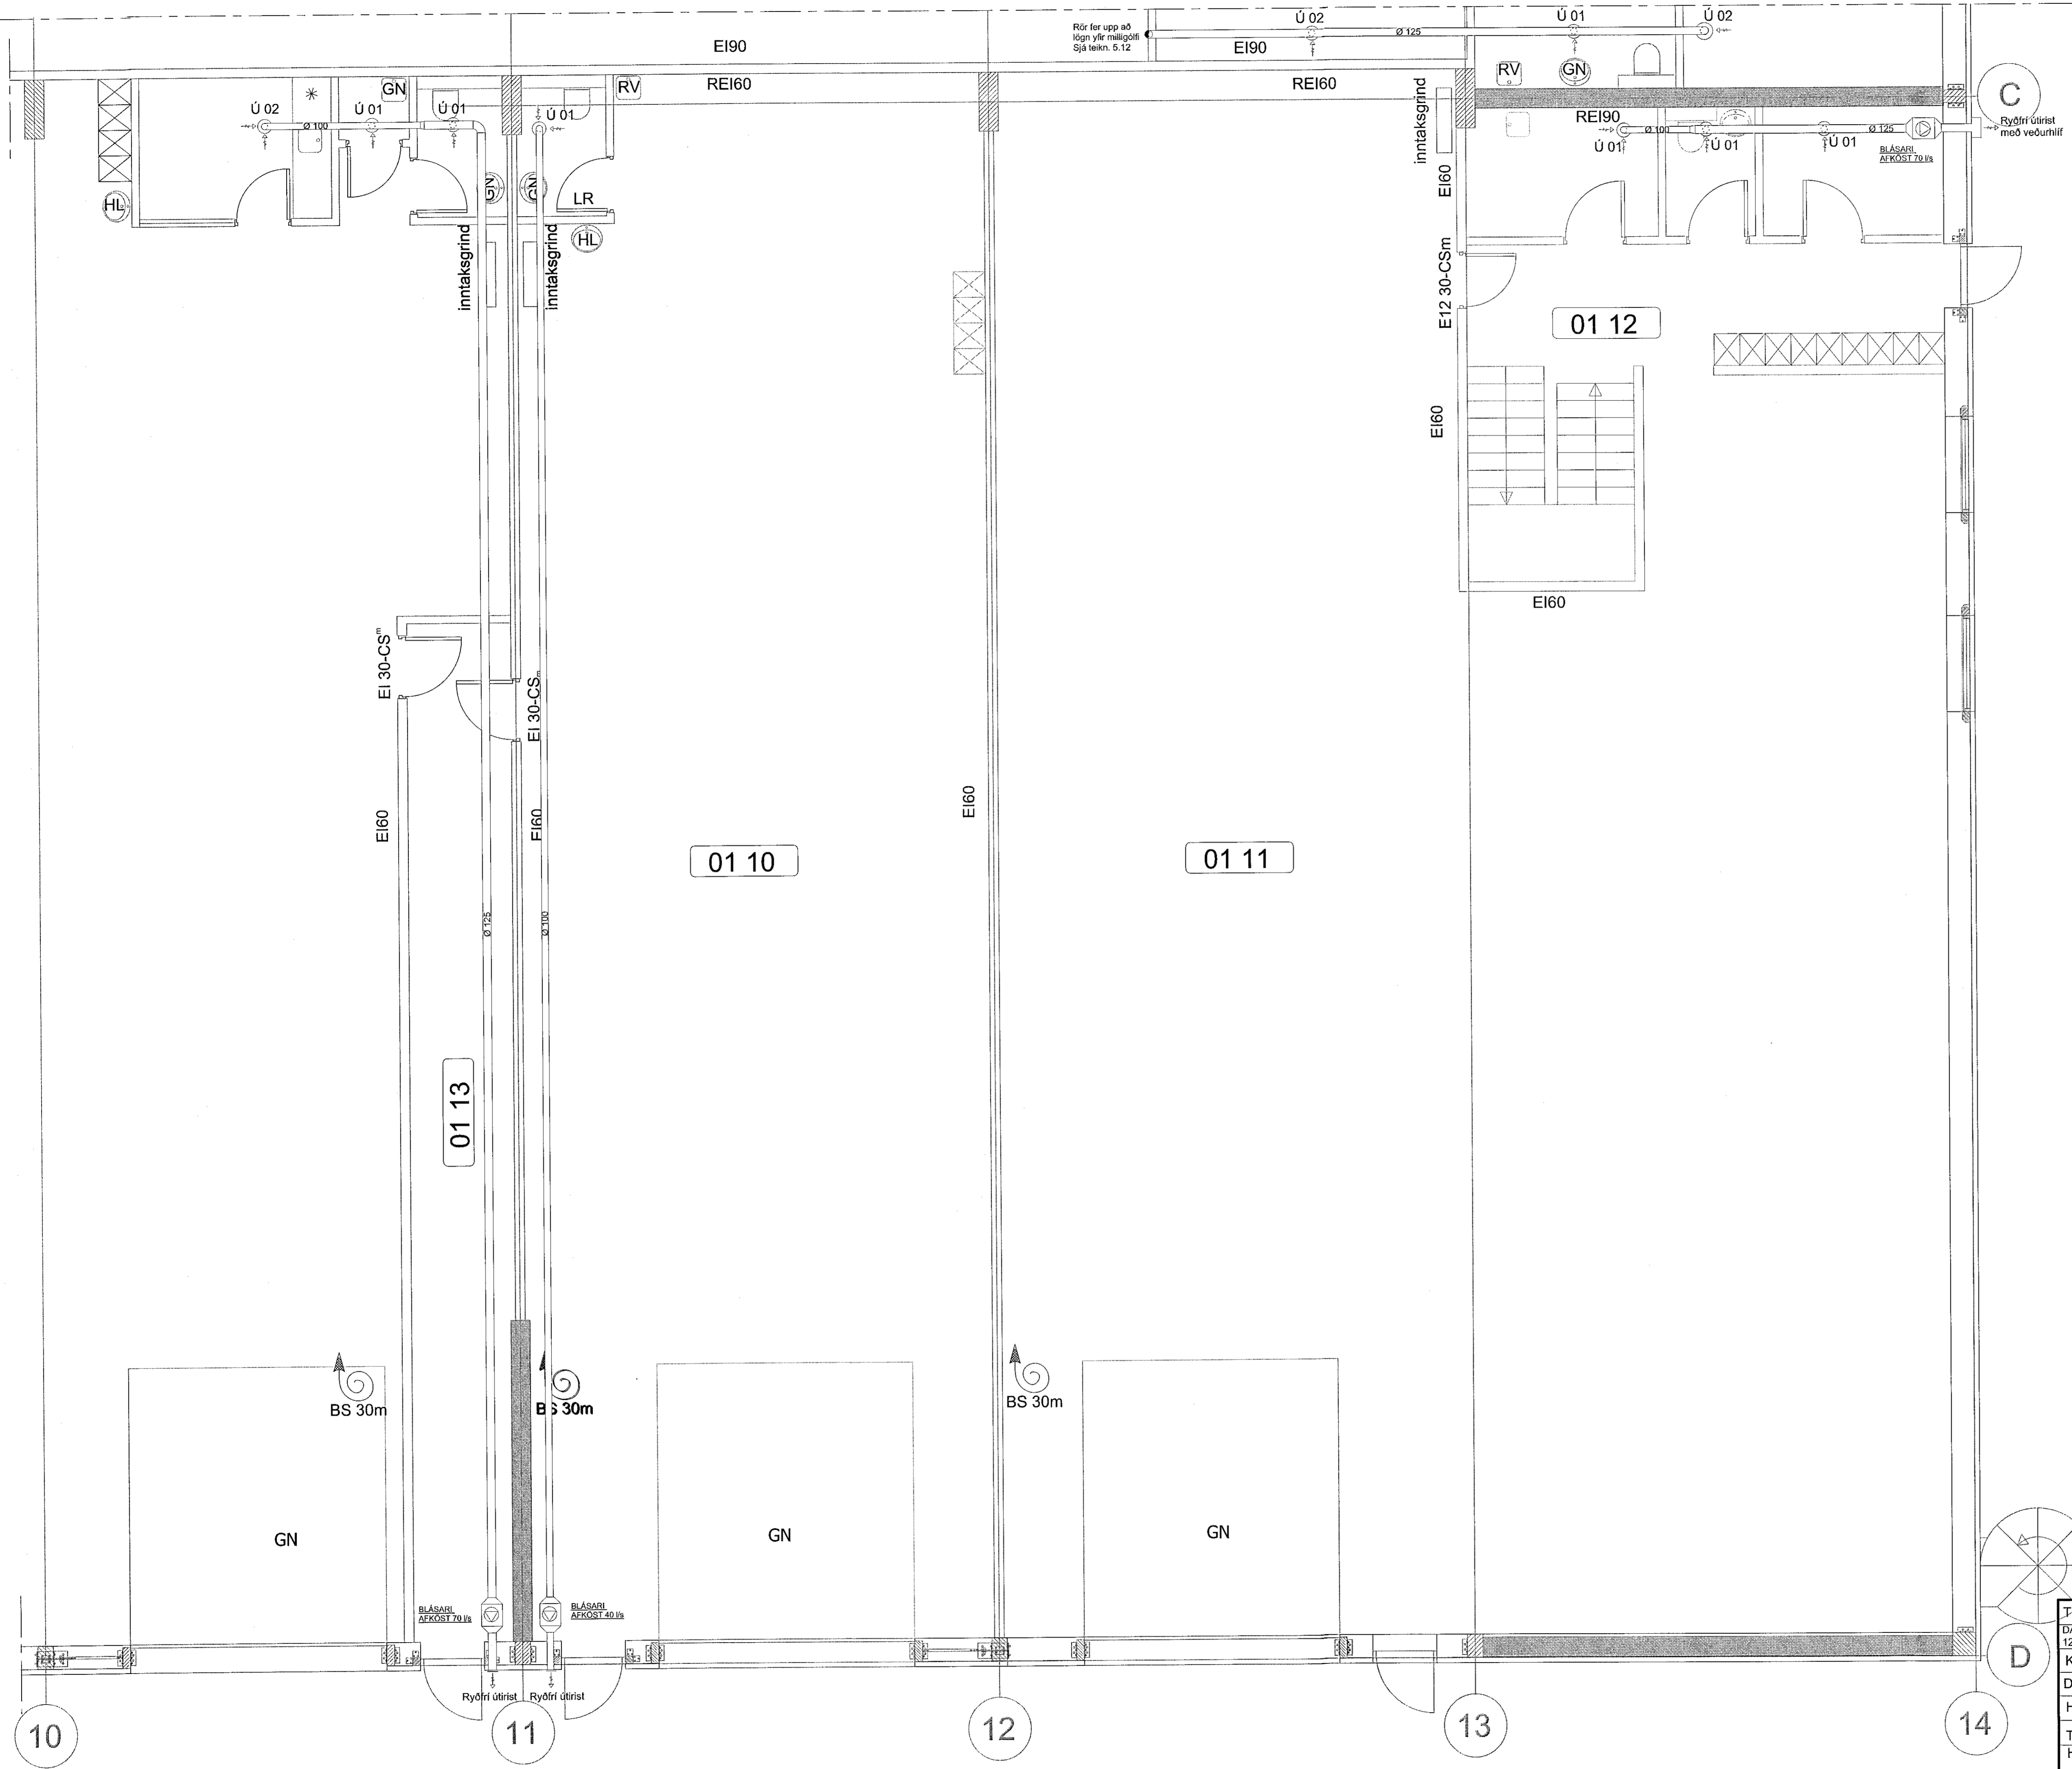


LYKILMYND 1:1000

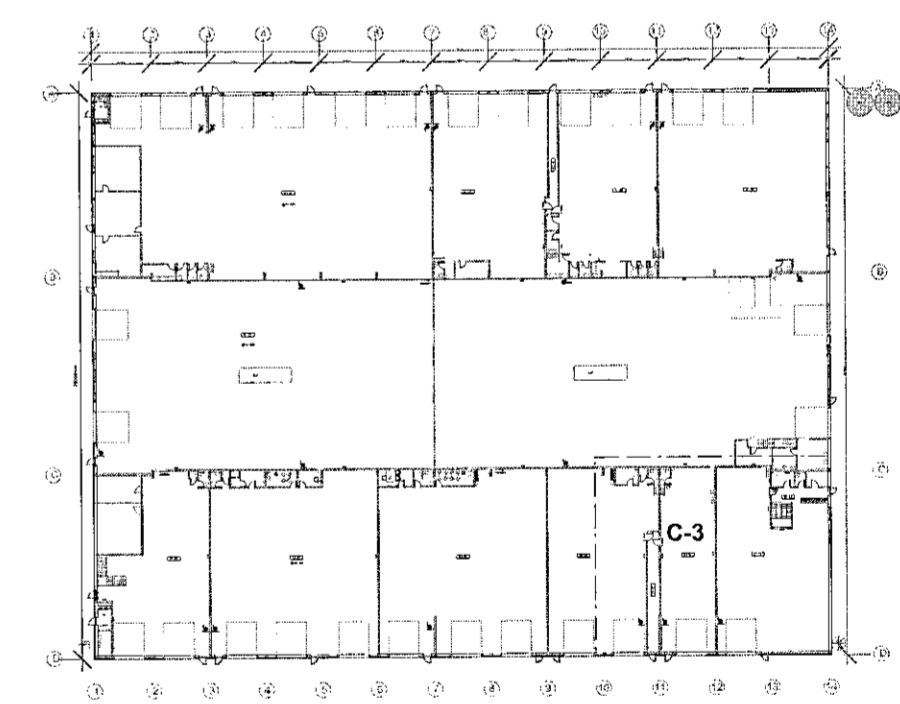

SJÁ SKÝRINGAR Á TEIKNINGU NR. 5.00

(A) Breytt: 10.03.2022 (Breyttar Aðalteikningar og reyndarteikning framkvæmdar)

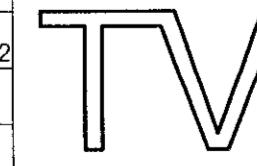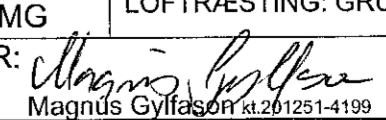TEIKN.NR. 5.10	 Tæknivanur ehf. KT 450586-1888 Kirkjuseit 26, 113 Reykjavík Sími: 564 22 44, Netf. tv@vortex.is
DAGS. AÐALTEIKNINGA: 12.03.2019 / Br. 16.02.2022	
KVARDI: 1:50	
DAGS: 28.06.2019	
HANNAÐ: MG	VERKEFNI: ISHELLA 1 Í HAFNARFIRÐI
TEIKNAD: MG	LOFTRÆSTING: GRUNNMYND AF LOFTRÆSTILÖGNUM, HLUTI C-3
HÖNNUÐUR:  Magnús Gylfason 41261251-4199	 Undirskrift Hönnunarstjóra 41091162-3009