


Sjá teikningu E23.3.101

Sjá teikningu E23.3.104

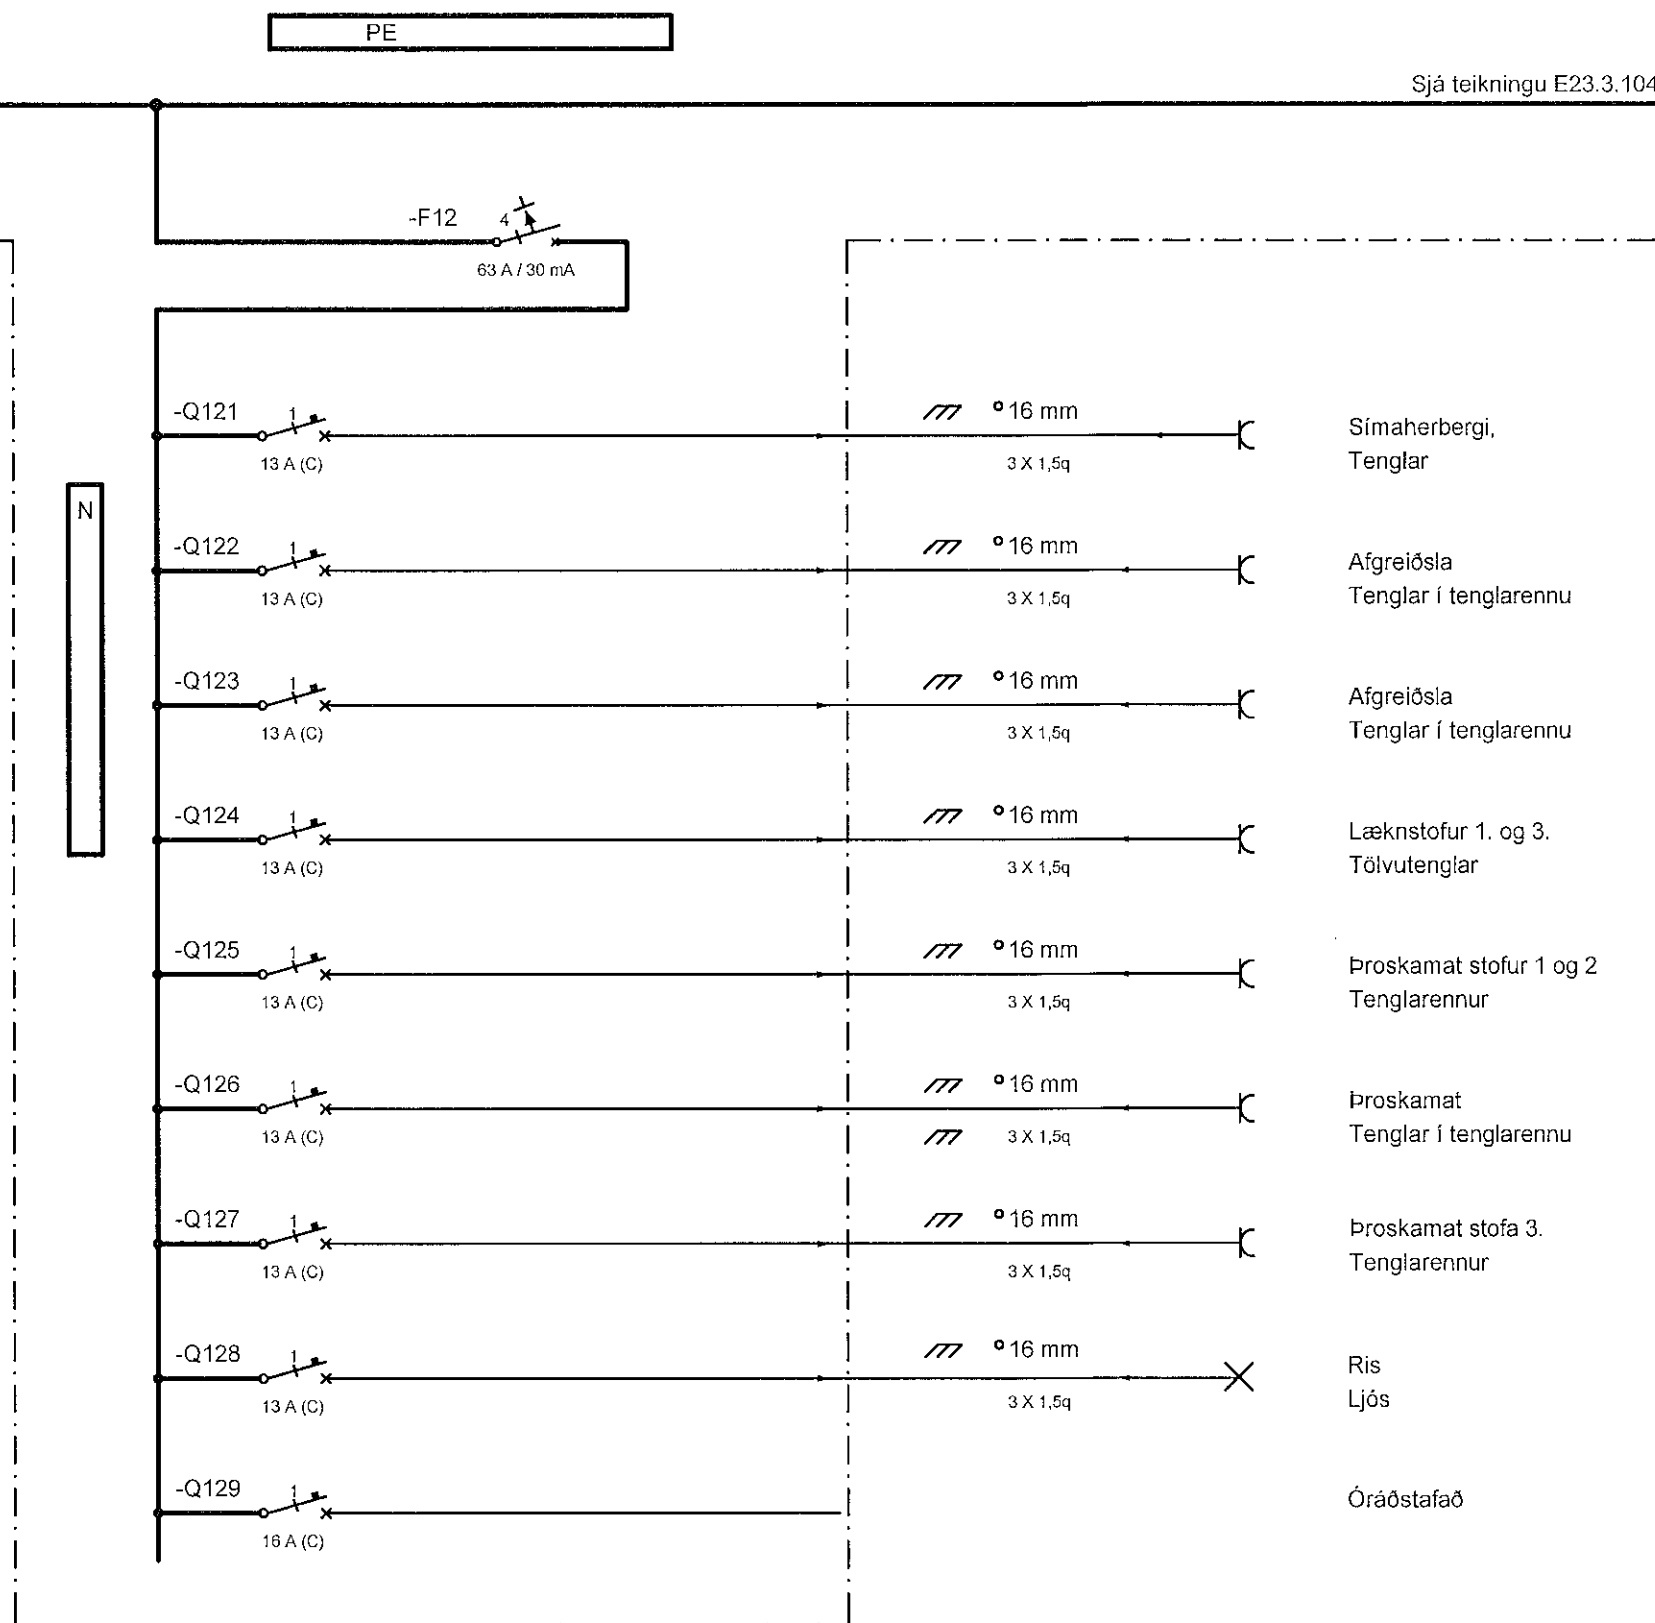

www.verkis.is - sími: +354 422 8000

SAMBÝKKT: Bragi Þór Sigurdórssón *Bþ* 3009492829

B 2021-12-27 REYNDARTEIKNING BPS

A 2019-09-05 VERKTEIKNING BPS BPS EME BPS

ÚTG DAGS SKÝRINGAR TEIKNING HANN RÝNT SAMB

SÓLVANGSVEGUR 2, HAFNARFIRÐI
HEILSUGÆSLUSTÖÐIN SÓLVANGUR
Rafkerfi
Dreifiskápur D
Einlínunmynd

VERKFANG 17120 TEIKNING E23.3.103 B