


Samþykkt þann
22. MAR. 2023
Byggingartillitun
Hönnun
Hönnun
Hönnun

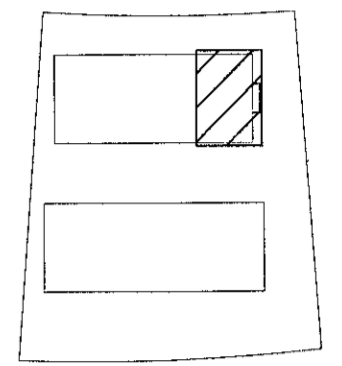

LYKILMYND

NF

BR	DAGS	BREYTING
LR	07.02.2023	Vaskar we færðir frá rennsli tengt skolyask
HÖNNUNARSTJÓRI: <i>Hann Þorsteinsson</i>		

HJARDARIHOLT 11
860 SELFOSS
SÍMI: 783 4180
HÖNNUN NETFANG: kjartan@dagur.com

Ártún ehf. 12.07.2021
Borgarhella 13 mhl. 01
Lagnir:
Grunnmynd frárennslislagna. Kvarði 1:50

HANNAD:	TEIKNAD	DAGSETNIG	VERKNÚMER
KG	KG	20.12.2021	2021-36
SKRÁARNAFN	SAMÞYKKT	130555-7649	TEIKNING NÚMER:
Borgarhella 13 Lagnir.dwg			306

Grunnmynd fráveitulagna
MKV: 1:50