


O PN

Borgarhella
13 mhl. 01

Samþykkt þann
22. MAR. 2023
Byggingarfulltrúan / ríðgjafi
Stefan Þjornarson

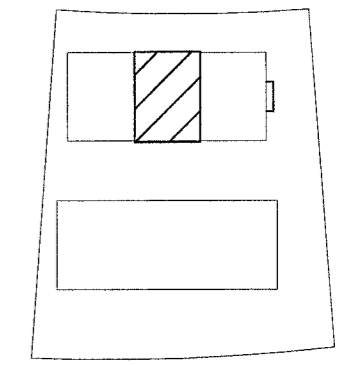

LYKILMYND

BR	DAGS	BREYTING
LR	07.02.2023	Vaskar wc færðir, frjæfshli tengt skolvask
KG	01.10.2022	Stofn vatnslagna lagðar undir gólfplötur

HÖNNUNARSTJÓRI: *Stefan Þjornarson*

K HIARDARHOLTÍ 11
800 SELFOSSI
SÍMI: 783 4180
HÖNNUN NETFANG: kjarfangardars@gmail.com

Ártún ehf. 12.07.2021

Borgarhella 13 mhl.01			
Lagnir: Grunnmynd hitalagna.			Kvarði 1:50
HANNAÐ:	TEIKNAD	DAGSETNIG	VERKNÚMER
KG	KG	20.12.2021	2021-36
SKRÁARNAFN	SAMÞYKKT	130555-7649	TEIKNING NÚMER:
Borgarhella 17, 19, 21 Lagnir.dwg			325

Grunnmynd hitalagna
MKV: 1:50

O PN