


Bergsskarð 1, Hafnarfjörður


Hita- og neysluvatnslagnir
 Ásýndir neysluvatnslagna

Robert A. Robertsson

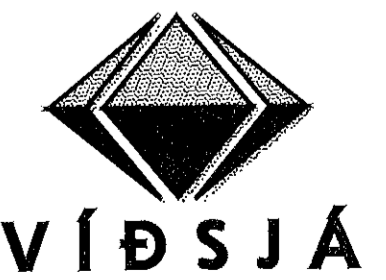

VÍÐSJA

VERKFRÆÐISTOFA FRV
 TRYGGVAGATA 11, 101 REYKJAVÍK
 Sími: 591 9040, NETFANG: vidsja@vidsja.is
 www.vidsja.is

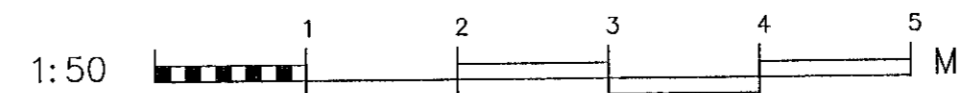

PROJEKTUR	AB	TEKNIKUR	DR	SKALA	1/50	VERKFR.	17-106
ÁR	NP02 og NP04 breytt	DAGS	01.09.2022	DR	SAÞA	Lagnir	TEKNIKUR
VIÐSJA		NAFN	Agúst Birgisson	160557-4199	DAGS	30.08.2022	P 12A