


Núverandi Reiðhöll

Brl.

Sjá arkitekt

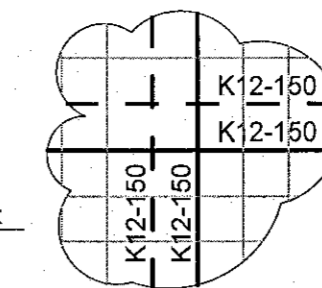


CZ  
3,00

CHS 114,3 x 4,0

CHS 114,3 x 4,0

Brl.

Sjá arkitekt

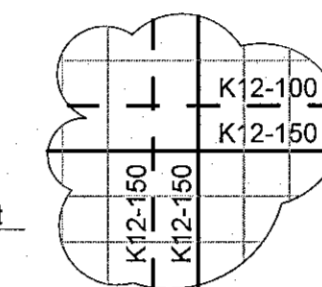

CHS 114,3 x 4,0

CHS 114,3 x 4,0

CHS 114,3 x 4,0

CHS 114,3 x 4,0

CHS 114,3 x 4,0

Sampykkt þann  
16. maí 2023  
f.h. byggingarfulltrúans í Hafnarfirði  
Róbert A. Róbertsson

ÚTD. DAGS. ÚTGÁFUFERILL HANNAÐ TEIKN. YFIRF.

Skýringar:  
Sjá almennar skýringar á teikningum:  
B\_A\_xx\_02  
B\_A\_xx\_03  
B\_A\_xx\_04



Reiðhöll Sörla  
Sörlaskeið 13a  
221 Hafnarfjörður

Burðarbol  
Stálvirki og þak  
Grunnmynd hluti 2

TEIKNUNUMÉR	BLAÐSTÆRD	HANNAÐ	JF
21-045	A1	TEIKNAD:	JF
B_G_02_02		YFIRFARID:	KSG
DAGS.	MELIUVARID	ÚTGÁFA	
28.4.2023	1:50	A	

Dagsetning aðaluppdráttar:  
Hönnuður: Jóhann Fríðriksson, kt.160777-4439  
Hönnunarsjóni: Þóður Steingrímsson kt. 071051-3489

Grunnmynd - hluti 2  
M 1:50

