


Staðfesting
16. Júní 2021
Bygginguldróm 1 Hafnarfjörð

ORRI ÁRNASON KT. 08086-5749
UNDERSKRIFT

ÖLL AF RITUN TERNINGAR, AD HILUTA EDA HEILD, ER HÁÐ SKRIFLEGU LEYFI HÖFUÐA

ÚTGÁFUERILL			
ÚTGA	DAGS	SKYRNINGAR	SAVA
C1	14.04.21	Verkteikning	KE
C2	18.05.21	Breyting á halla	KE

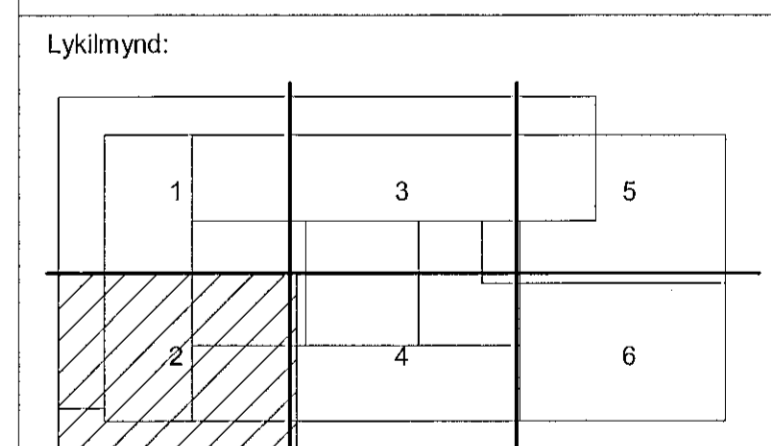

LOTA
Guðfróastigur 2-4 S. 560 5400, www.lota.is


HEITI VERKS:
LINDE - NSH
BÚÐAHELLA 8
HAFNARFJÖRÐUR

HEITI TERNINGAR:
BURDARPOL
STEYPA
SÖKKULL GRUNNMYND 2 AF 6

VERKENE	TERKENE	BL.NÖMUR
6636-001	LINE- C-1.102	
MÖP 1:50 A1	HANNAÐ JE	RYNI KE

NAFN OG KT. SÁÐRYGGJANDI:
KRISTINN EIRIKSSON KT. 120556-2749

[Signature]

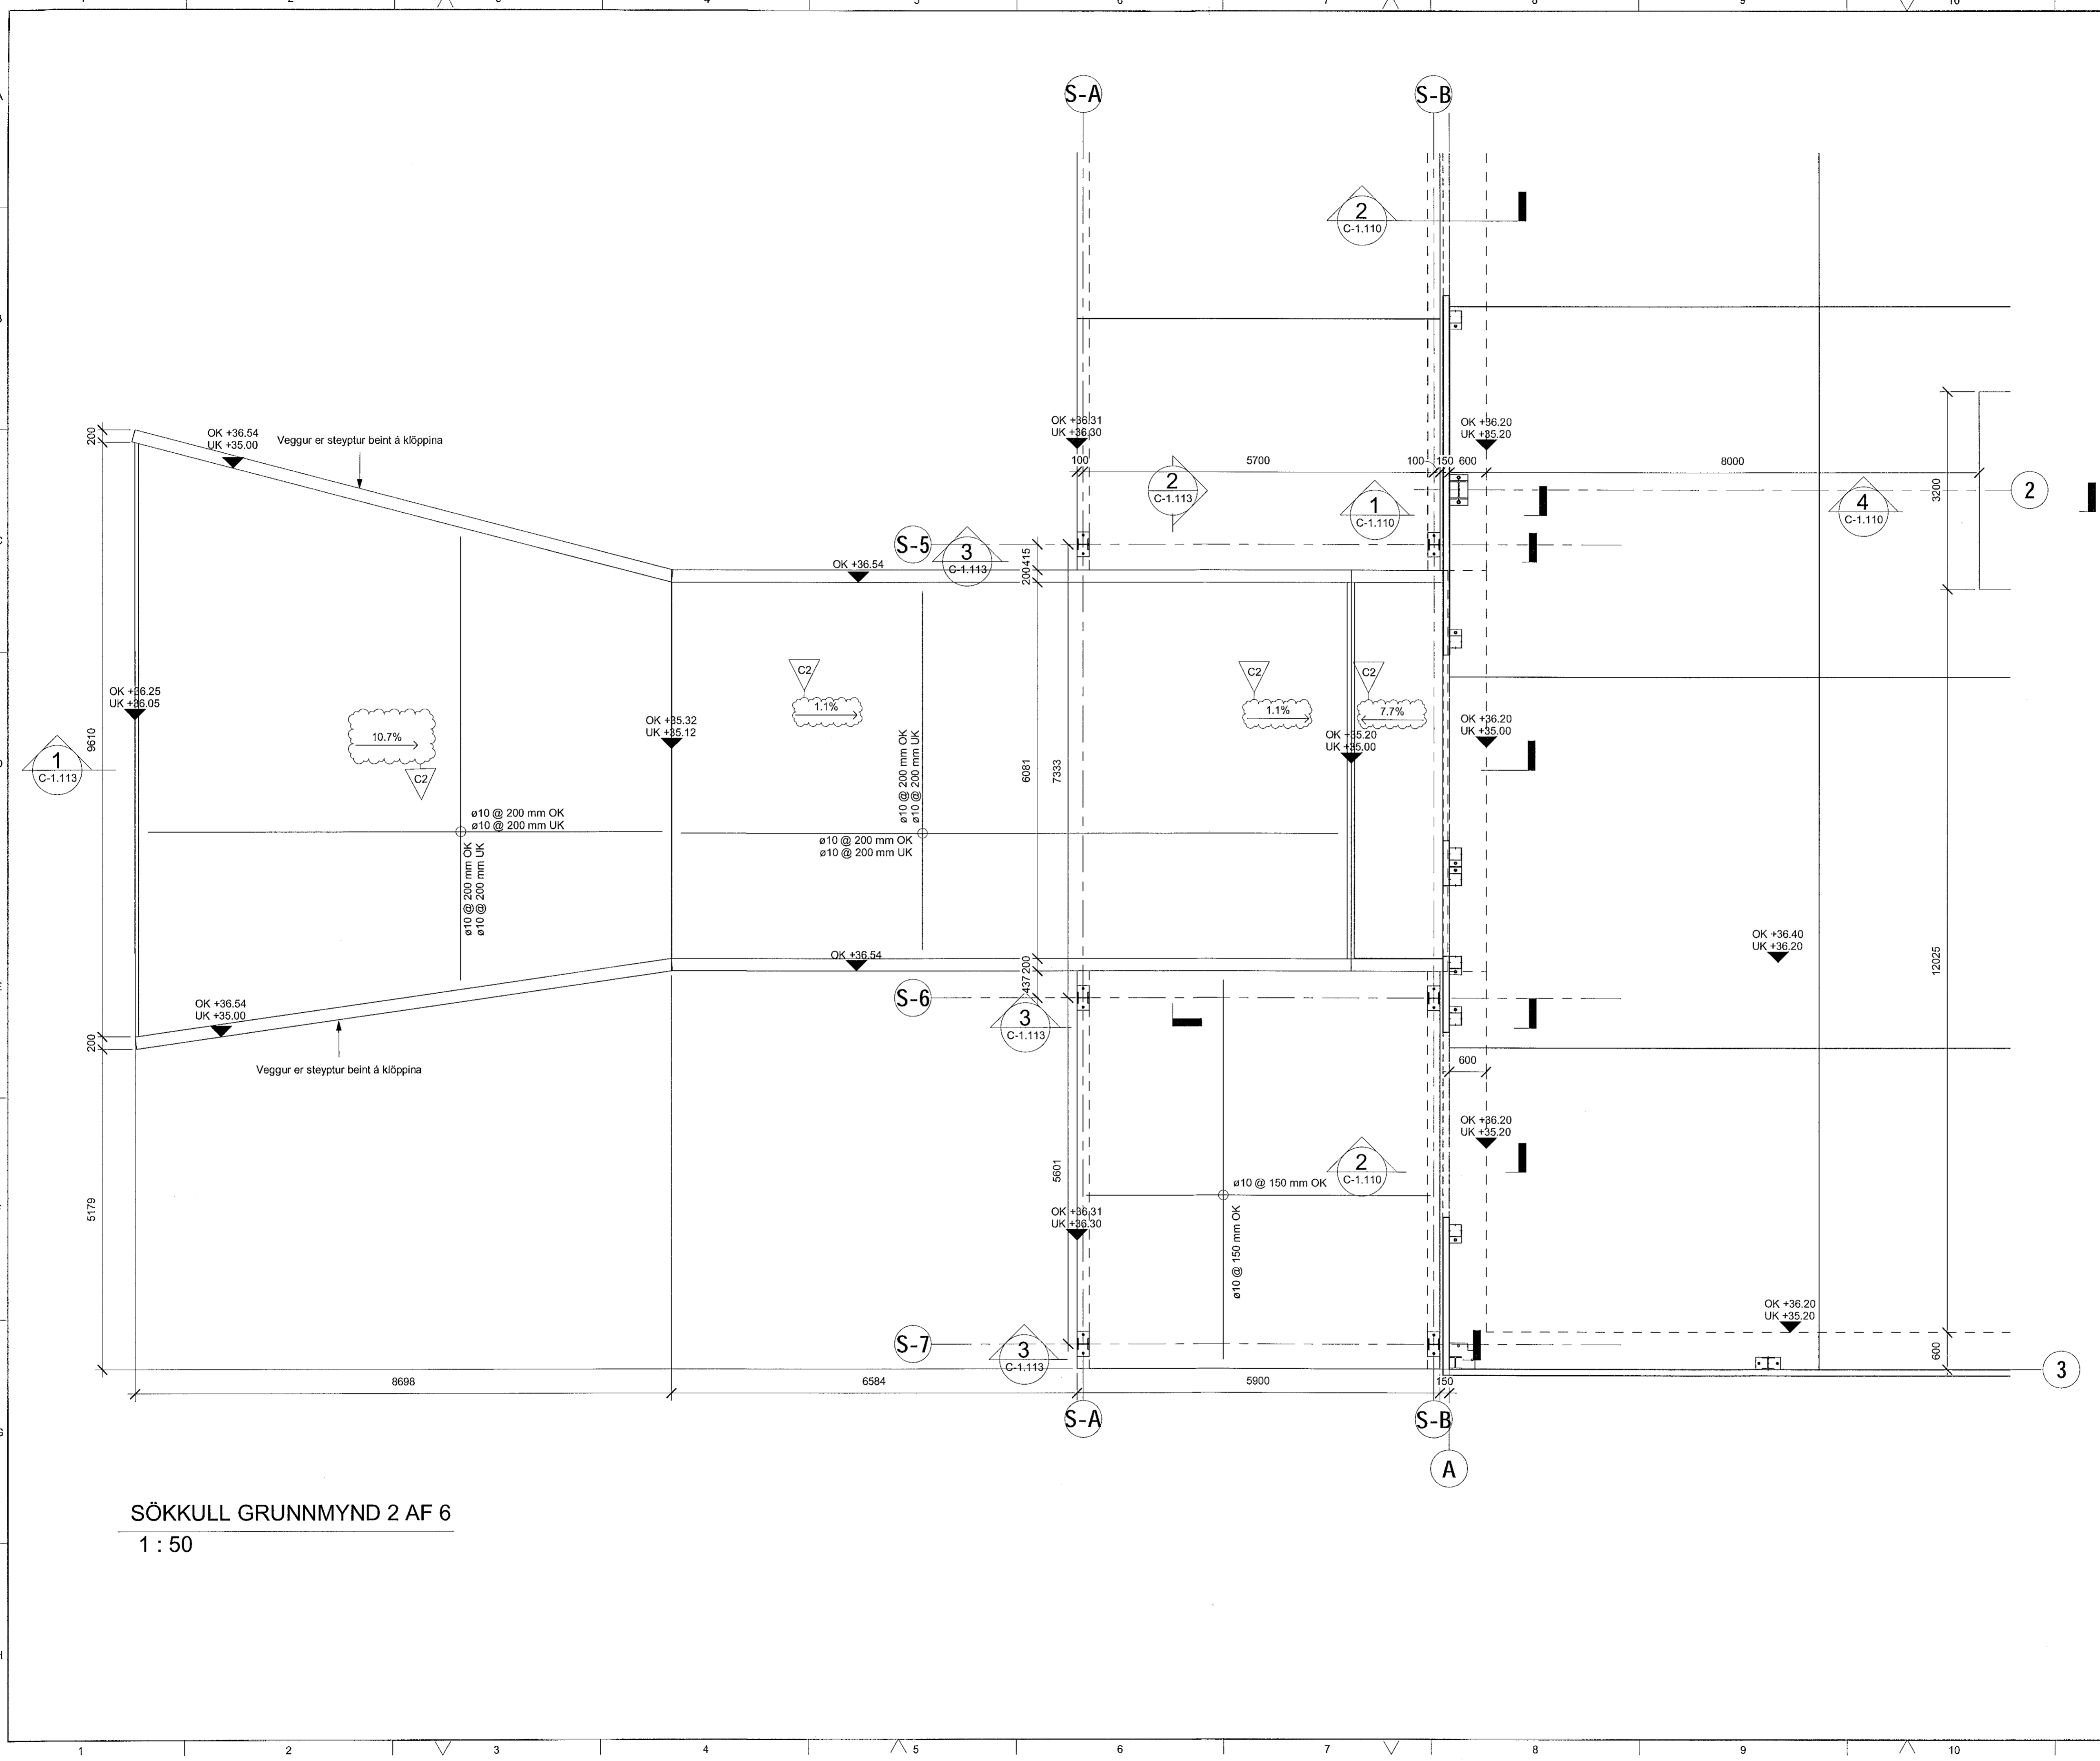

SÖKKULL GRUNNMYND 2 AF 6
1 : 50

V:\vorker\6636\001_Lota_Guðfróastigur_2-4_S.560_5400_SÖKKULL