


Útlit - Austur 50 hl
 mkv. 1 : 50

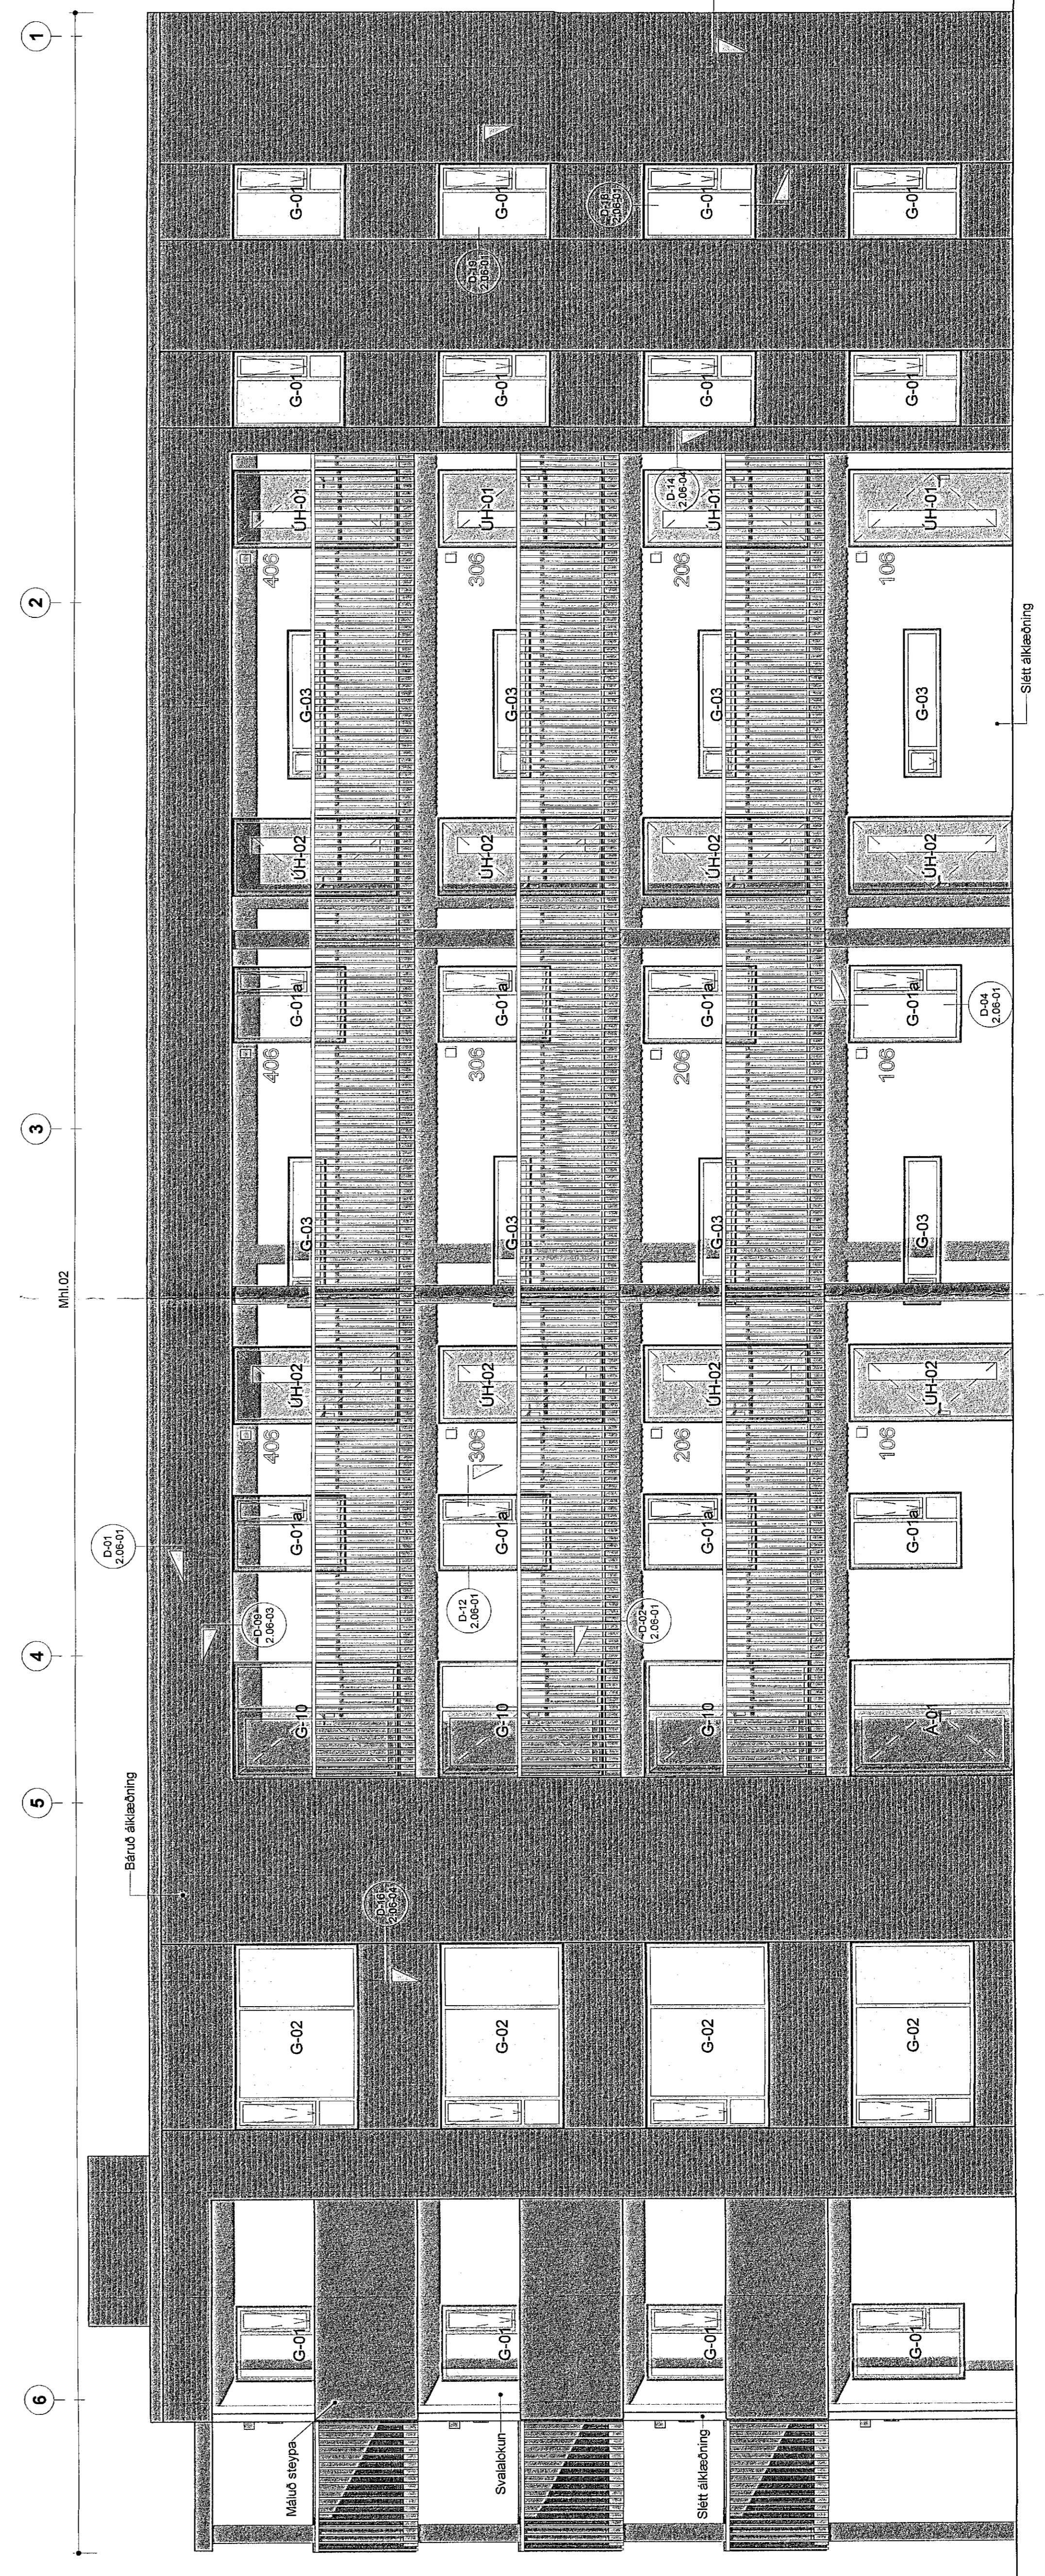

Útlit - Norður 50 hl
 mkv. 1 : 50

VERKUNING GERD A
 GRUNNADALPIÐRÁTTA
 SEM SAMBYKTIK VORU PANN
 2 8 APR 2021

T.ark
 ARKITEKTAR
 WWW.T.ARK.IS

Nónhamar 1-3, 221 Hafnarfj.
 Flóþýlishús
 Verkefningar

Útlit - Austur / Norður
 30.06.2021
 AA
 ISC
 753-16 04 2.03-01