


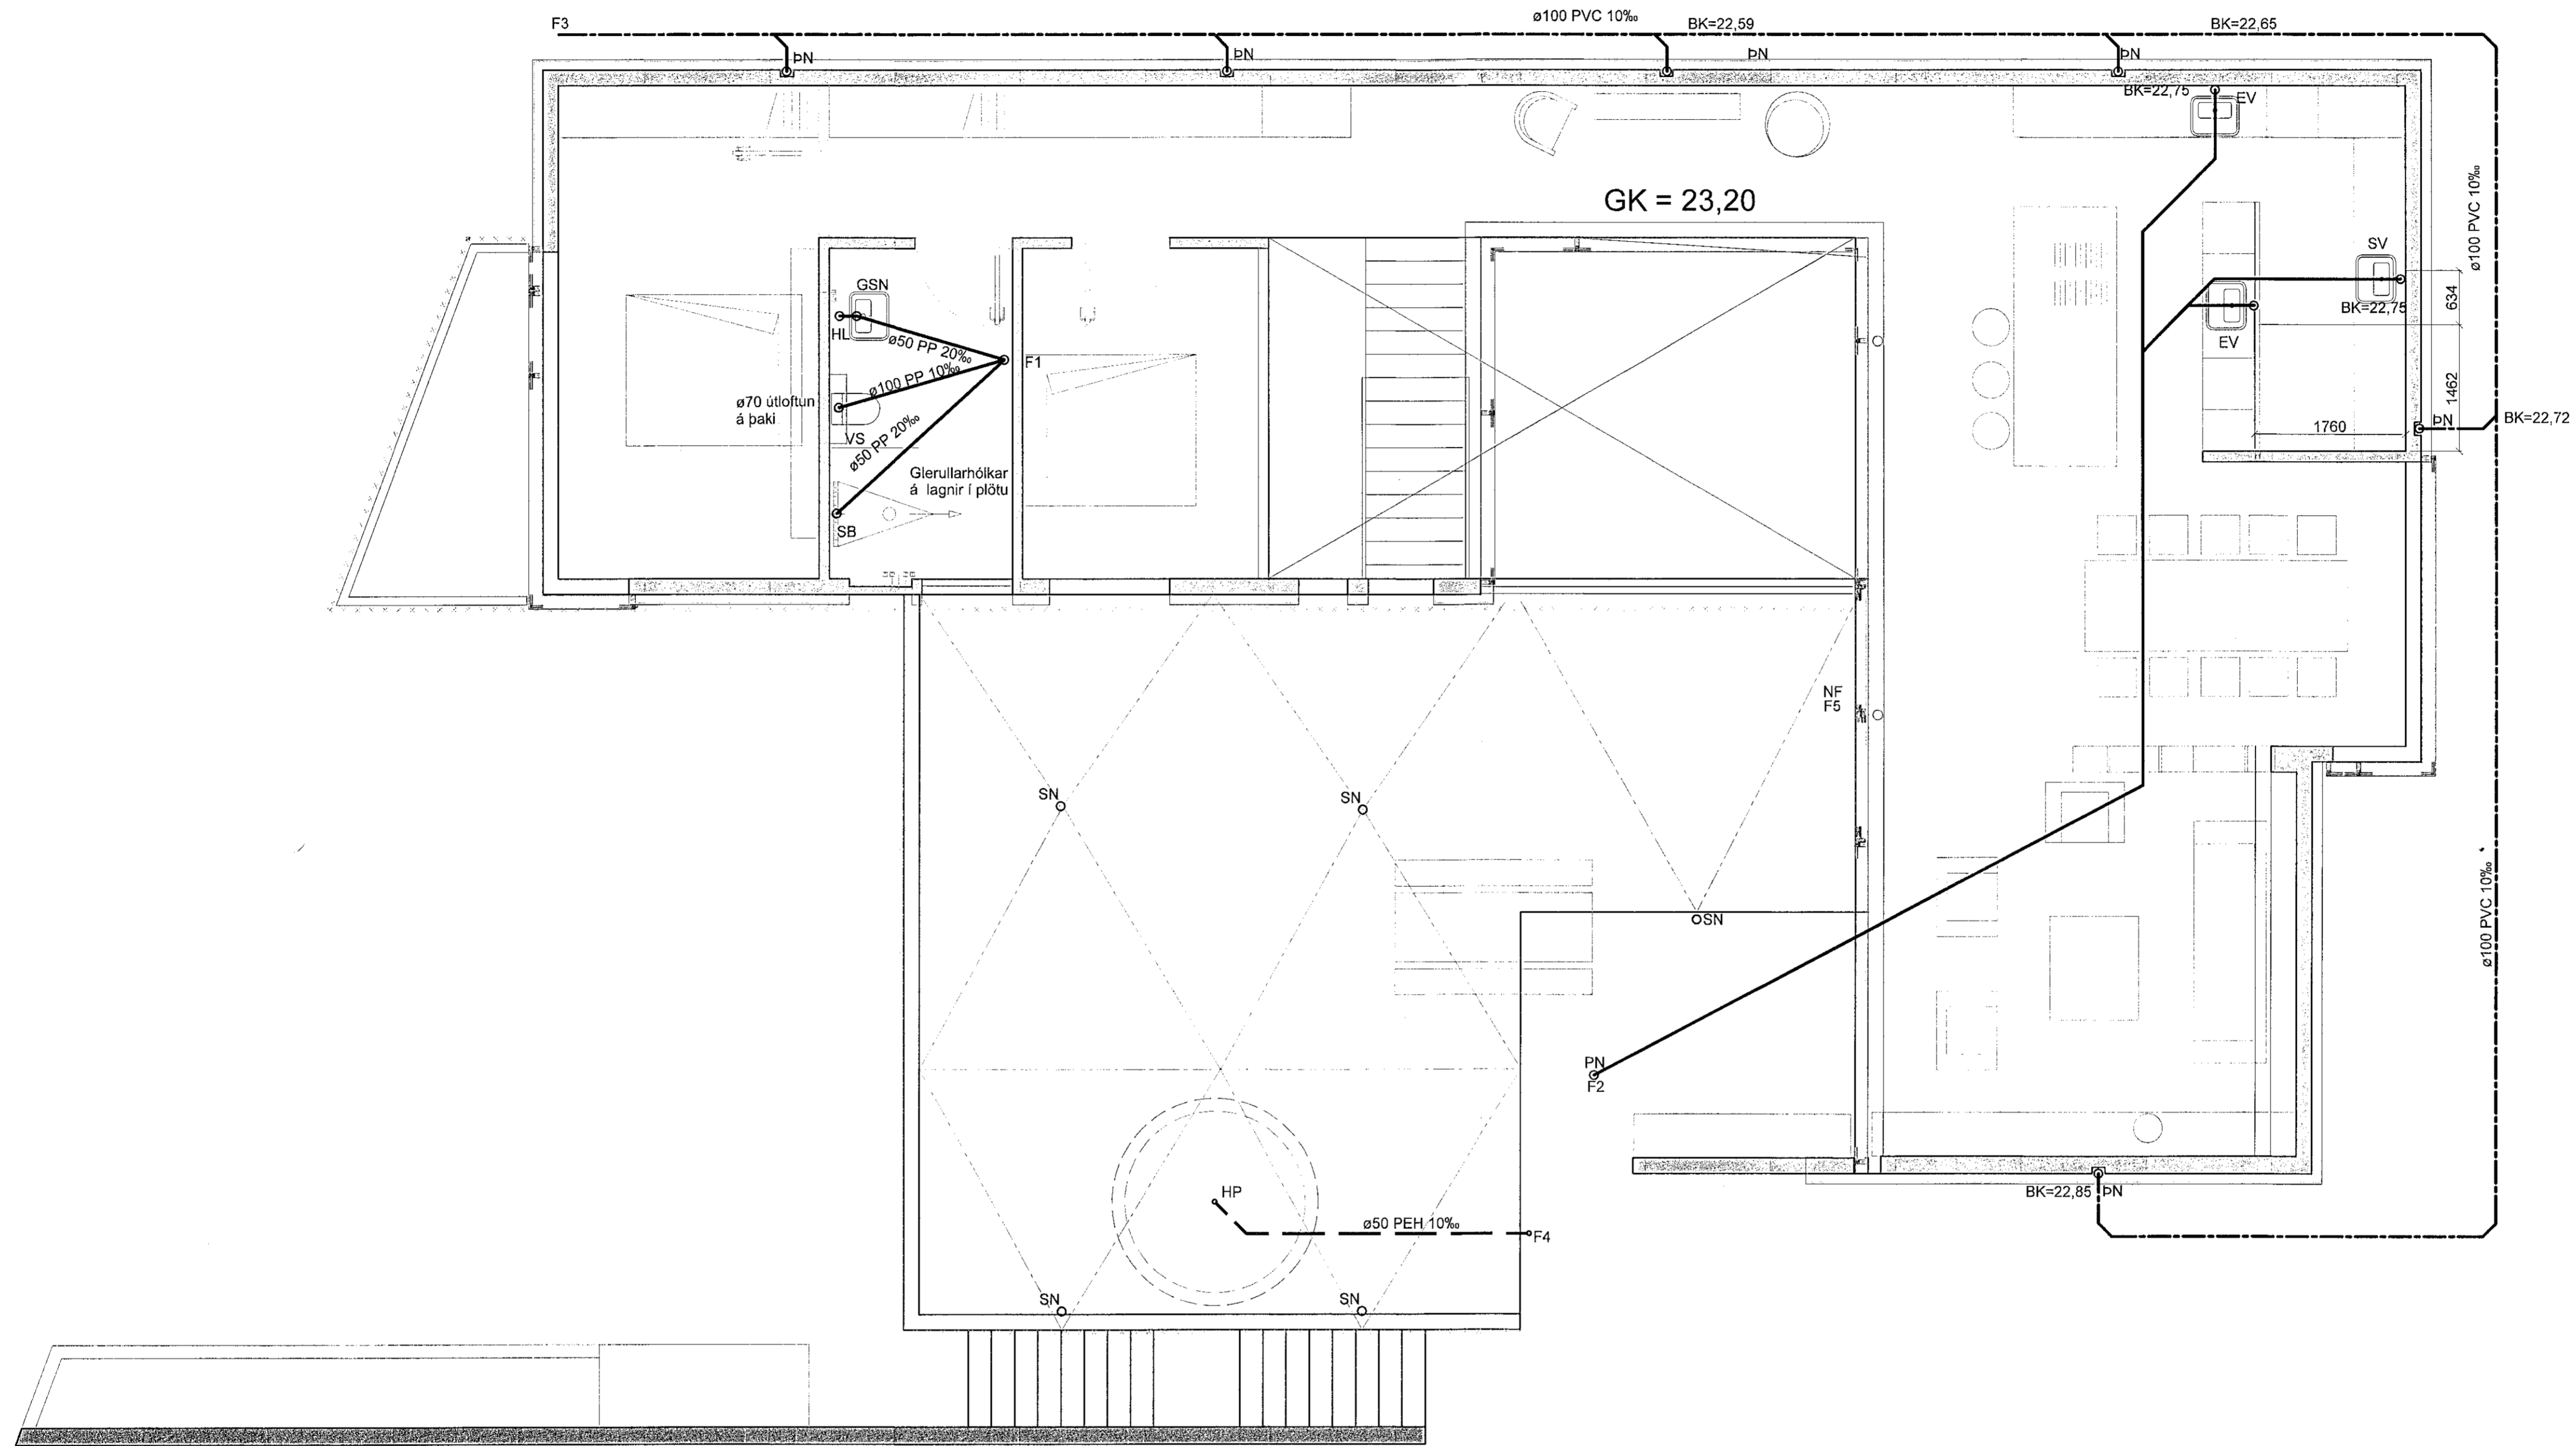


Dags:	Nr.	Breytingar:	Samb.
5.4.2022	A	Frárennslí breytt.	



P:\Verk\2021\12-43 Reykjavíkurgur 39a\03 Takhlöngur\01-Reykjavíkurgur 39a.dwg

7.7.2022 11:54:54

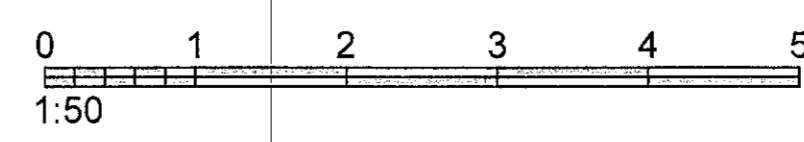

**VERKHOF EHF**

Félagið 20 • 108 Reykjavík • Sími: 517 9050 • Netfang: verkhof@verkhof.is

Heldi verks:	Reykjavíkurgur 39a 220 Hafnarfirði	Höfundur: Svavar M. Sigurðsson Björgvin O. Sigurðsson	110067-3419 110491-0279	Dagur: 18.05.2022
Heldi tekið:	Frárennslí - 2.hæð Grunnmynd	Samþykkt: <i>Þóroddur</i>	110067-3419 110491-0279	Dagur: 21-83
Áskilningur:		Áskilningur: Pálmar Kristmundsson	080455-0289	Merkur: 1:50
Bláttölur:		Bláttölur:		Utgáfur: A

VERKHOF EHF  
PÁLMAR KRISTMUNDSSON ARKITEKT 311