

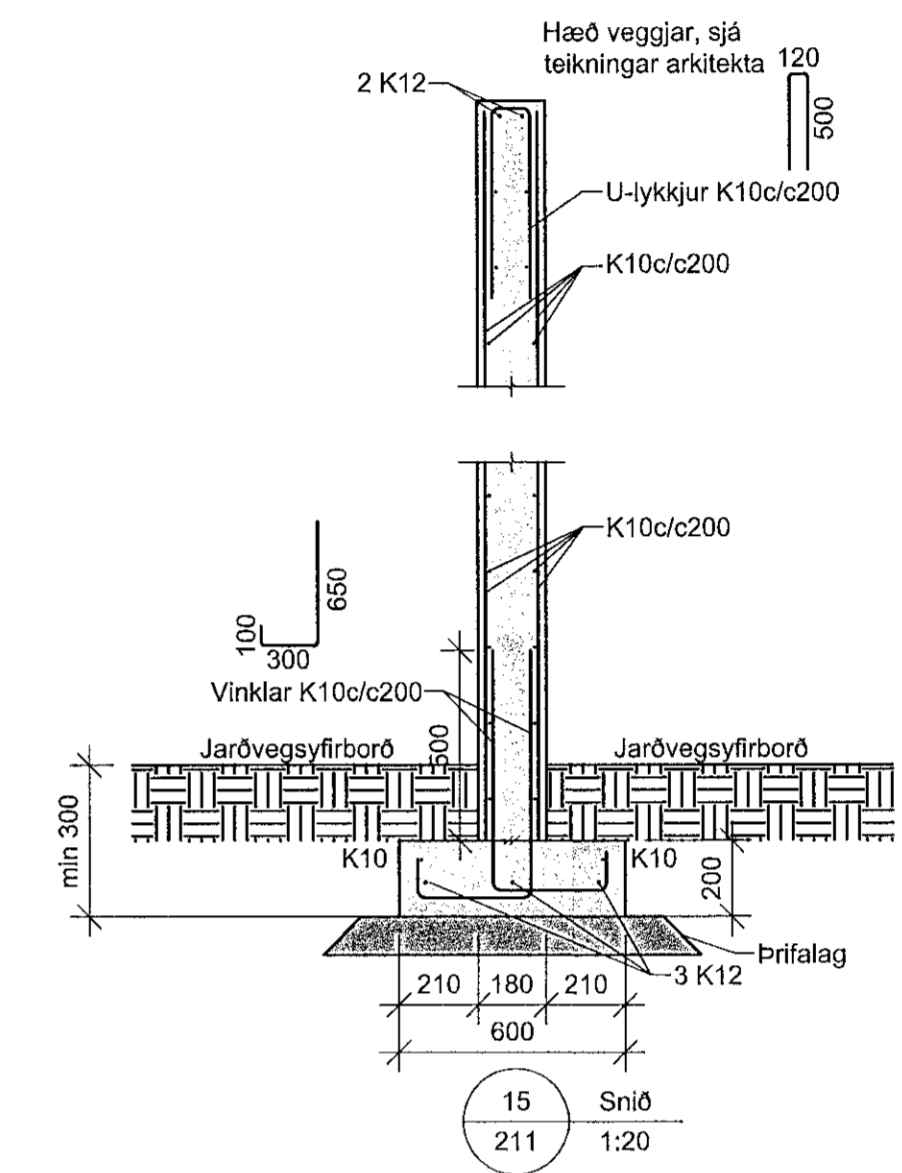


Dags:	Nr.:	Breytingar:	Samb.:
25.03.2022	A	Sökklum breytt	

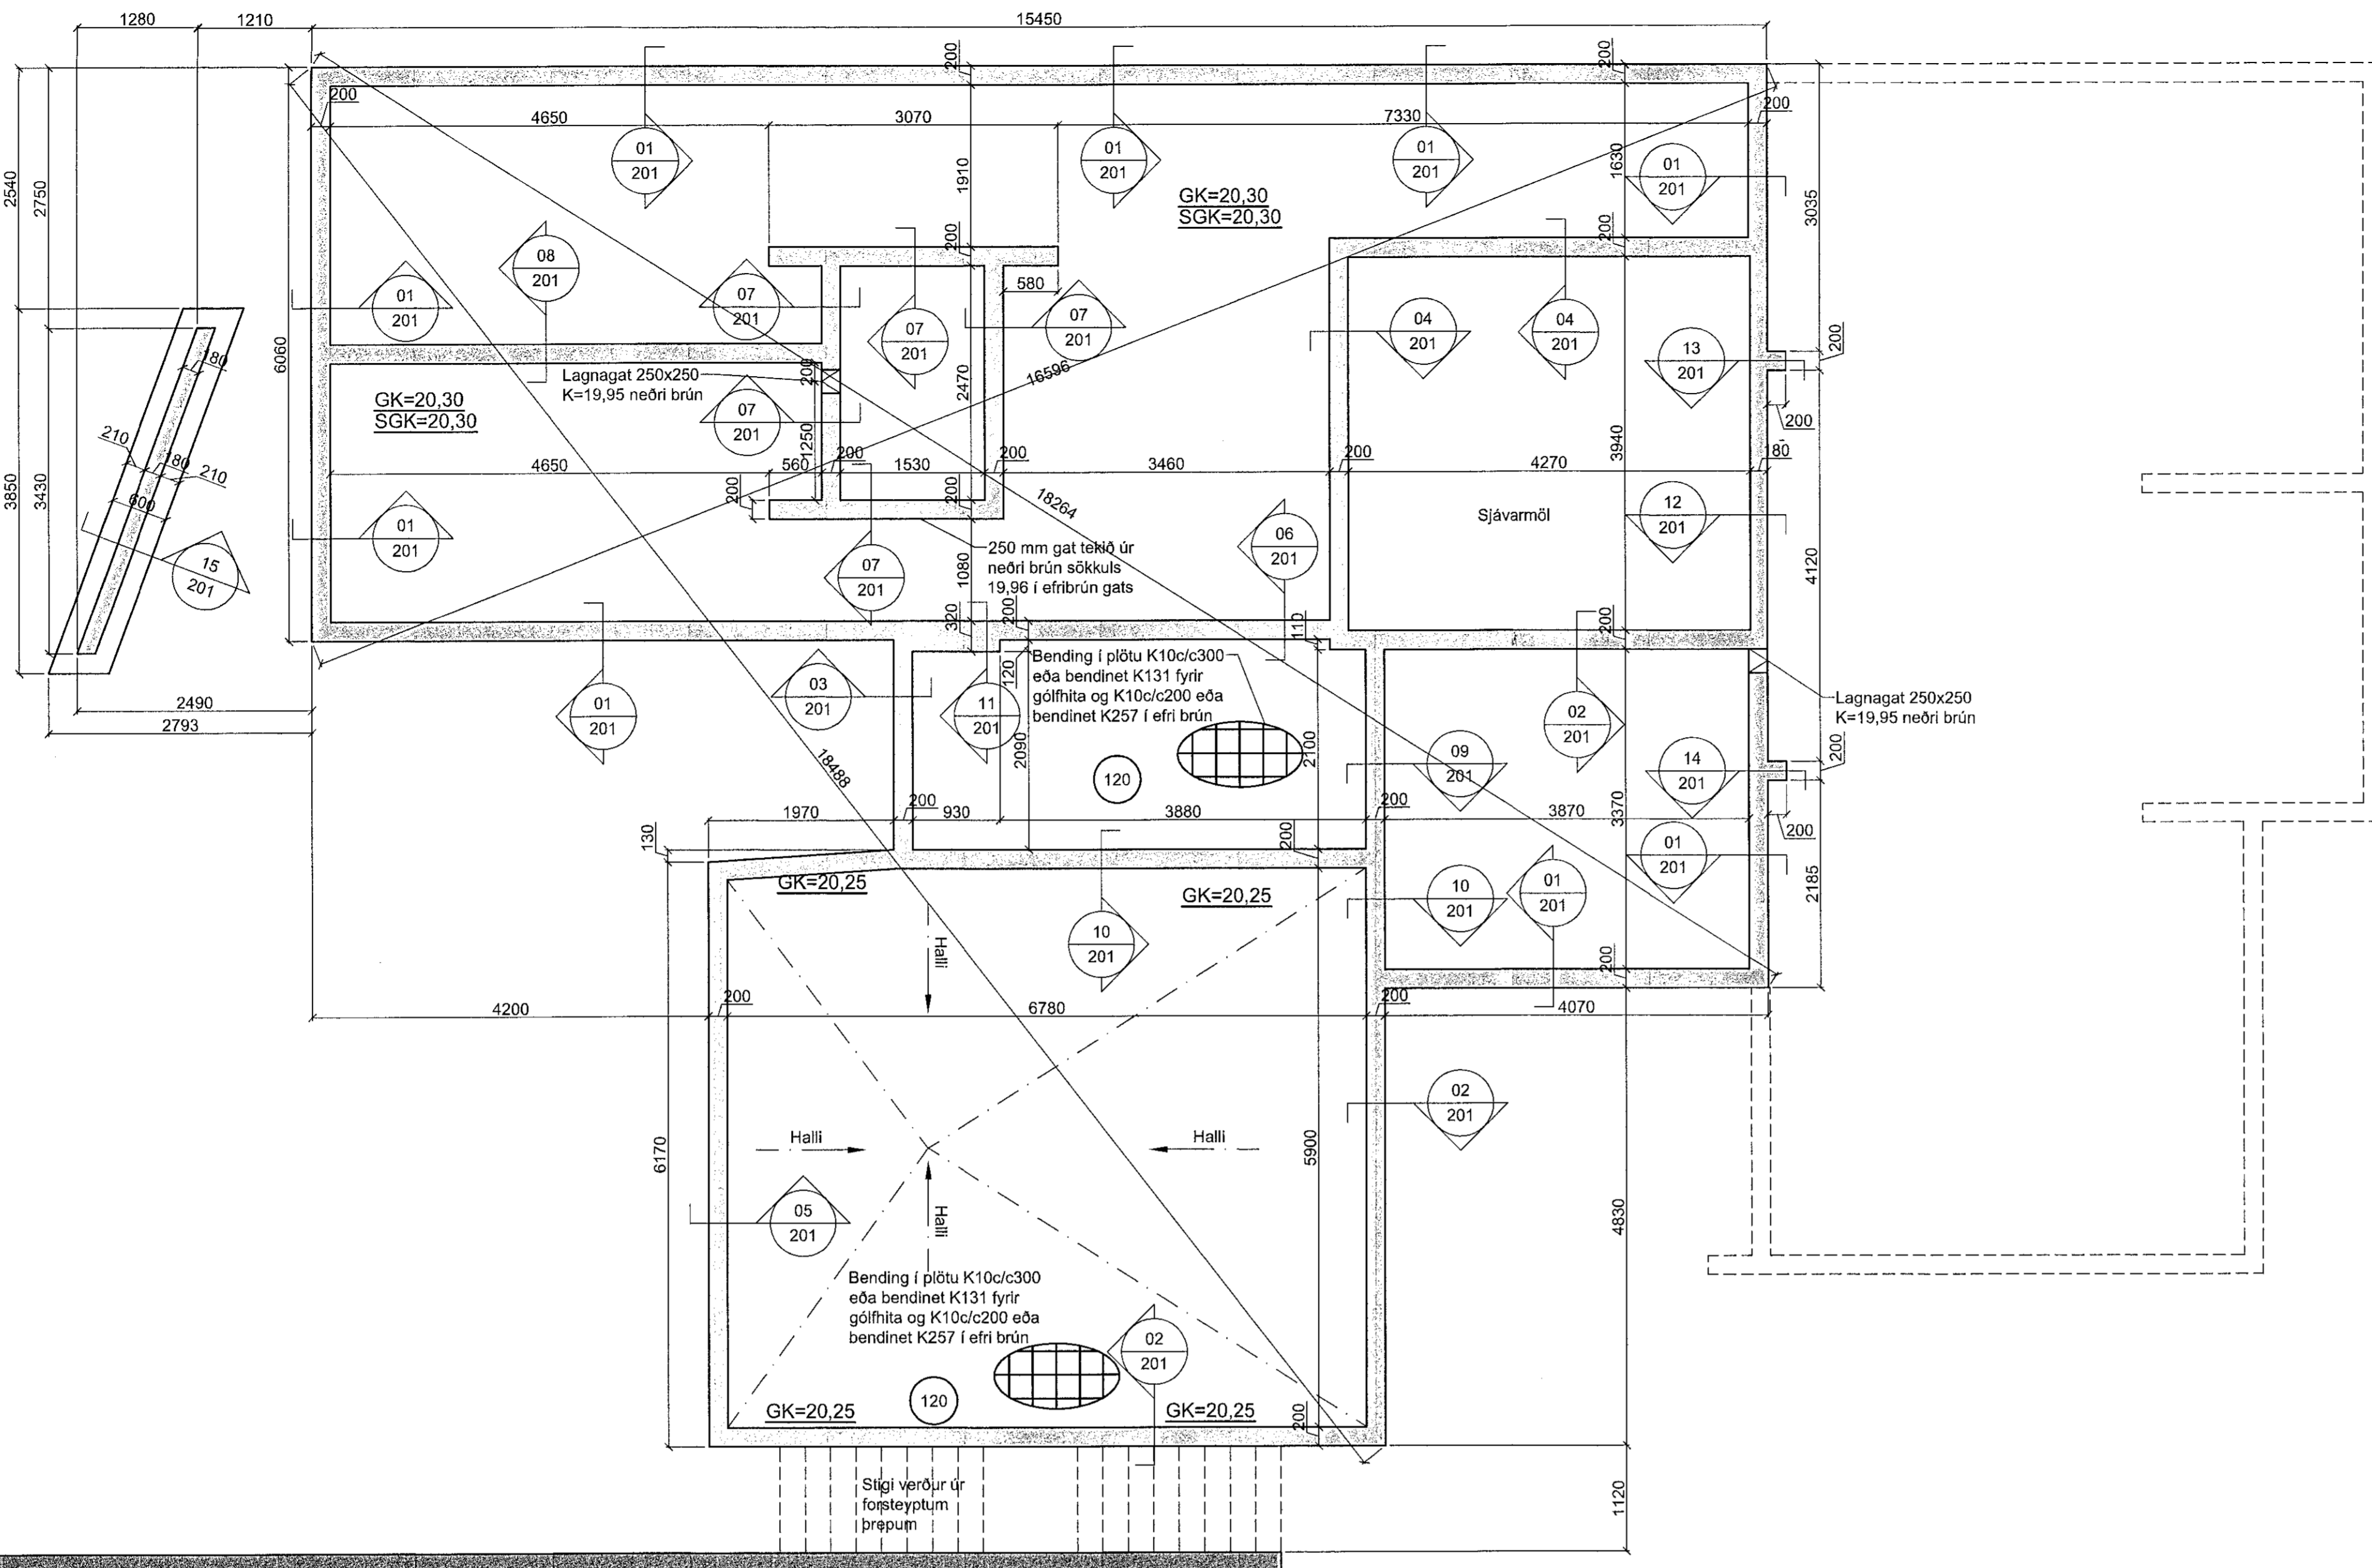


Grunnmynd sökkla, 1:50

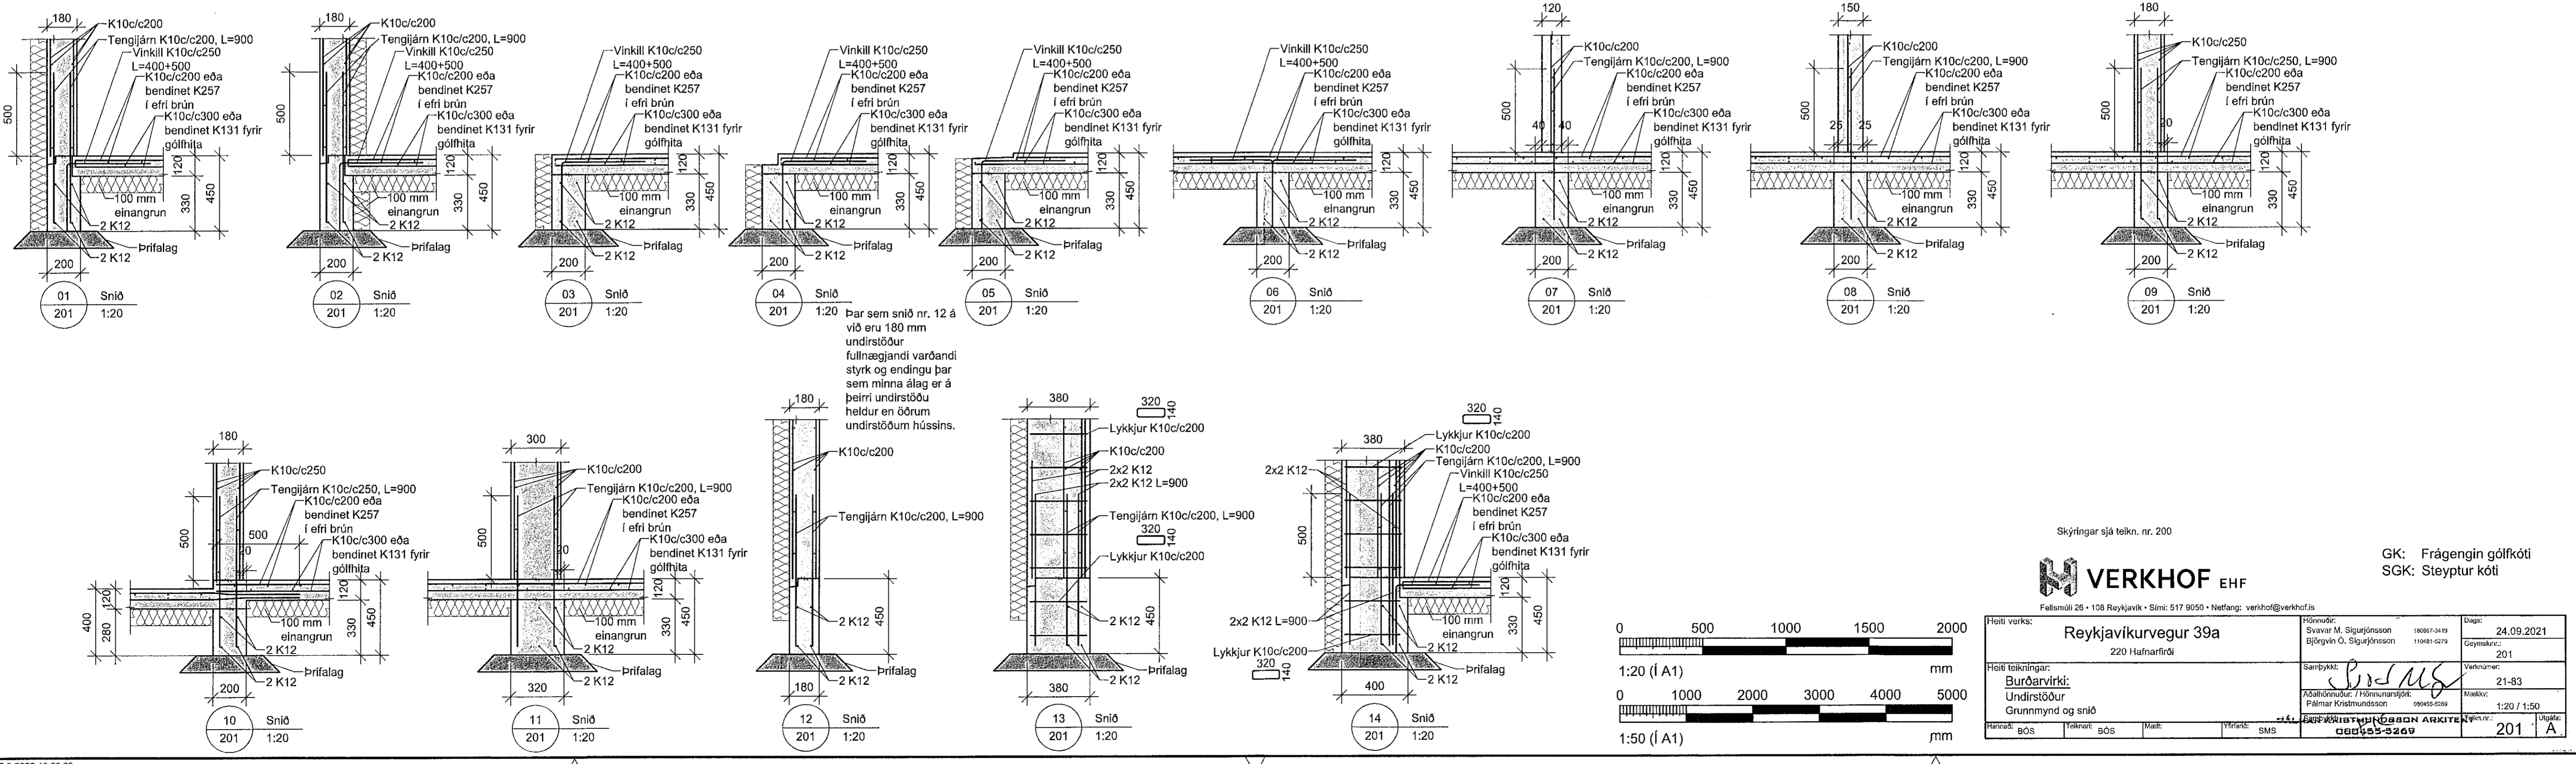

Skýringar sjá teikn. nr. 200  
**VERKHOF EHF**

GK: Frágengin gölfkoti  
SGK: Steypur koti

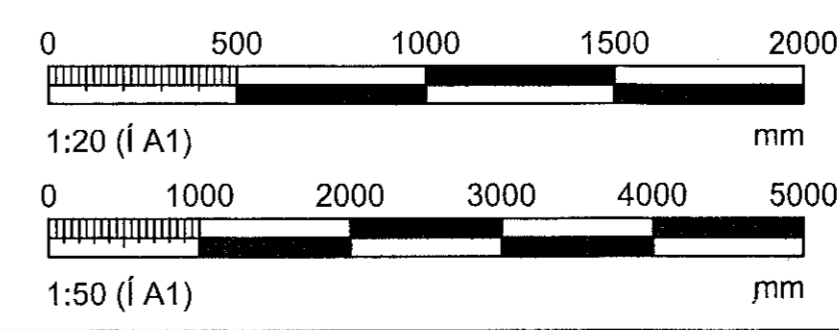

Stað: Reykjavík	Stími: 517 9050	Nefnd: verkhof@verkhof.is	Dagur: 24.09.2021
220 Hafnarfjörð			Geymslunúmer: 201
