



Samþykkt þann  
12. ágúst 2022  
Byggingafultrúinn í Hafnarfirði

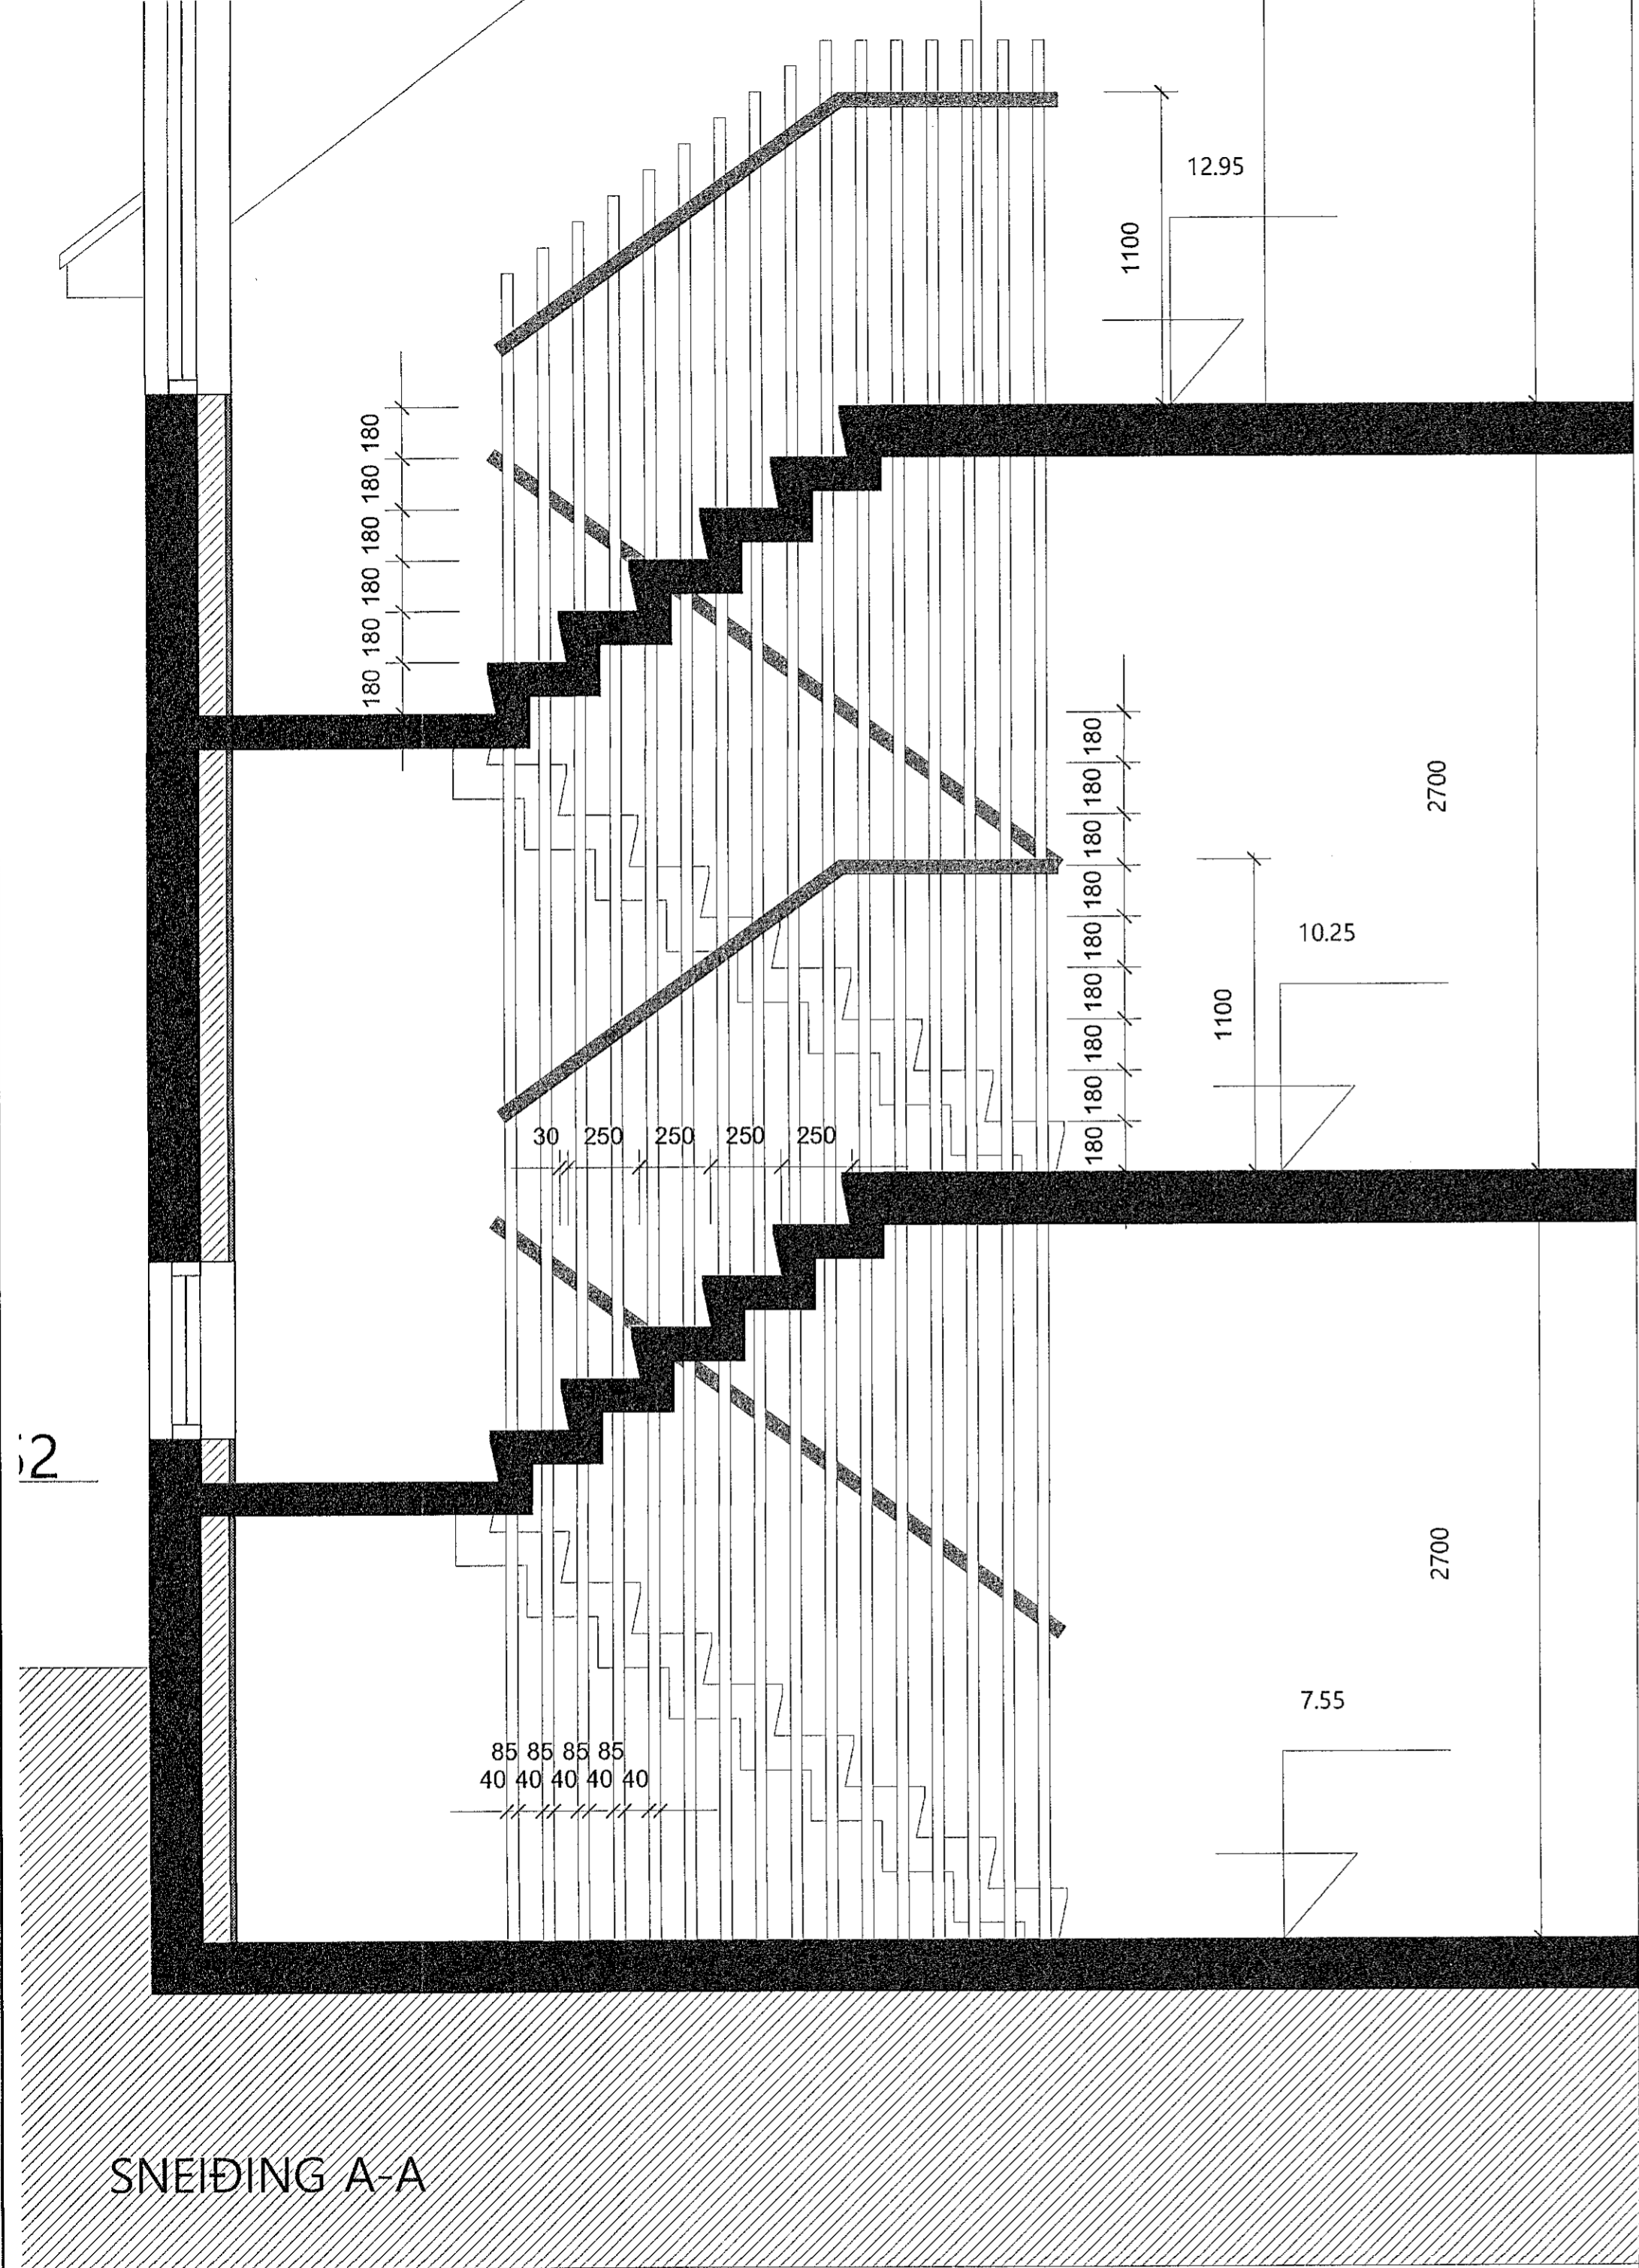


SNEIÐING A-A

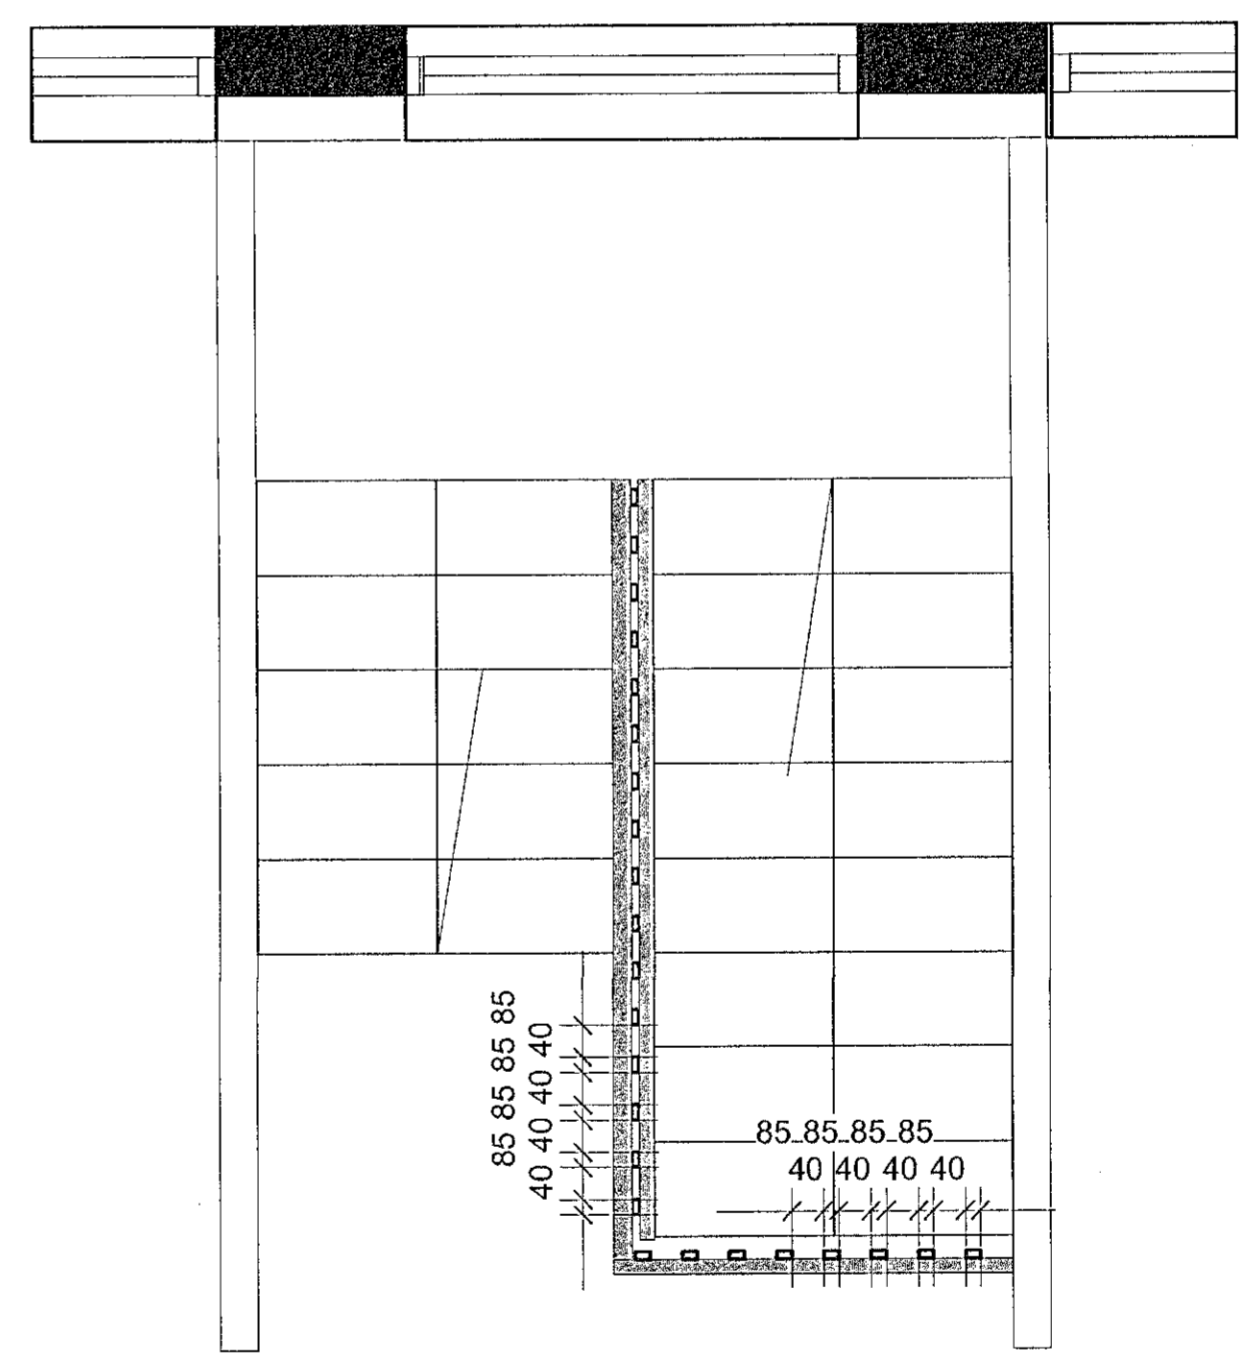

GRUNNMYND-EFSTA HLAUP

VERK	
AUSTURGATA 36 REYNDARTEIKNINGAR	
TEIKNING	
STIGADEILI	
VERKKAUPI	
INGVAR ARASON	
MÆLIKVARÐI: 1:20(m.v. A2)	TEIKNING NR:
DAGSETNING: 8.8.2022	TEIKNAD: GÓJ

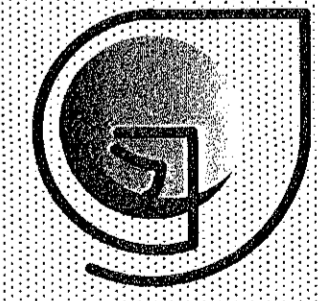

GUNNLAUGUR Ó. JOHNSON  
arkitekt faf  
ARBÖT 270 MOSFELLSBÆ  
KT 080657 7819  
S 864 2625  
E goj@centrum.is