
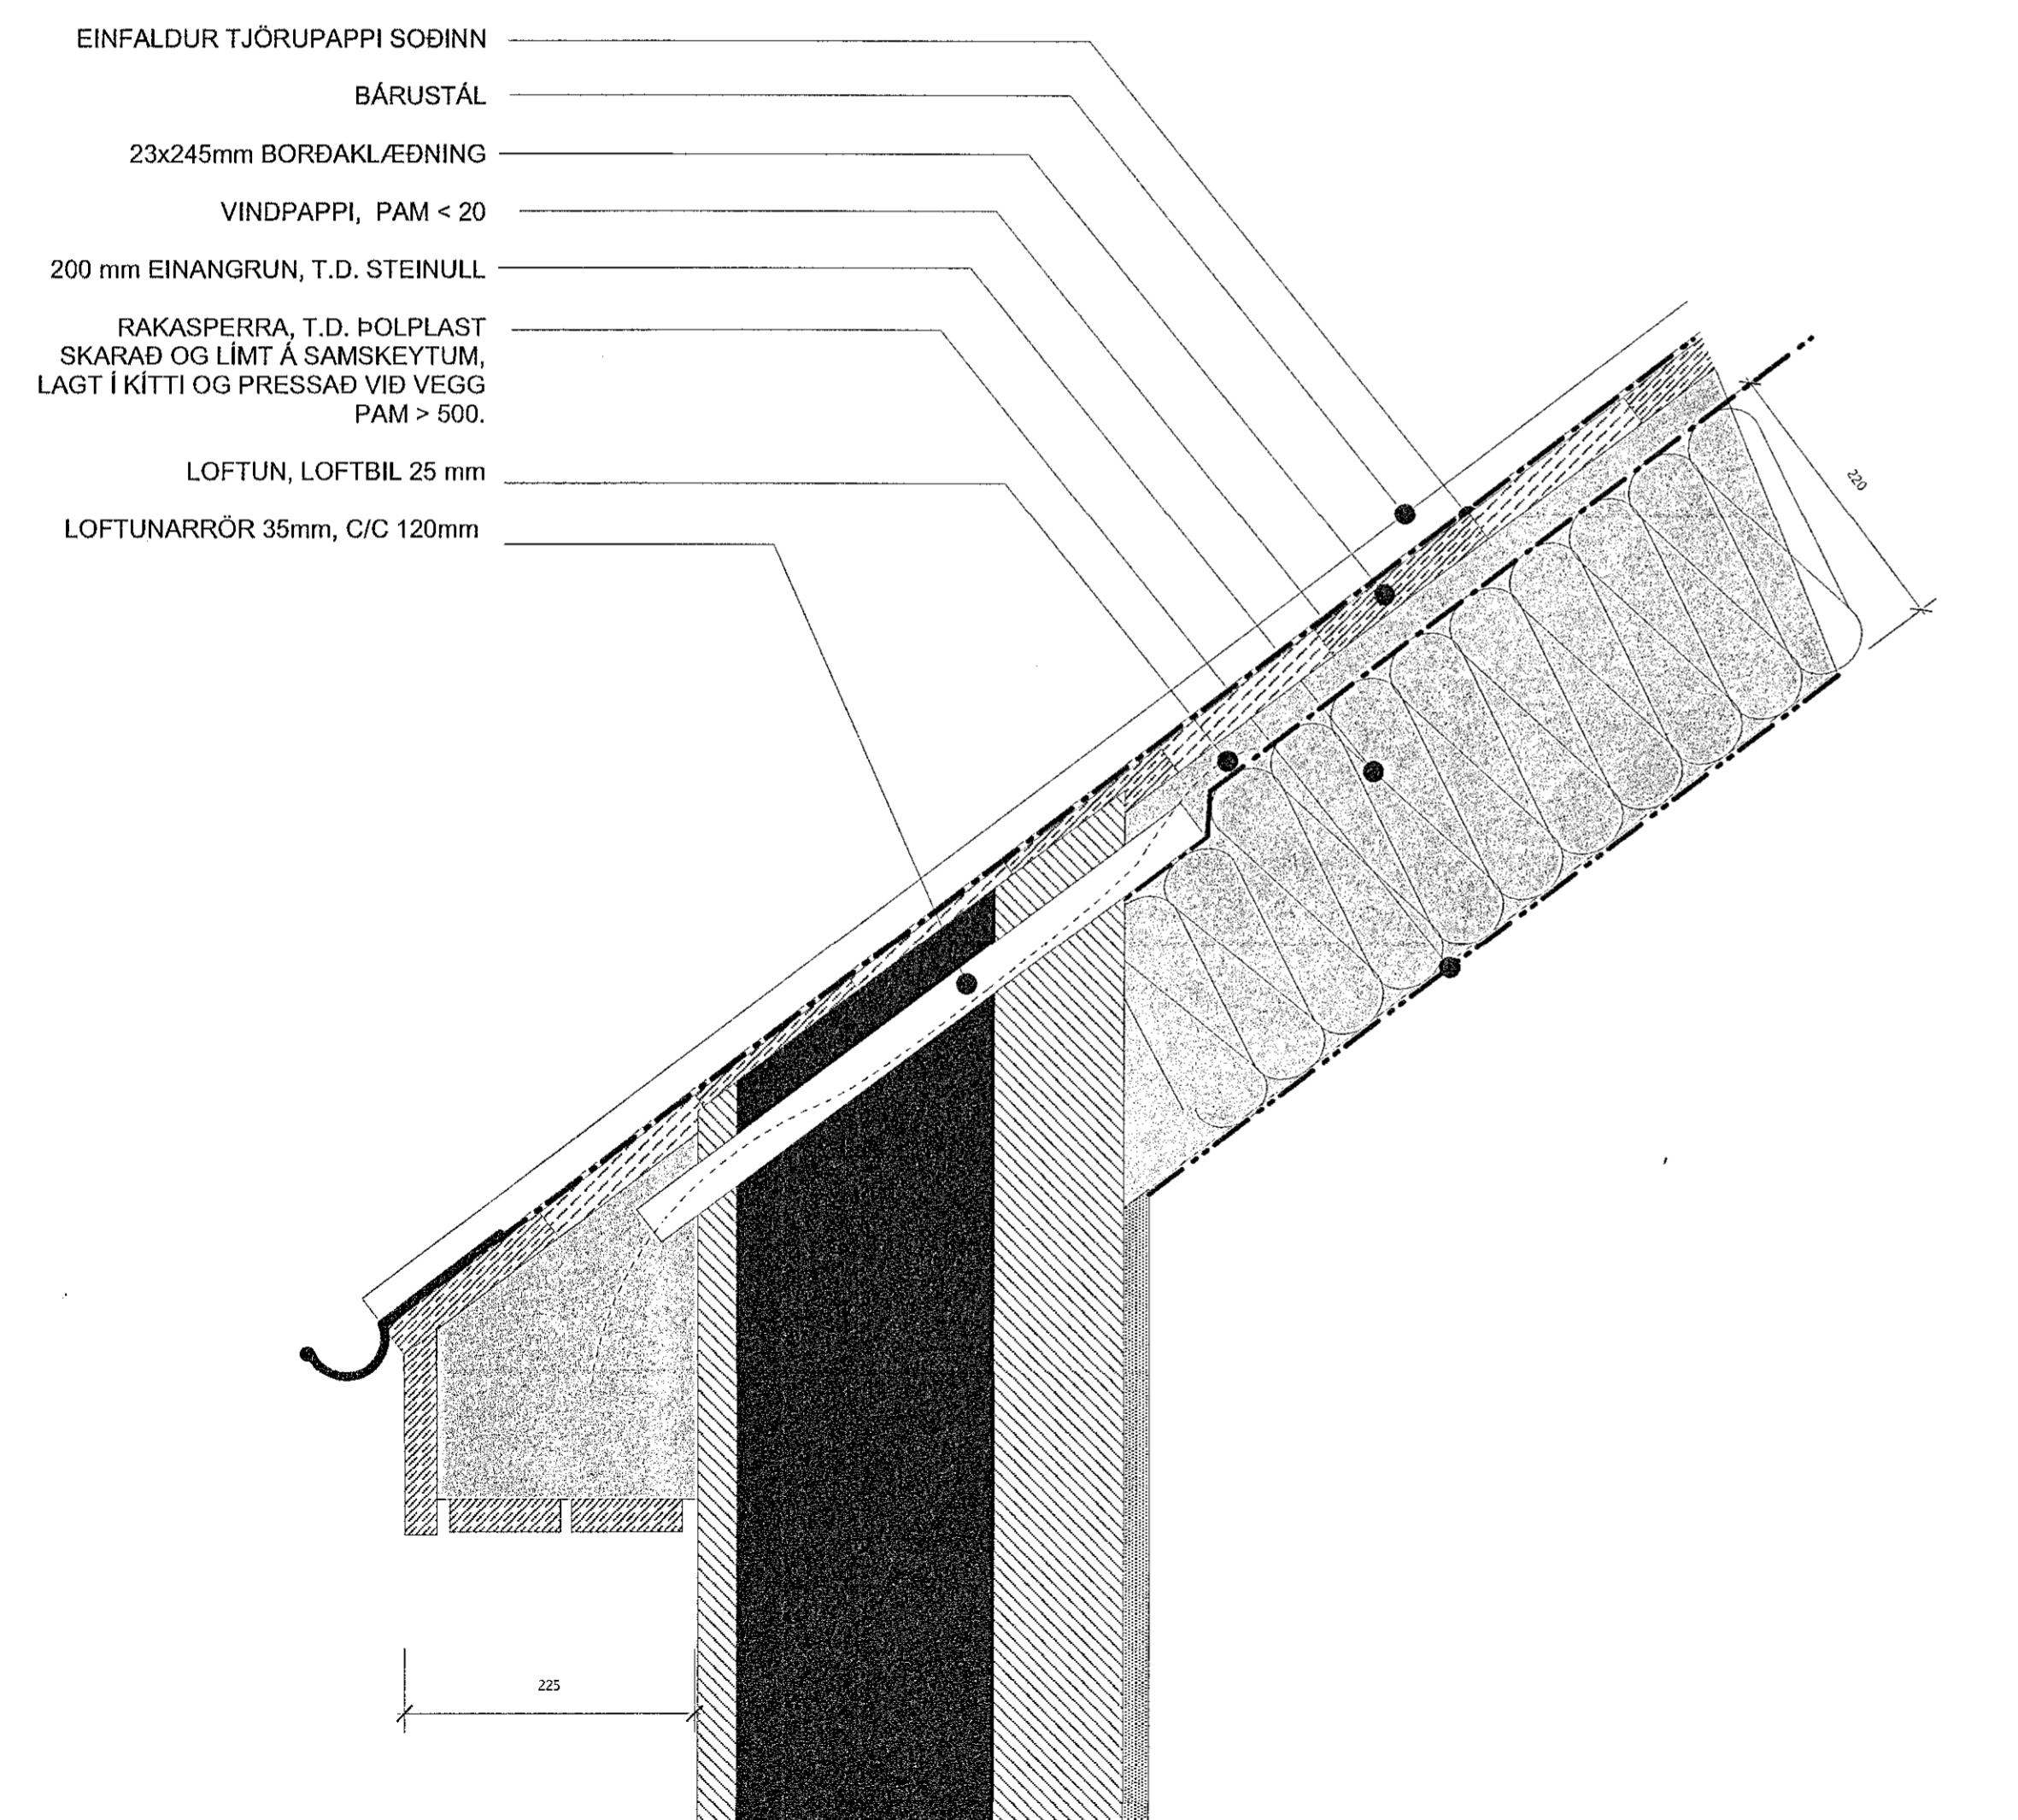


Samþykkt þann  
12. ágúst 2022  
Byggingafultrúinn í Hafnarfirði

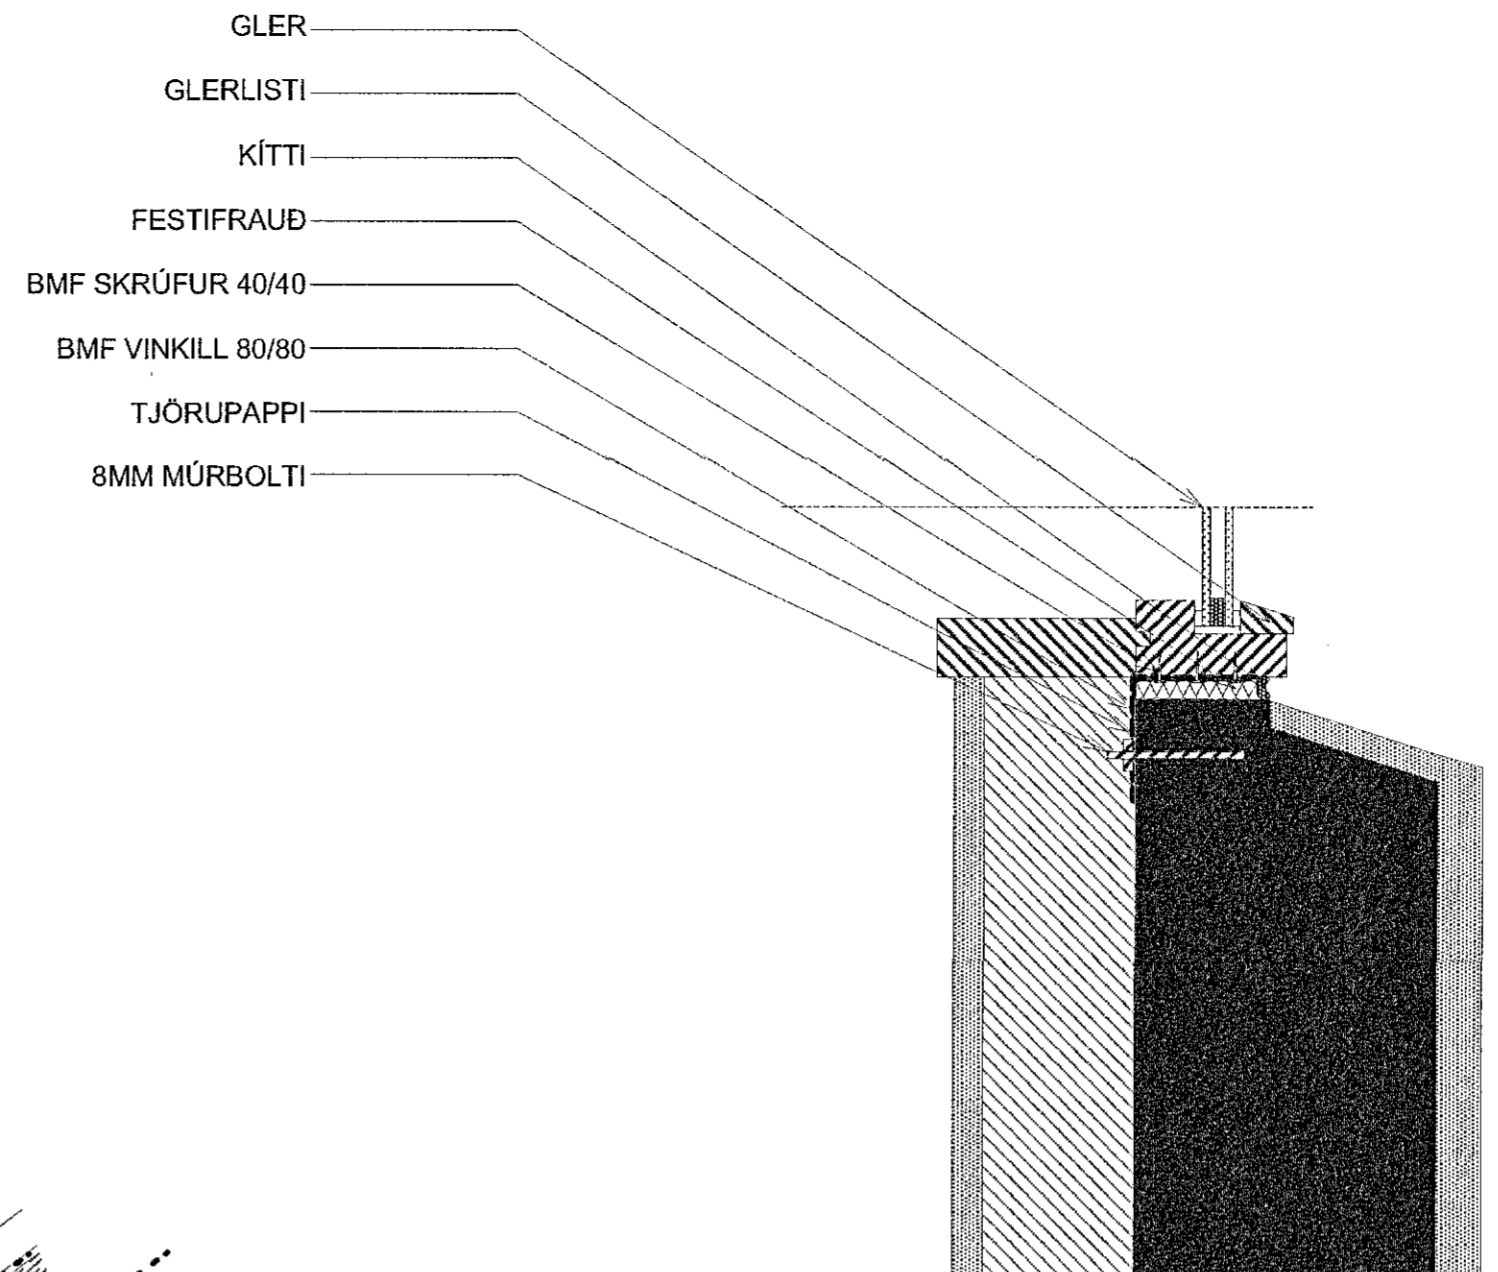


VERK  
AUSTURGATA 36  
REYNDARTEIKNINGAR

TEIKNING  
ÞAKDEILI  
GLUGGADEILI

VERKKAUPI  
INGVAR ARASON

MÆLIKVARÐI: 1:5(m.v. A2)	TEIKNING NR:
DAGSETNING: 8.8.2022	TEIKNAD: GÓJ

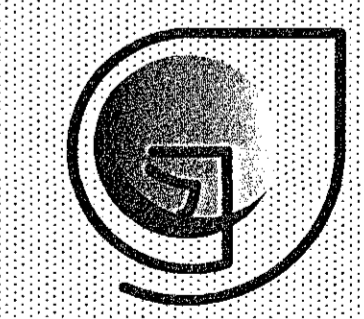

GUNNLAUGUR Ó. JOHNSON  
arkitekt / ai  
ÁRBOÐ 270 MOSFELLSBÆ  
KT. 0806577819  
S. 864 2625  
E. goj@centrum.is