




D-07- Lóðrétt
2.02-02

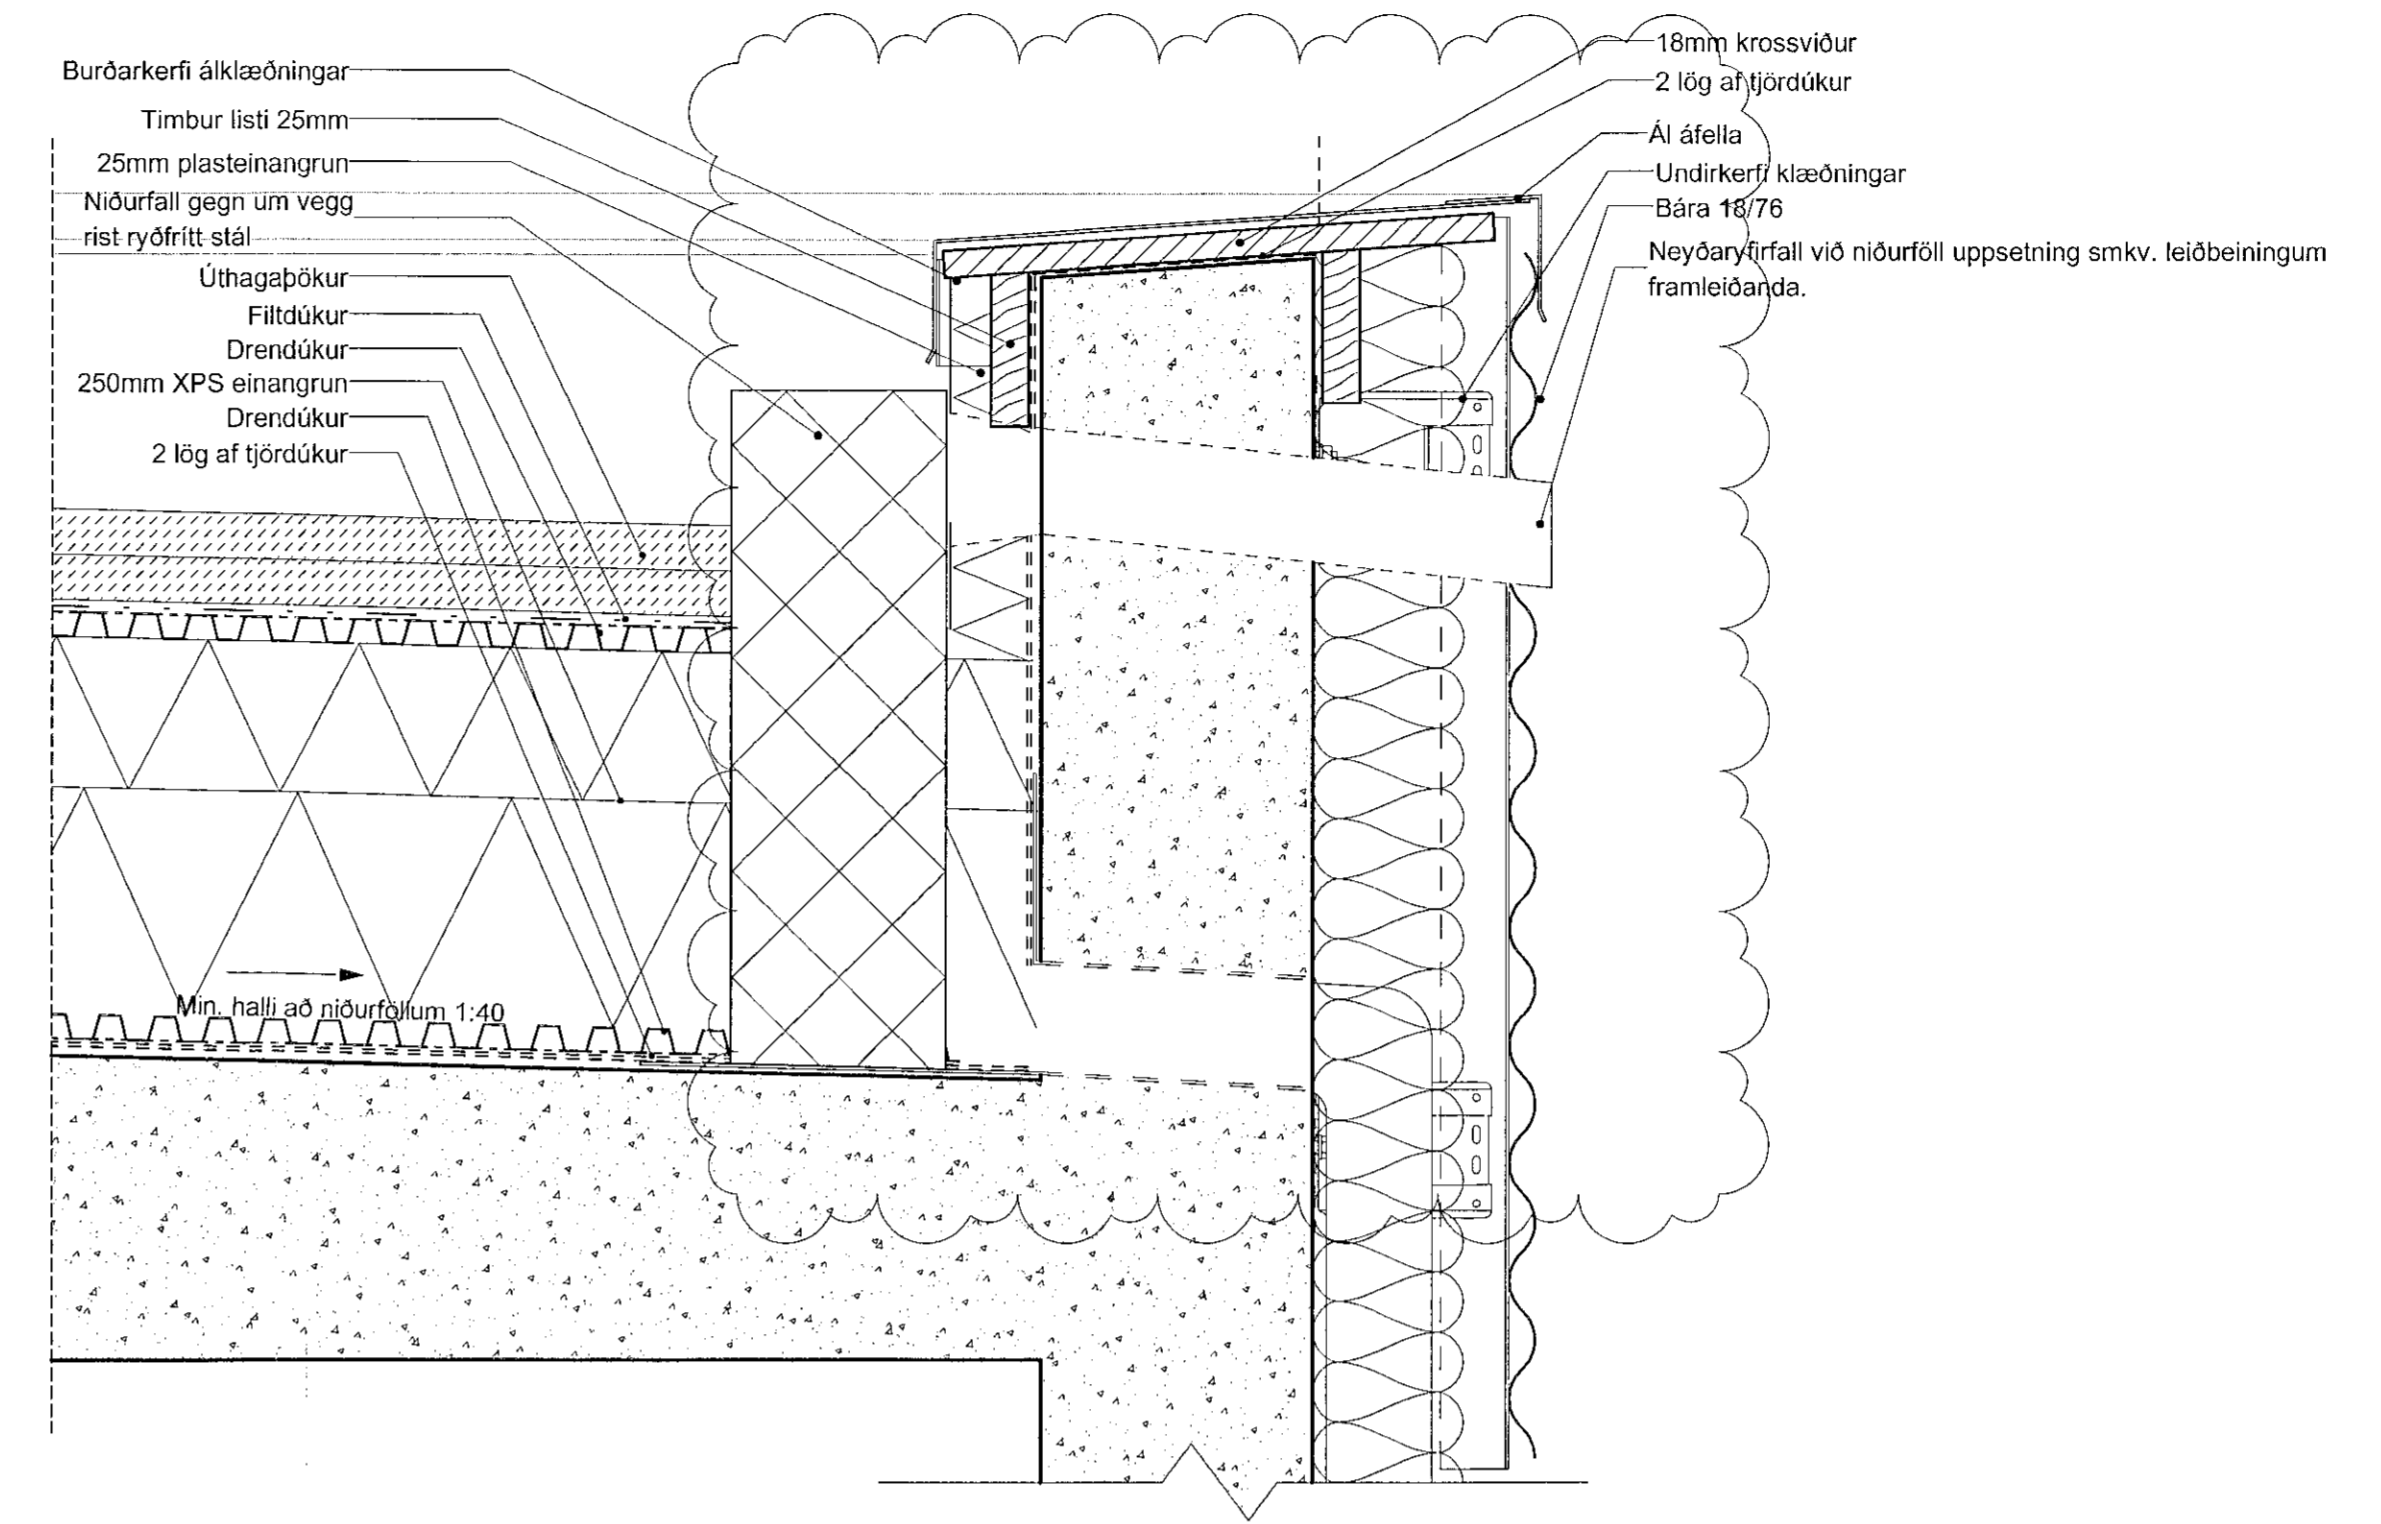

D-06- Lóðrétt
2.02-02

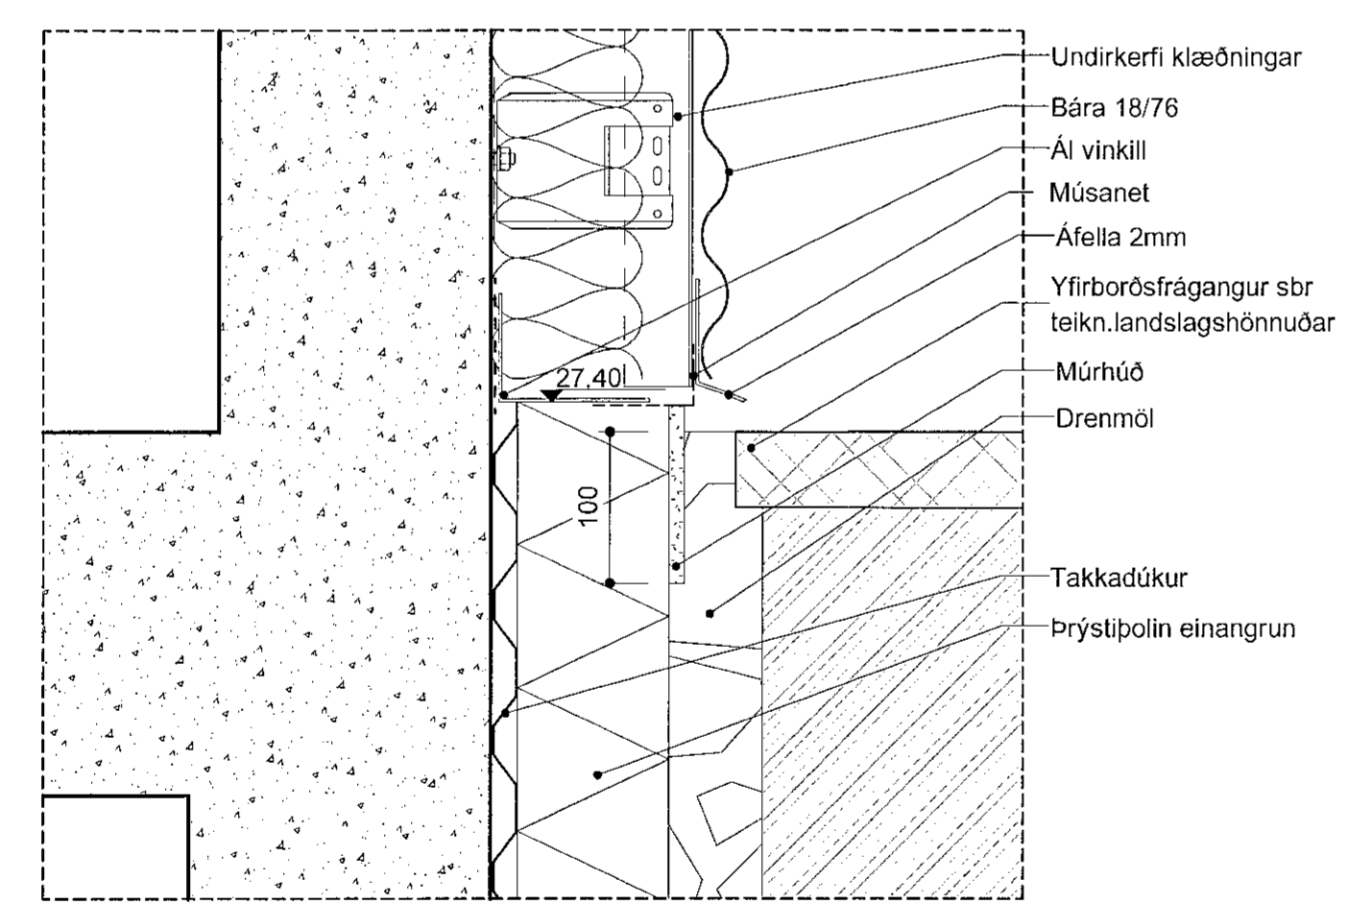

D-05- Lóðrétt
2.02-01

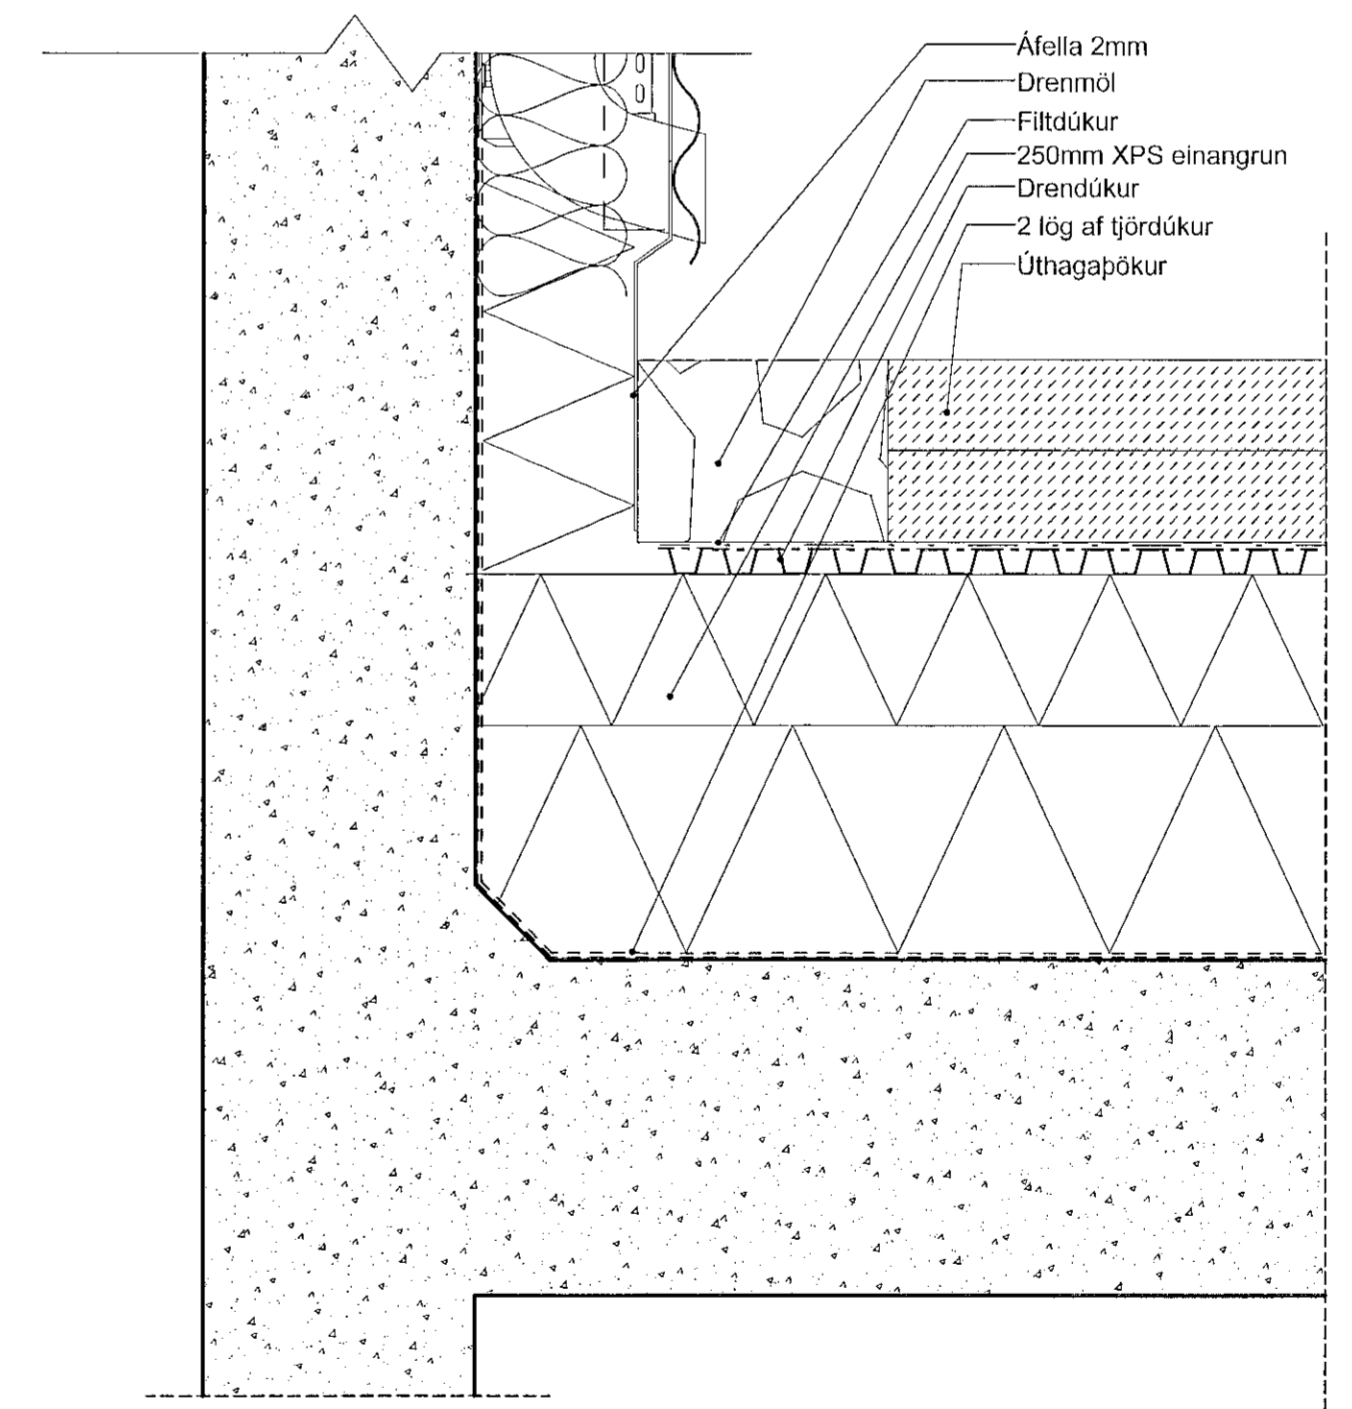

VERKTEIKNING GERD Á GRUNNI
ÁDALUPPDARÁTTA SEM VORU SAMÞYKKTIR ÞANN
22. JÚL 2021

B 14.03.2022 CL Uppfærsla
A 20.10.2021 HB Endurútféfið óbreytt
BREYTINGAR



VERKHEIT:
**Nónhamar 1-3, 221 Hafnarfj.,
Fjölbýlishús, mhl.02**
Verkeikningar

VERK
Deili utanhúss 2

MÁL: 1 : 5
HÁNNAB: AA
VPRFRARB: ISC
VERKINGNÖMUR: 753-16

DAGS: 30.06.2021
TEIKNAB: HI
TEIKNINGANÖMUR: 04
FL: 2.06-02
GTC: B

SAMT. ÁSGEIR ÁSGEIRSSON / ALEXANDER MAA SAMARK KL 060151-5429

Öll árit og gildi teikninga, að hluta eða heild, er háð samþykktir höfundar, skv. ákvæðum höfundalaga