
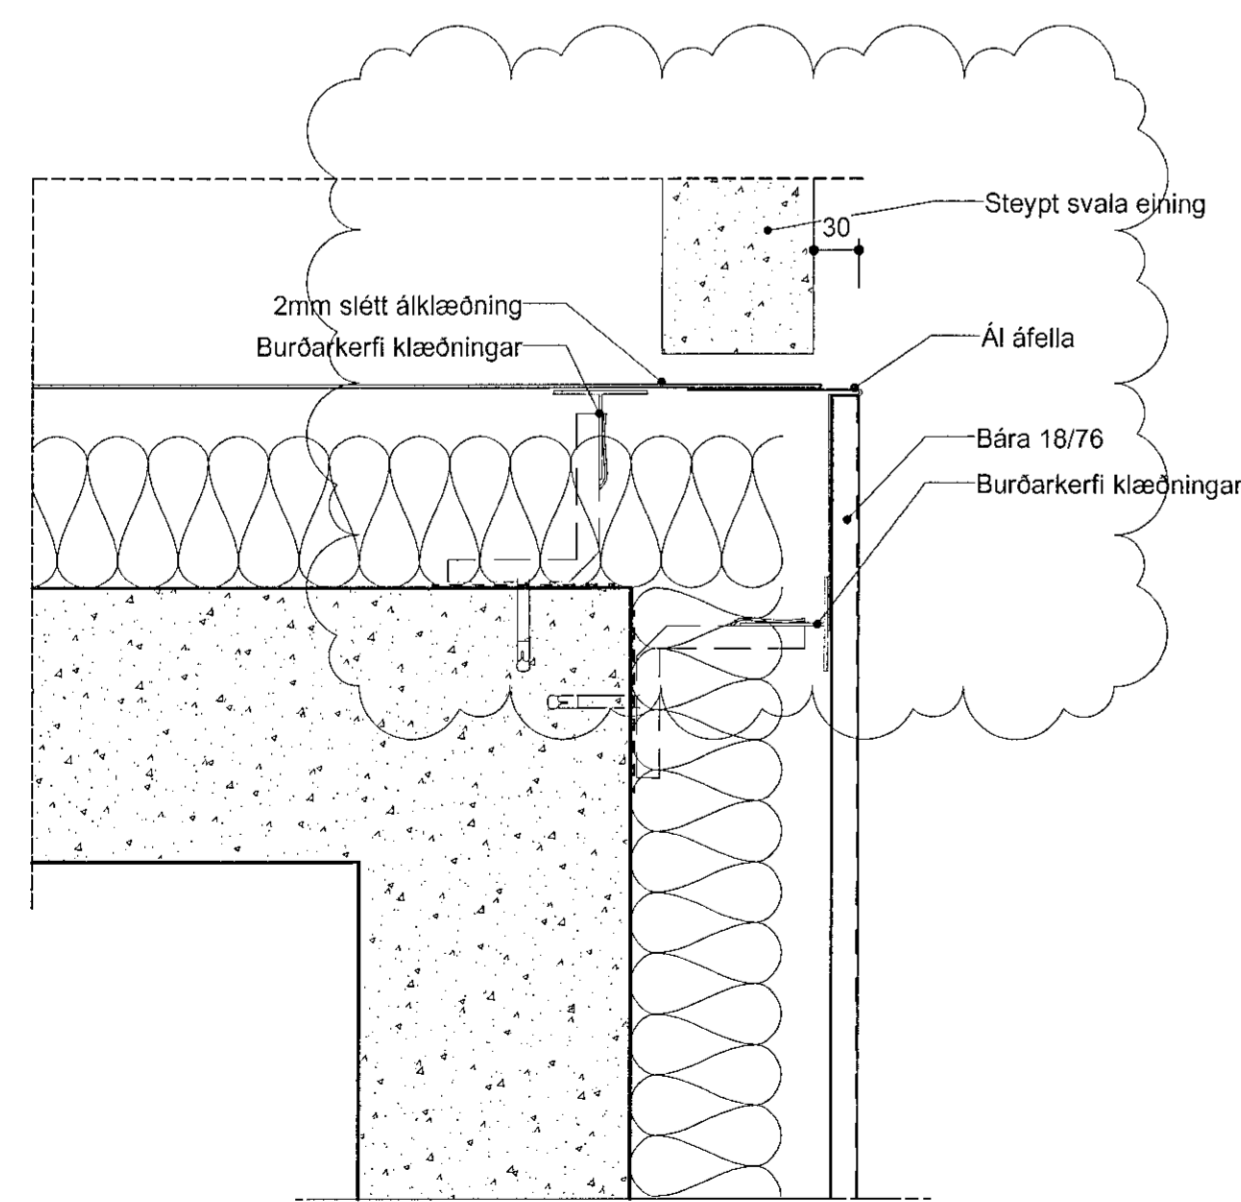


**D-09- Lóðrétt**  
2.02-01

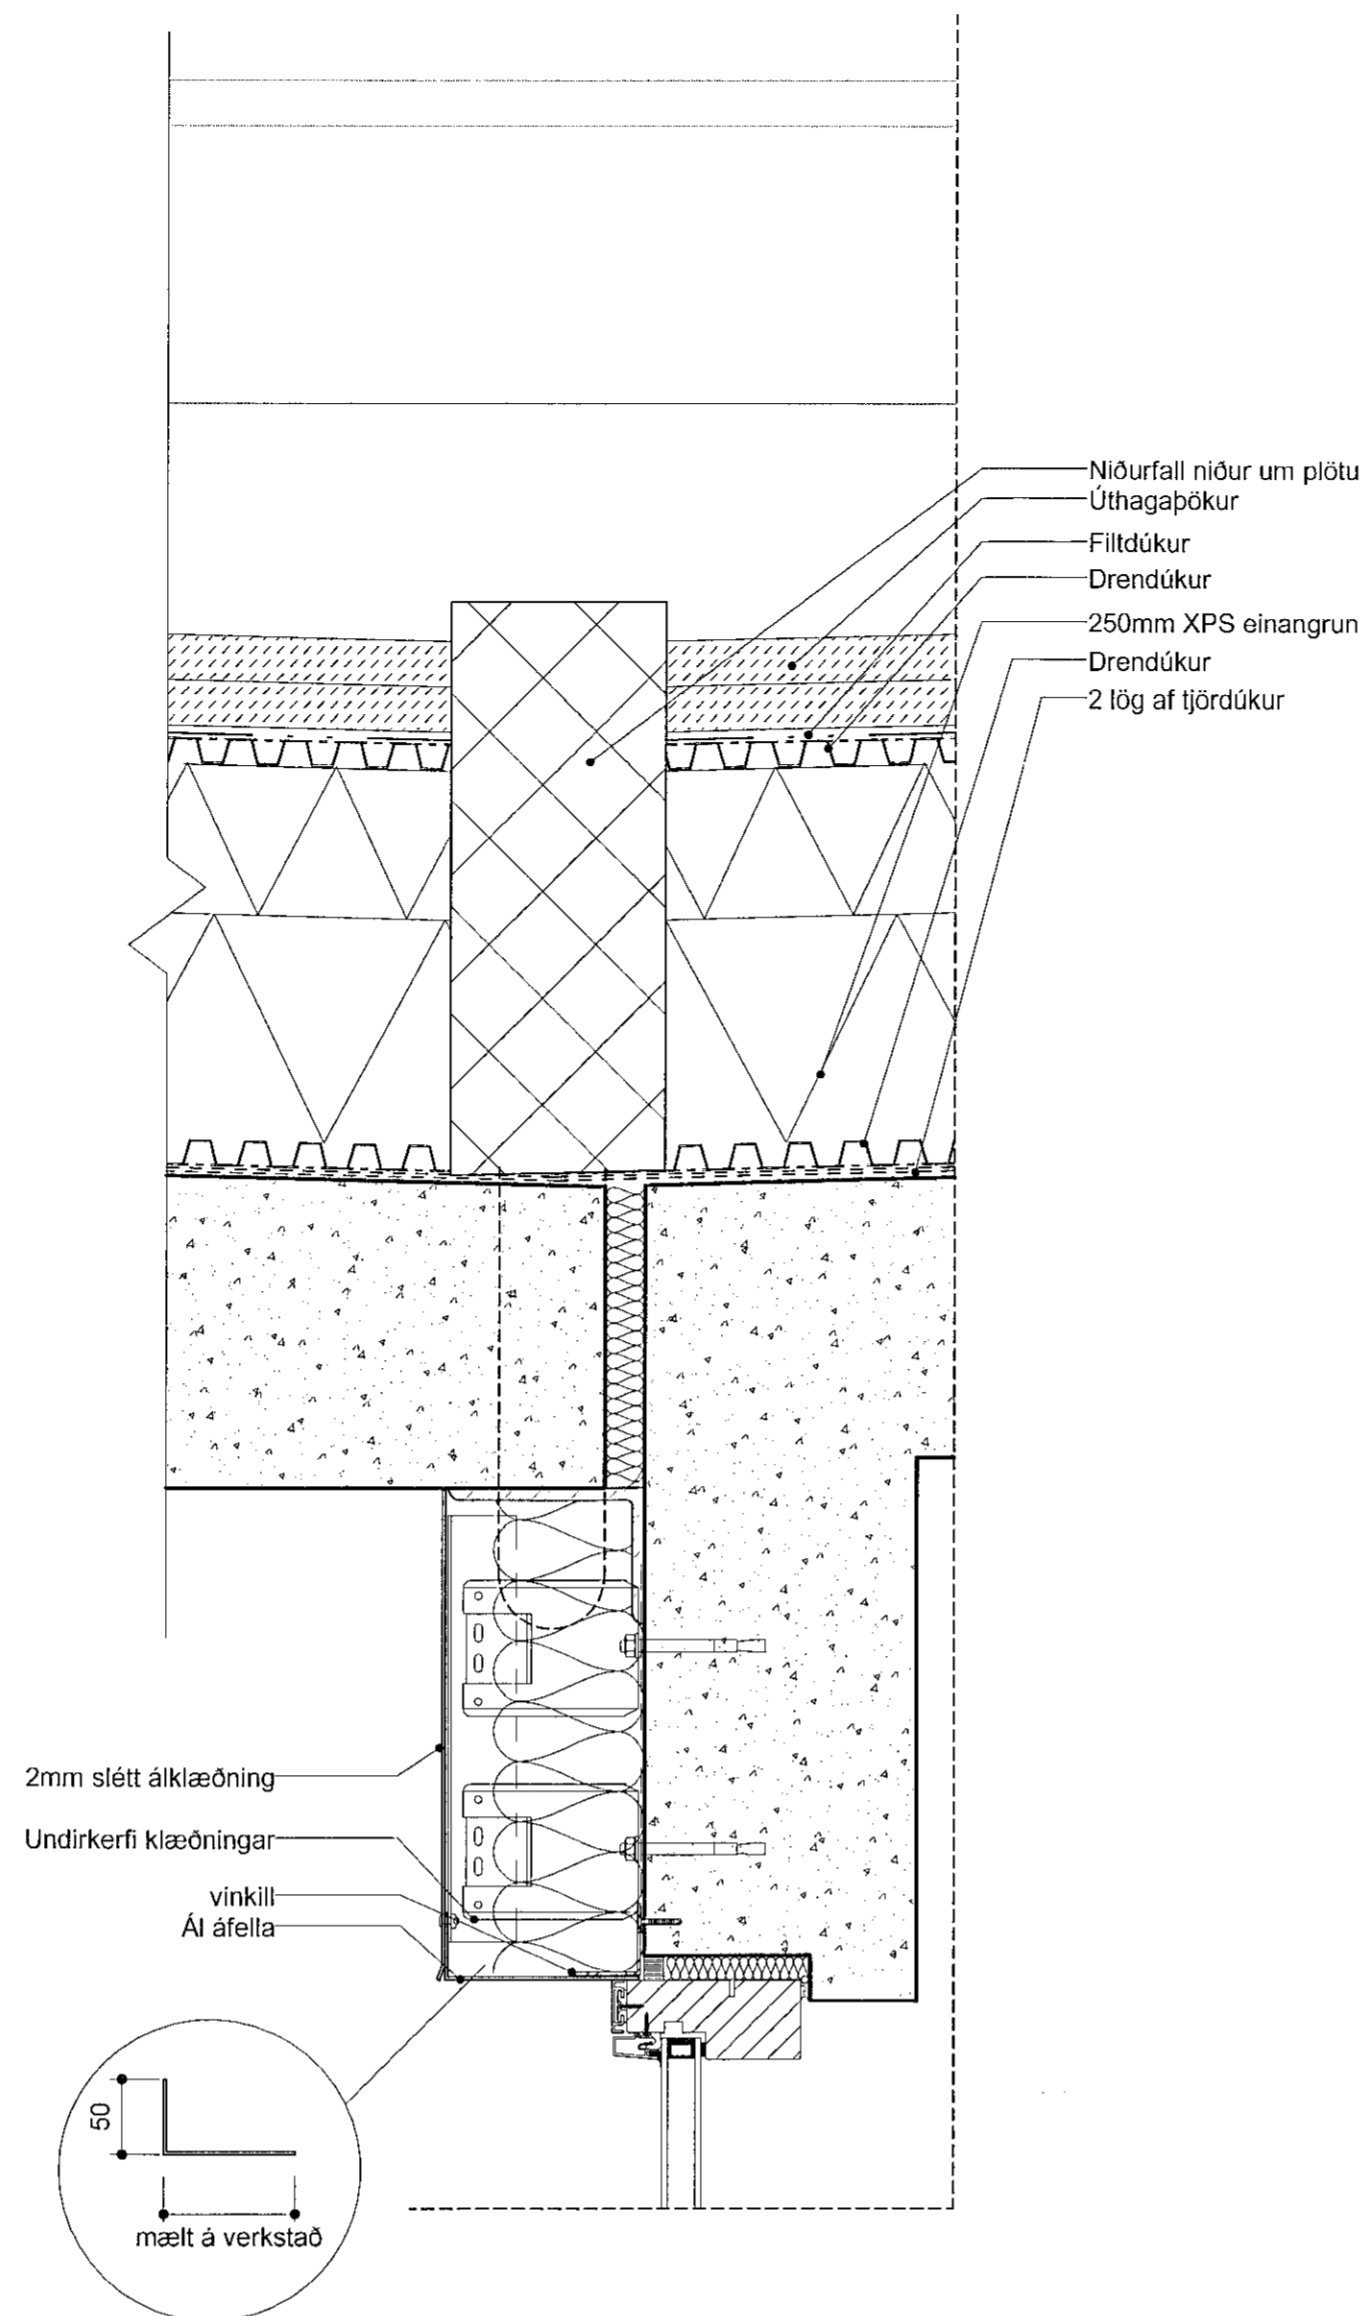


**D-25- Lárétt**  
2.03-01

VERKTEIKNING GERD Á GRUNNI  
AÐALUPPDRATTA SEM VORU SAMÞYKKTUR ÞANN  
22 JUL 2021

B 11.08.2022 IL Þakkantur steypur,  
Svalaveggur stytur  
A 20.10.2021 HB Endurútféið óbreytt

BREYTINGAR

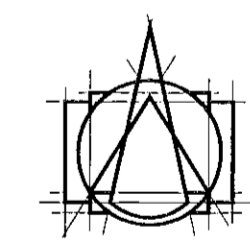

**T.ark**  
ARKITEKTAR  
HÁTÚNI 2B - 105 REYKJAVÍK  
SÍMI: 540 5700  
tark@tark.is - www.tark.is

VERKHEITI  
**Nónhamar 1-3, 221 Hafnarfj.**  
Fjölbýlishús, mhl.02  
Verkeiðningar

VERK  
**Deili utanhúss 3**

MÁL:  
1 : 5  
DAGS:  
30.06.2021  
HÁNNAD:  
ÁÁ  
TEIKNAD:  
HI  
YFIRFARIÐ:  
ISC

VERKNGMÉR FL. TEIKNINGANGMÉR ÖTG  
753-16 04 2.06-03 B

SAK. Ásgólf Ásgólfsson Arkitekt MAA SAMMÁRK KL.060161-5429