


Samþykkt þann
 25. ágúst 2022
 Byggingafulltrúinn í Hafnarfirði

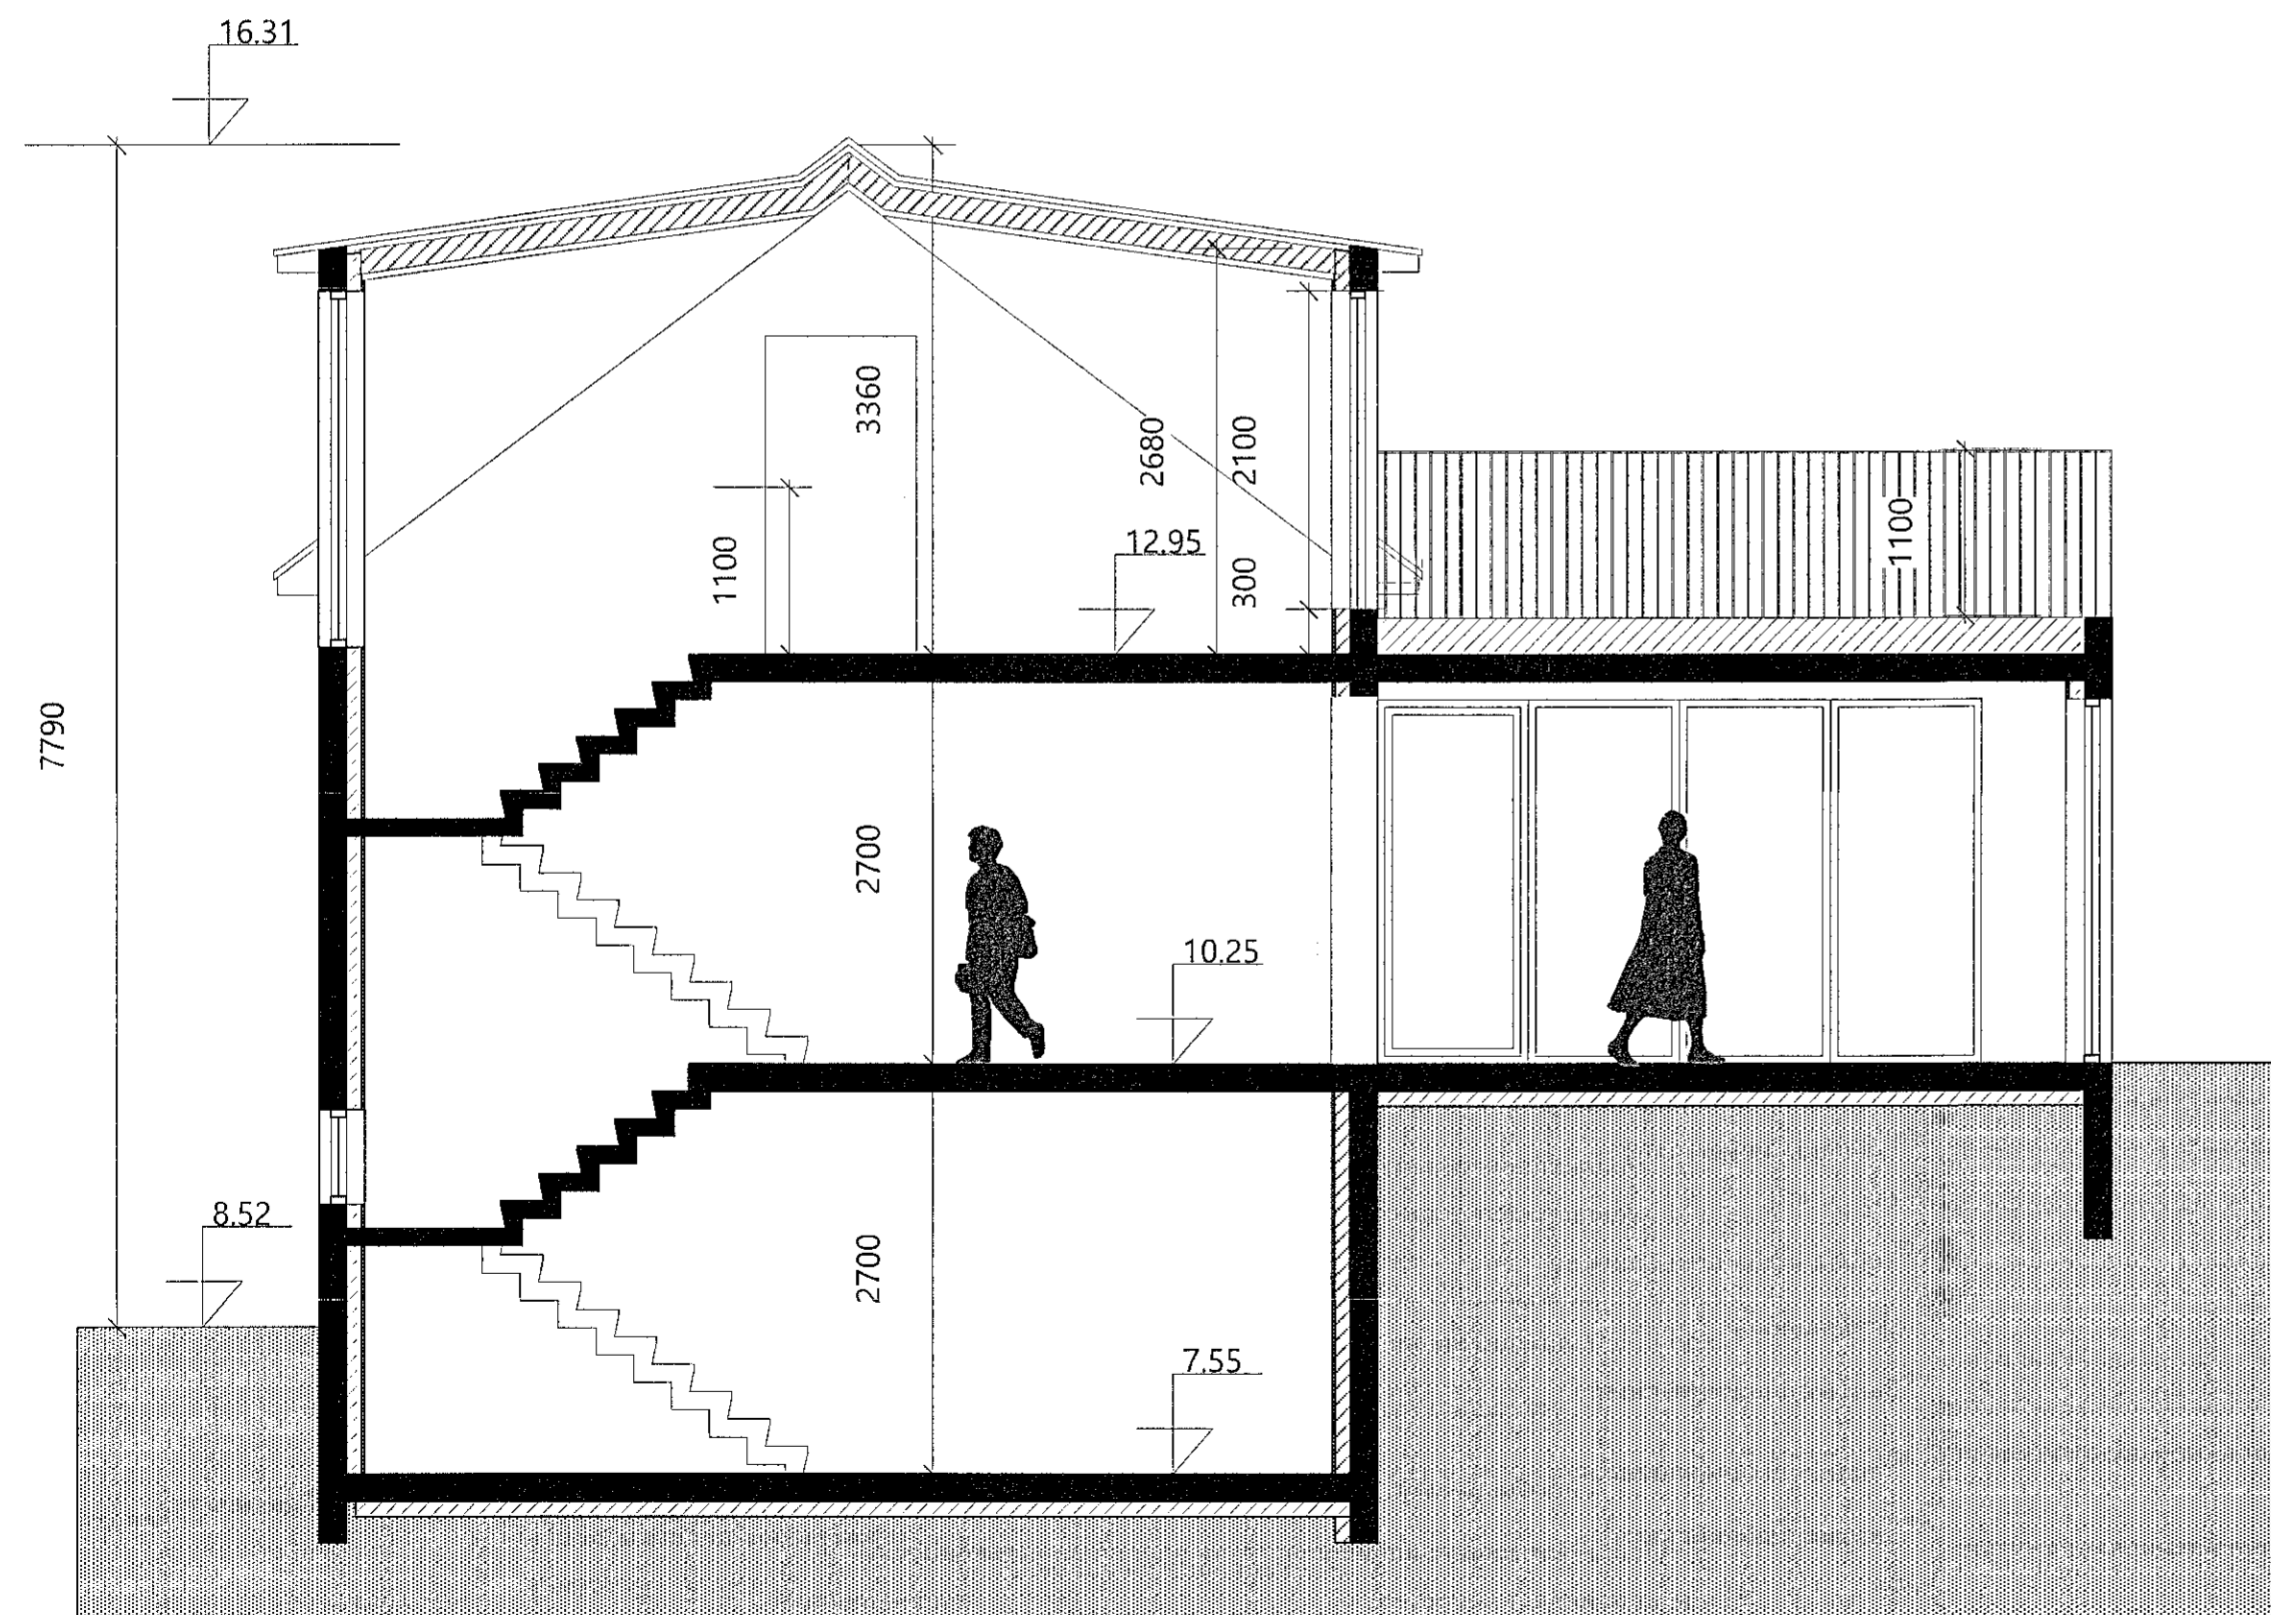

SNEIÐING A-A

VERK

AUSTURGATA 36
 REYNDARTEIKNINGAR

TEIKNING

SNEIÐING A-A

VERKKAUPI


INGVAR ARASON

MÆLIKVARÐI:
 1:50 (m.v. A2)

TEIKNING NR:

DAGSETNING:
 19.8.2022

TEIKNAD:
 GÓJ

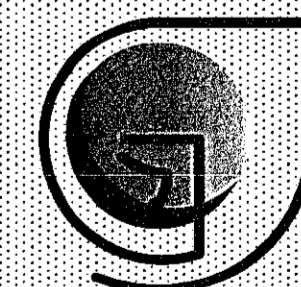

GUNNLAUGUR D. JOHNSON
 arkitekti faf
 ÁRBÓT 270 MOSFELLSBÆ
 KT 080657 7819
 S 864 2625
 E goj@centrum.is