






NORÐ-AUSTUR. M. 1:100.

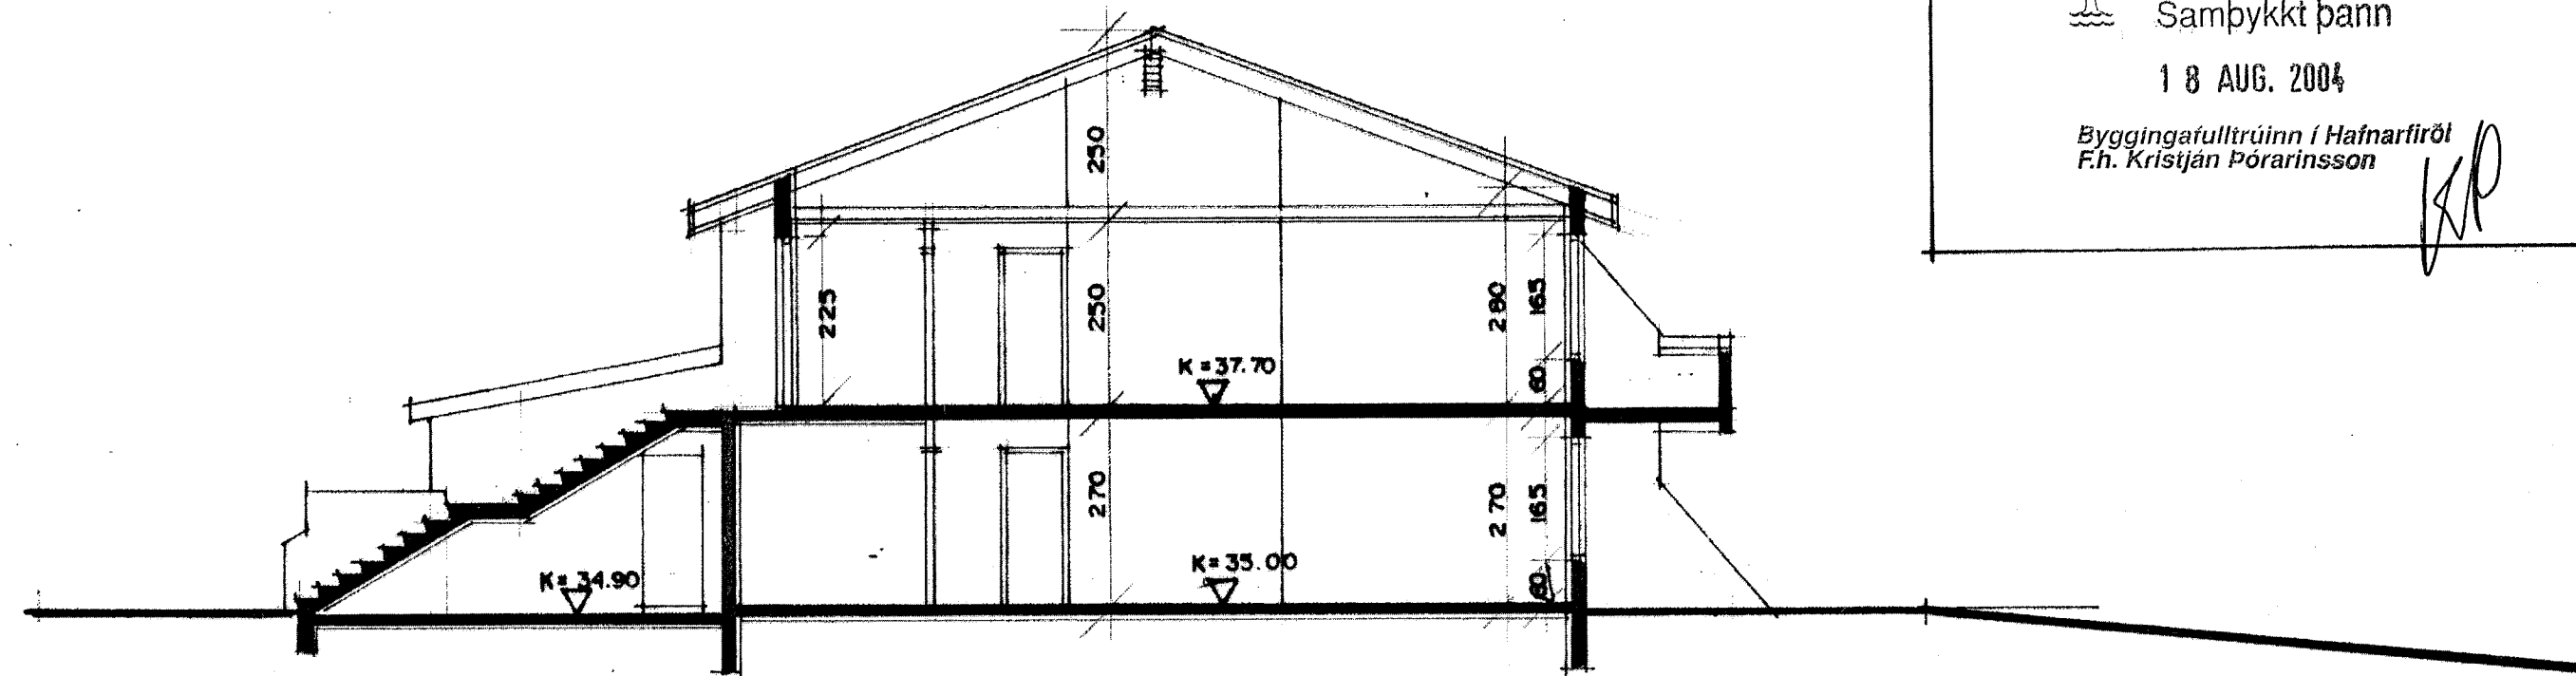


SNIÐ A-A M. 1:100

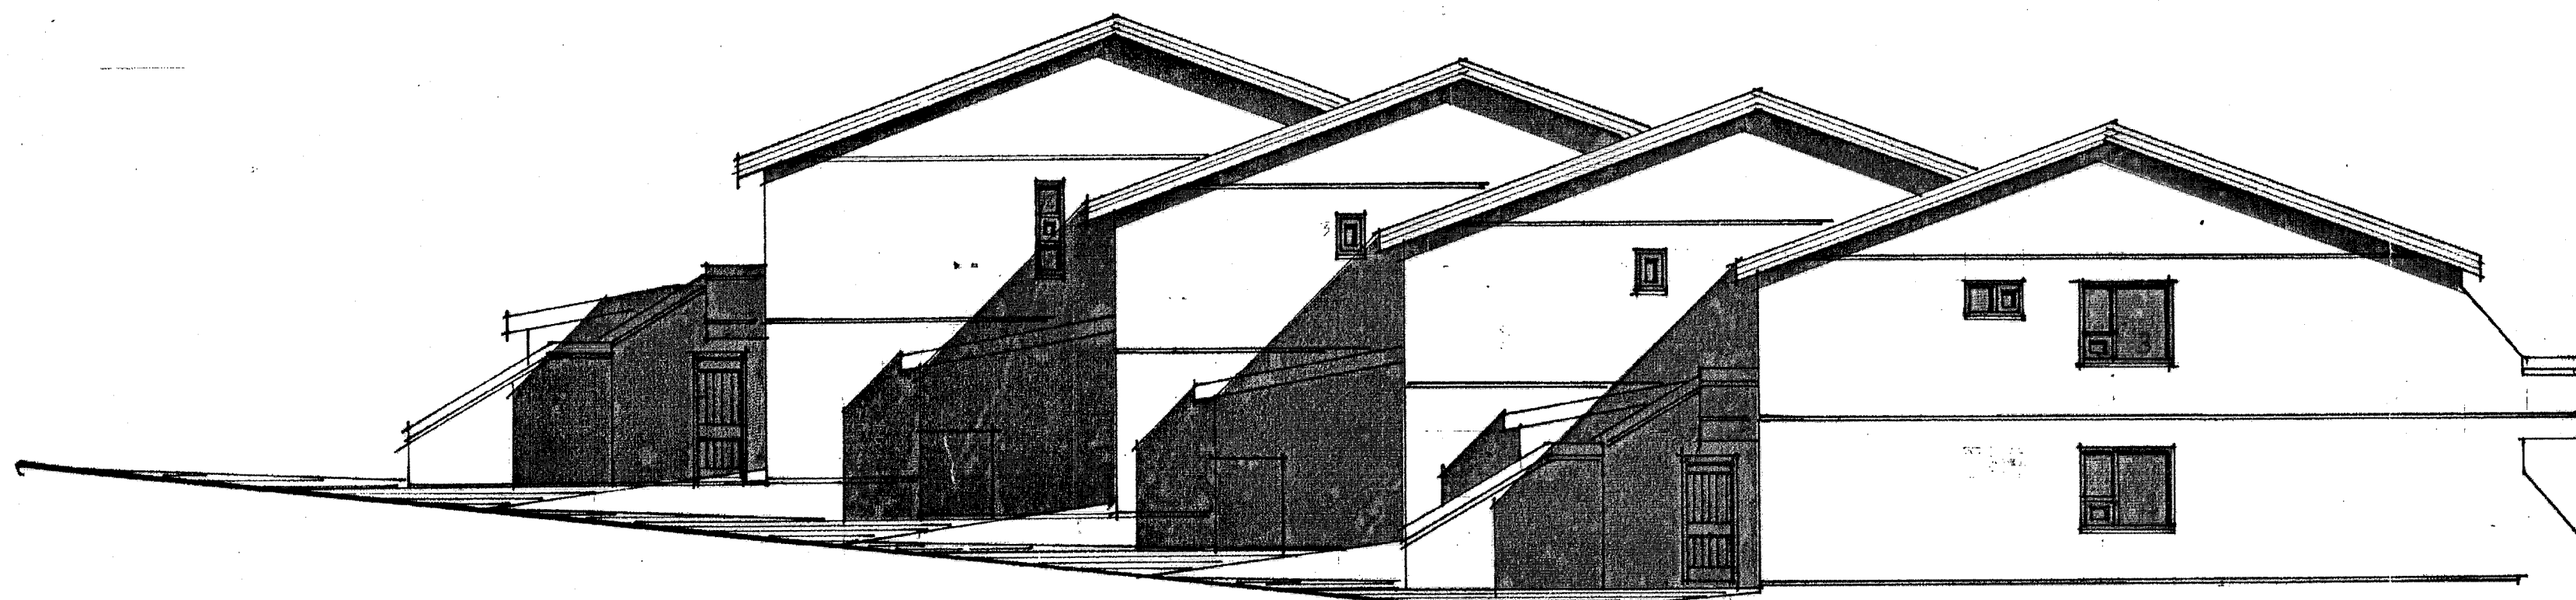


NORÐ-VESTUR M. 1:100

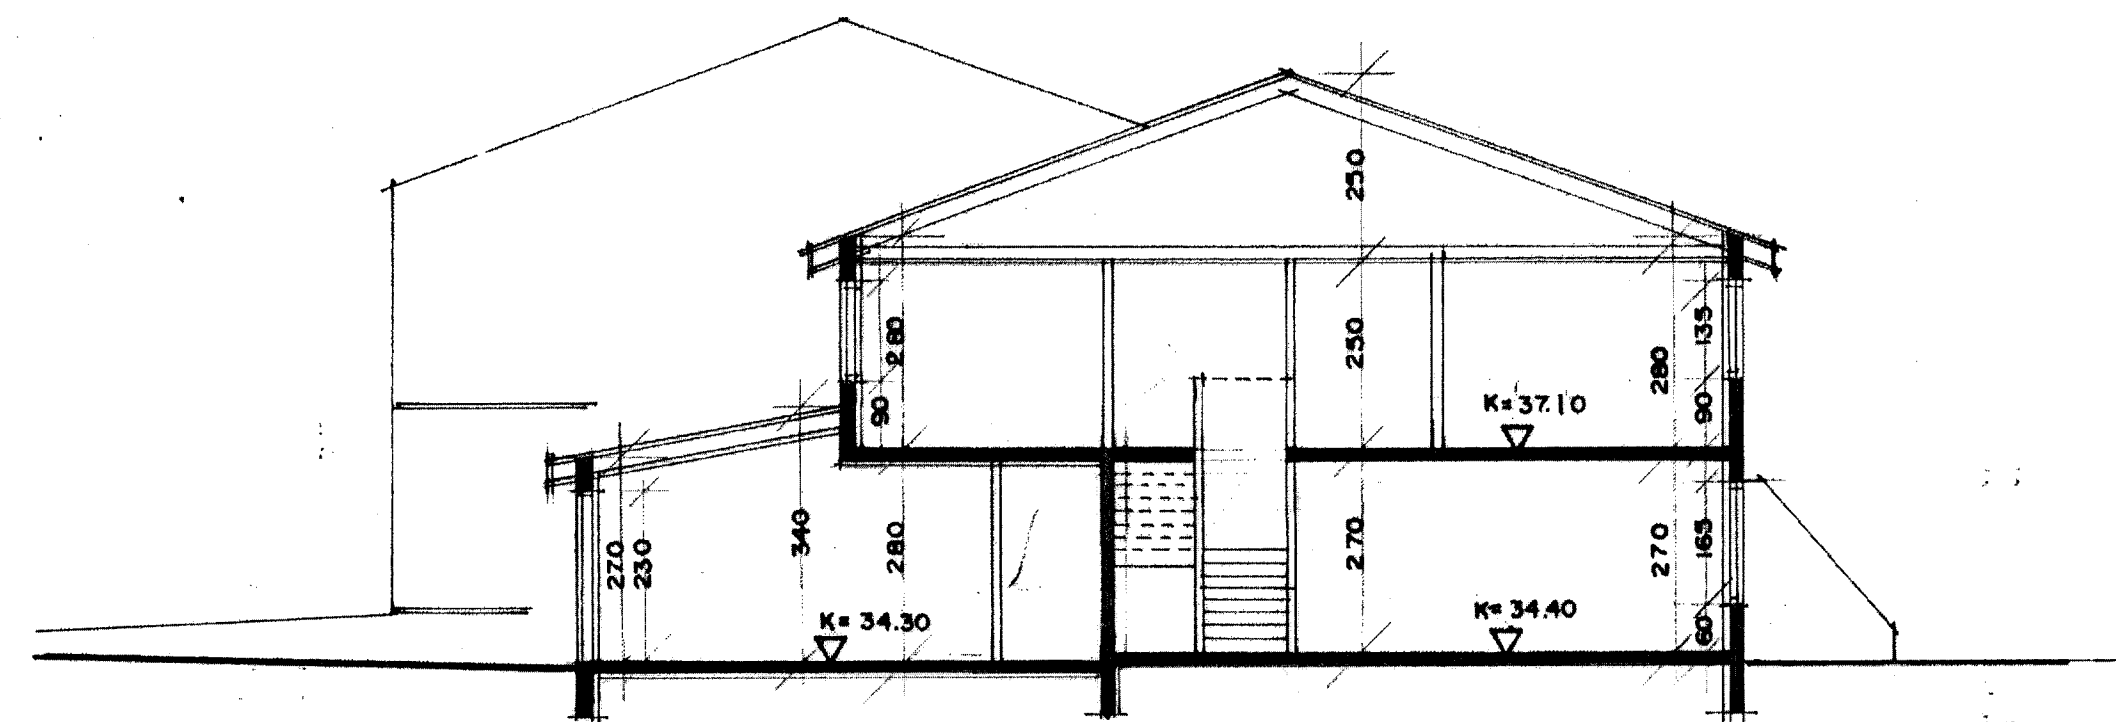


SNIÐ B-B M. 1:100

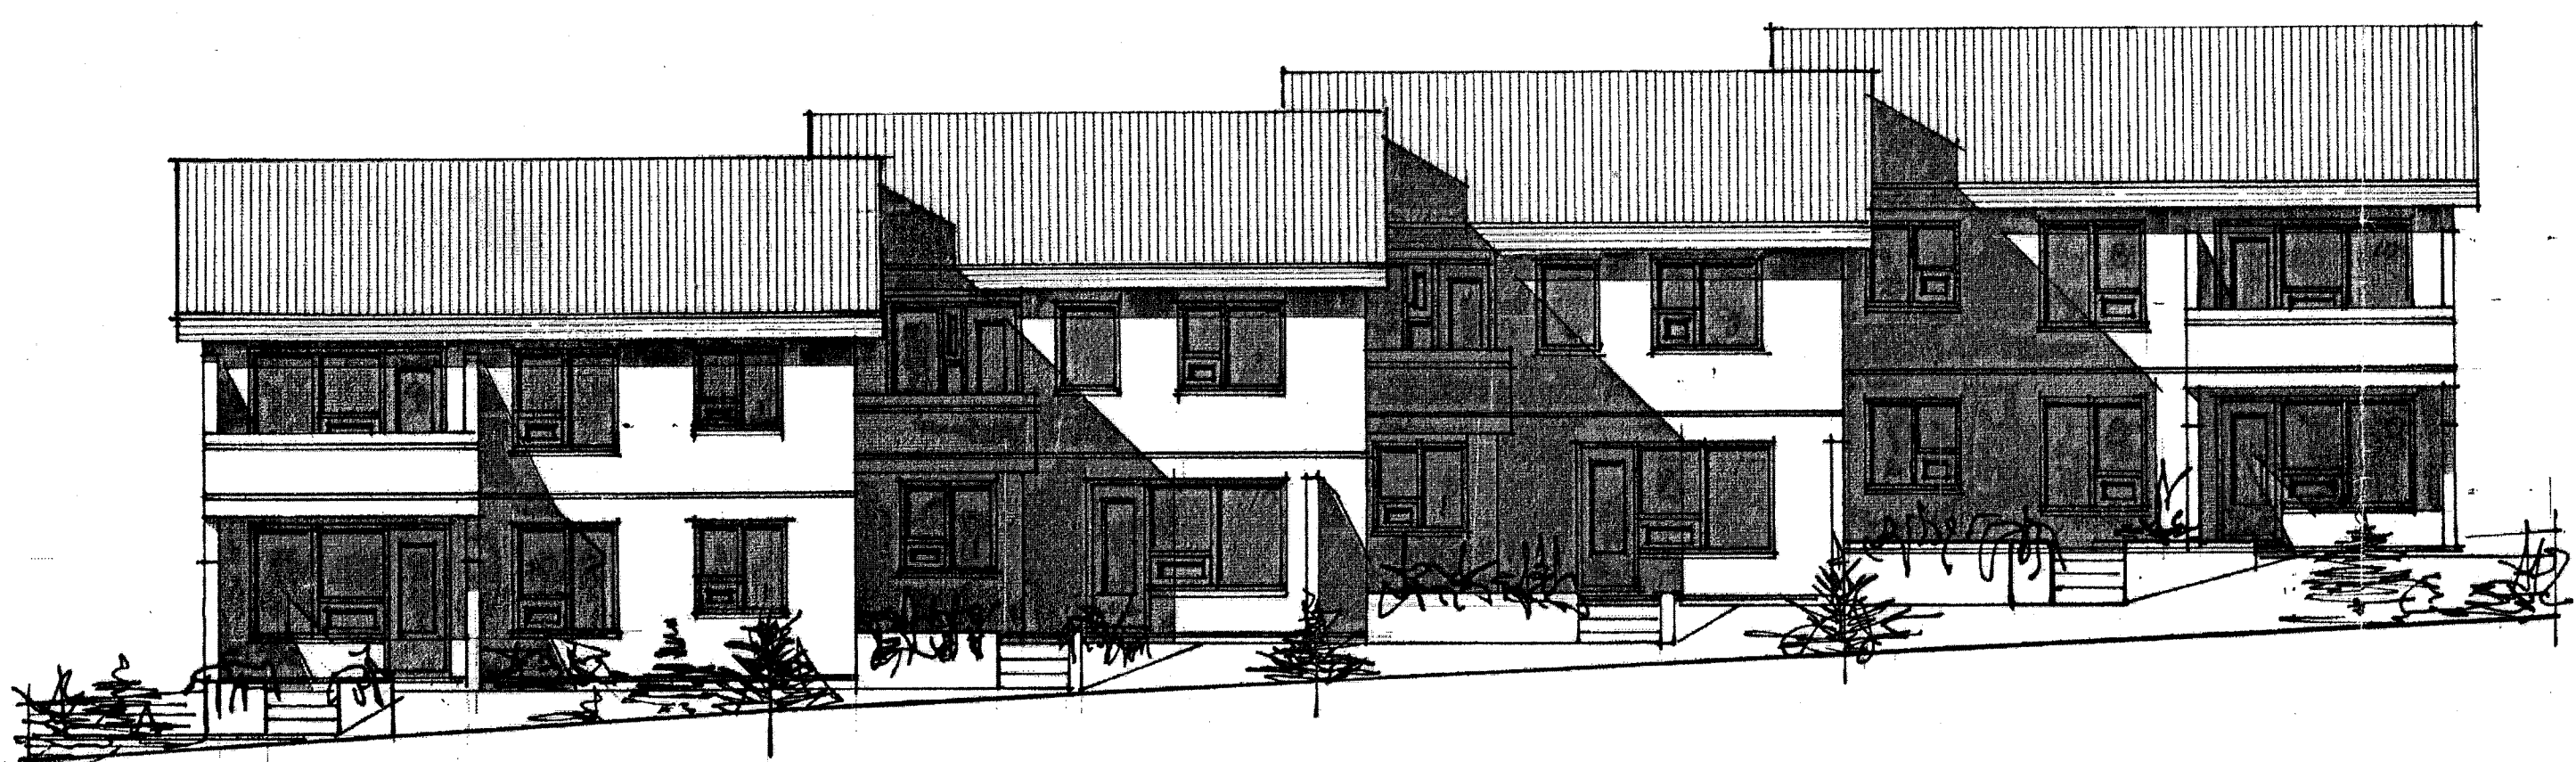

SUÐ-VESTUR M. 1:100

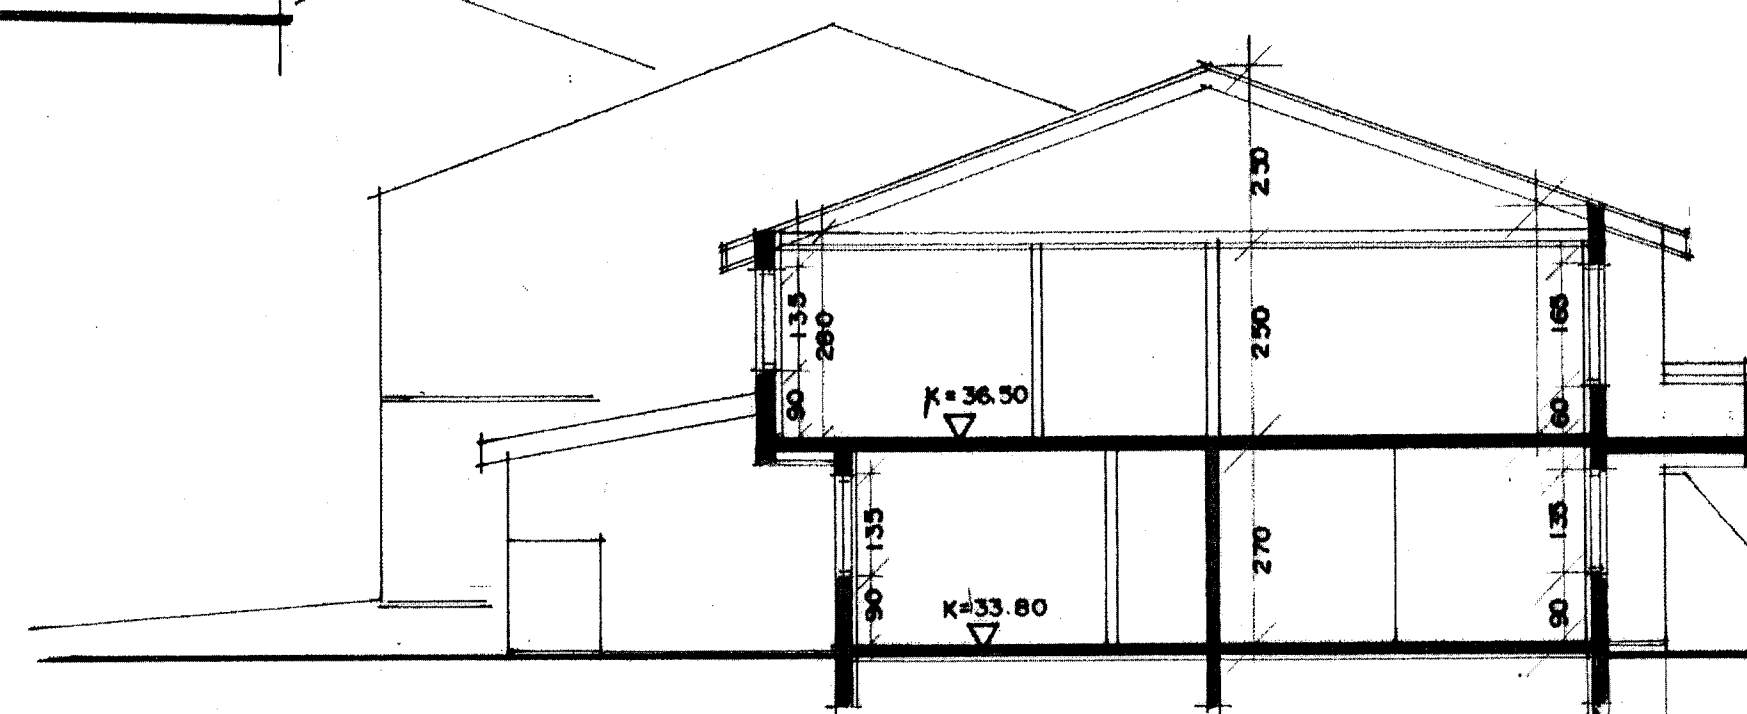


SNIÐ C-C M. 1:100

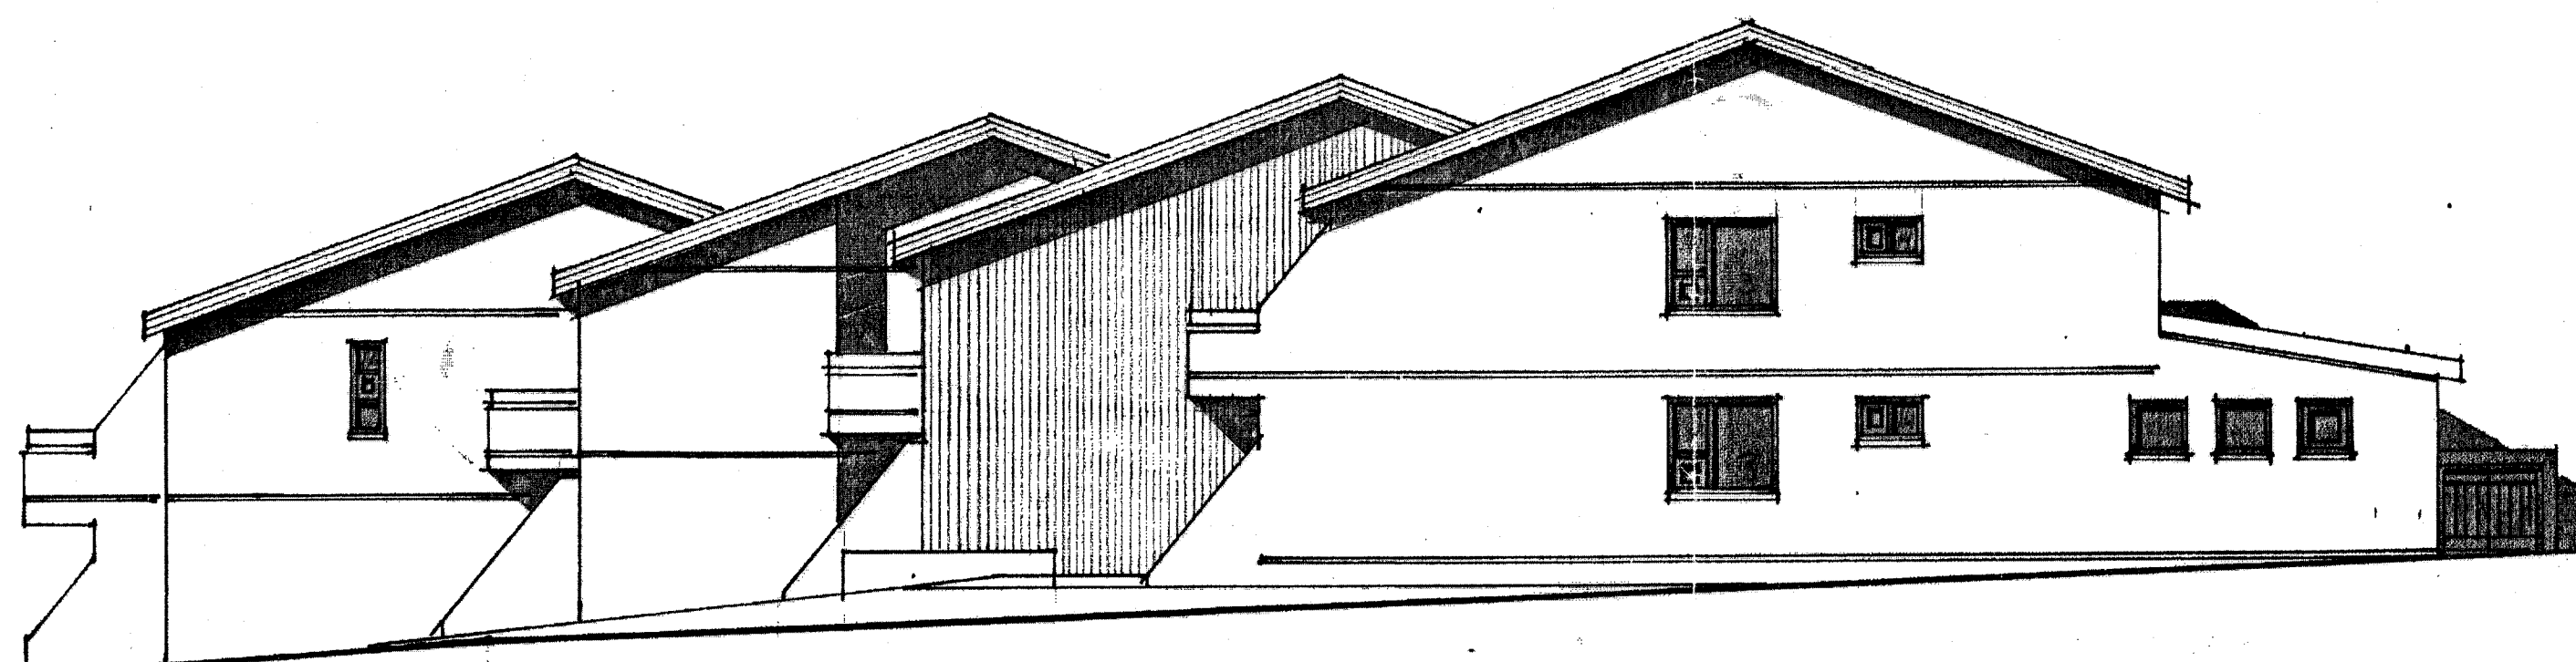

SUÐ-AUSTUR. M. 1:100.

SUÐAUSTUR GAFL HÚSSINS NR. 20. KLÆDDUR MED LITADRI
BÁRUSTÁLSKLÆDNINGU Á 50*50 MM TIMBURGRIND, Fyllt í
GRIND MED 50 MM RAKAPOLINNI STEINULL.

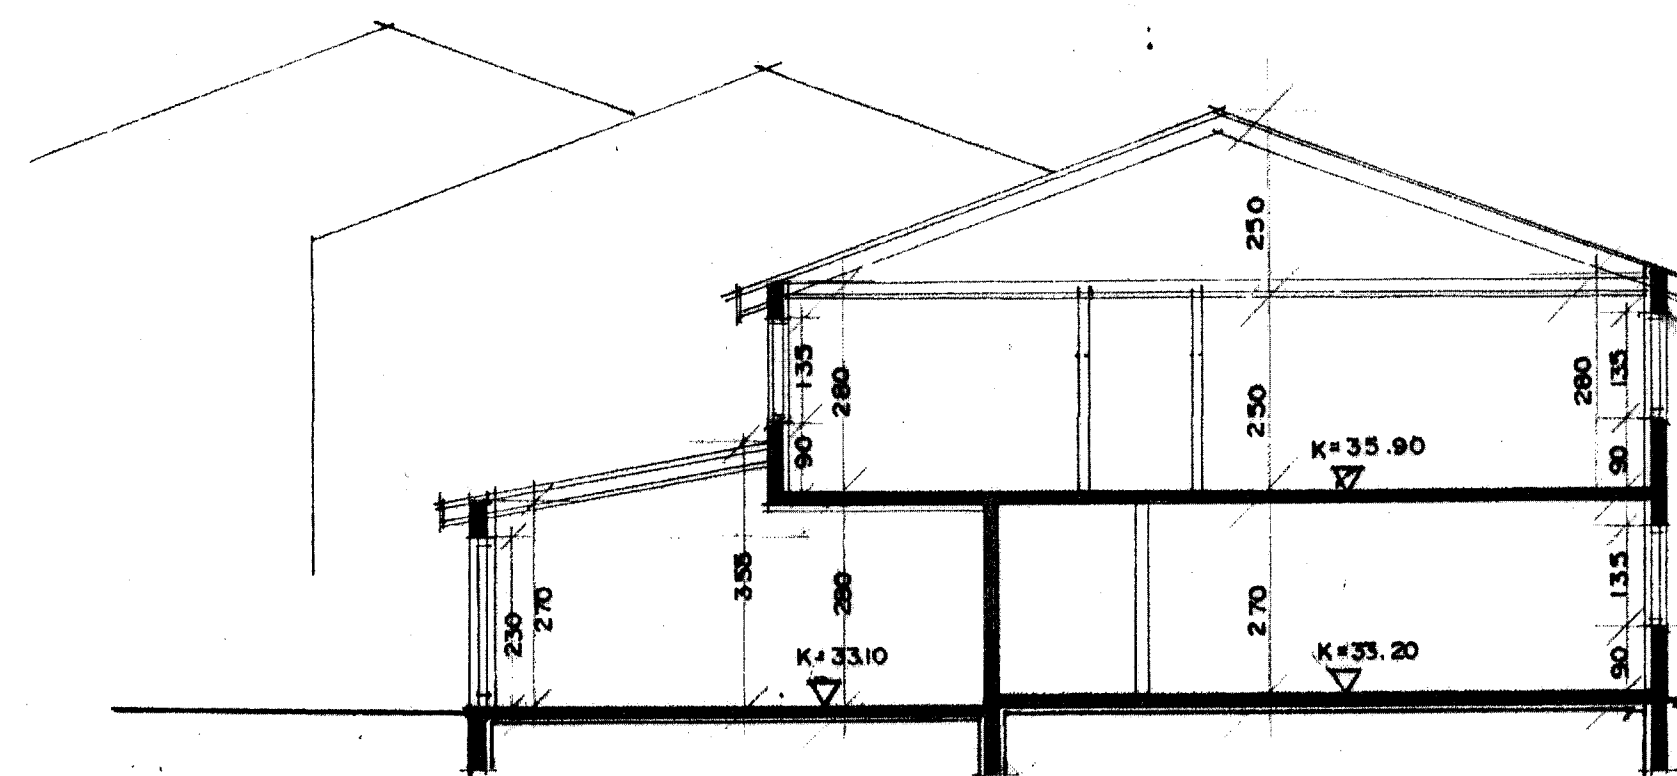

SNIÐ D-D. M. 1:100.

12/8 04 *Öjþ*
SUÐAUSTUR GAFL HÚSSINS NR. 20. KLÆDDUR MED LITADRI
BÁRUSTÁLSKLÆDNINGU Á 50*50 MM TIMBURGRIND, Fyllt í
GRIND MED 50 MM RAKAPOLINNI STEINULL.
Breytt 5 AGÚST 2004 *Öjþ*