




Borgarhella 13
mhl. 01

Borgarhella
13 mhl. 01


Samþykkt þann
02. nóv. 2022
fh. byggingarfulltrúans í Hafnarfirði
Róbert A. Róbertsson

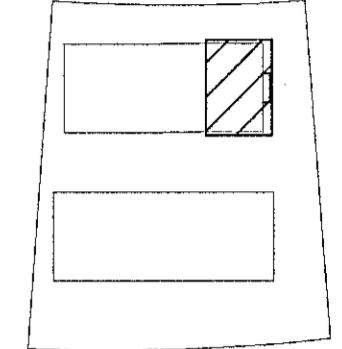

LYKILMYND

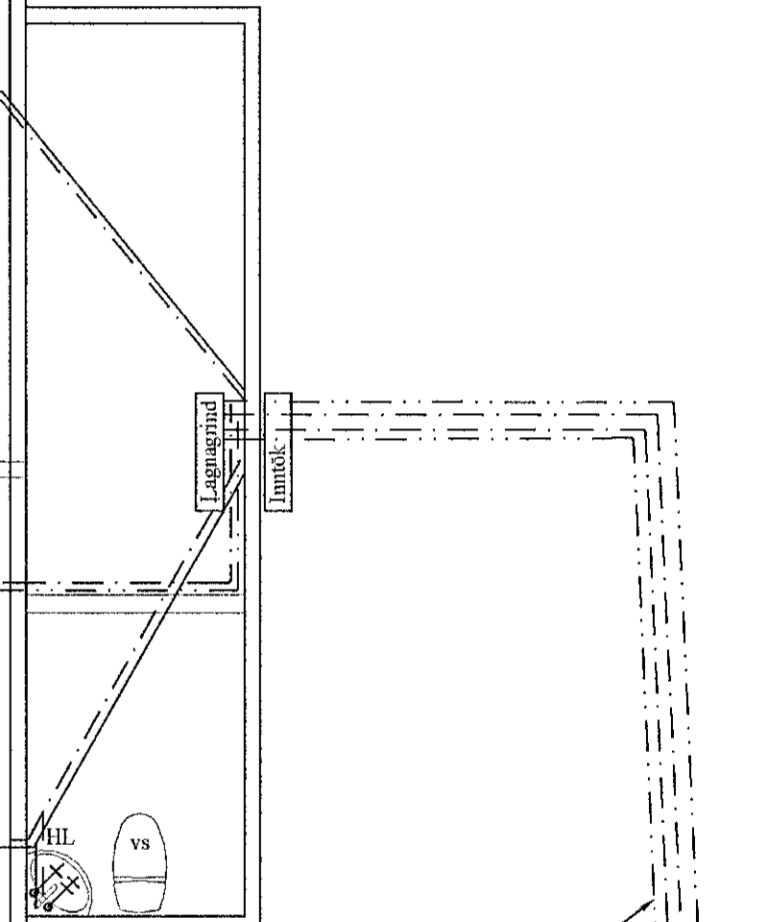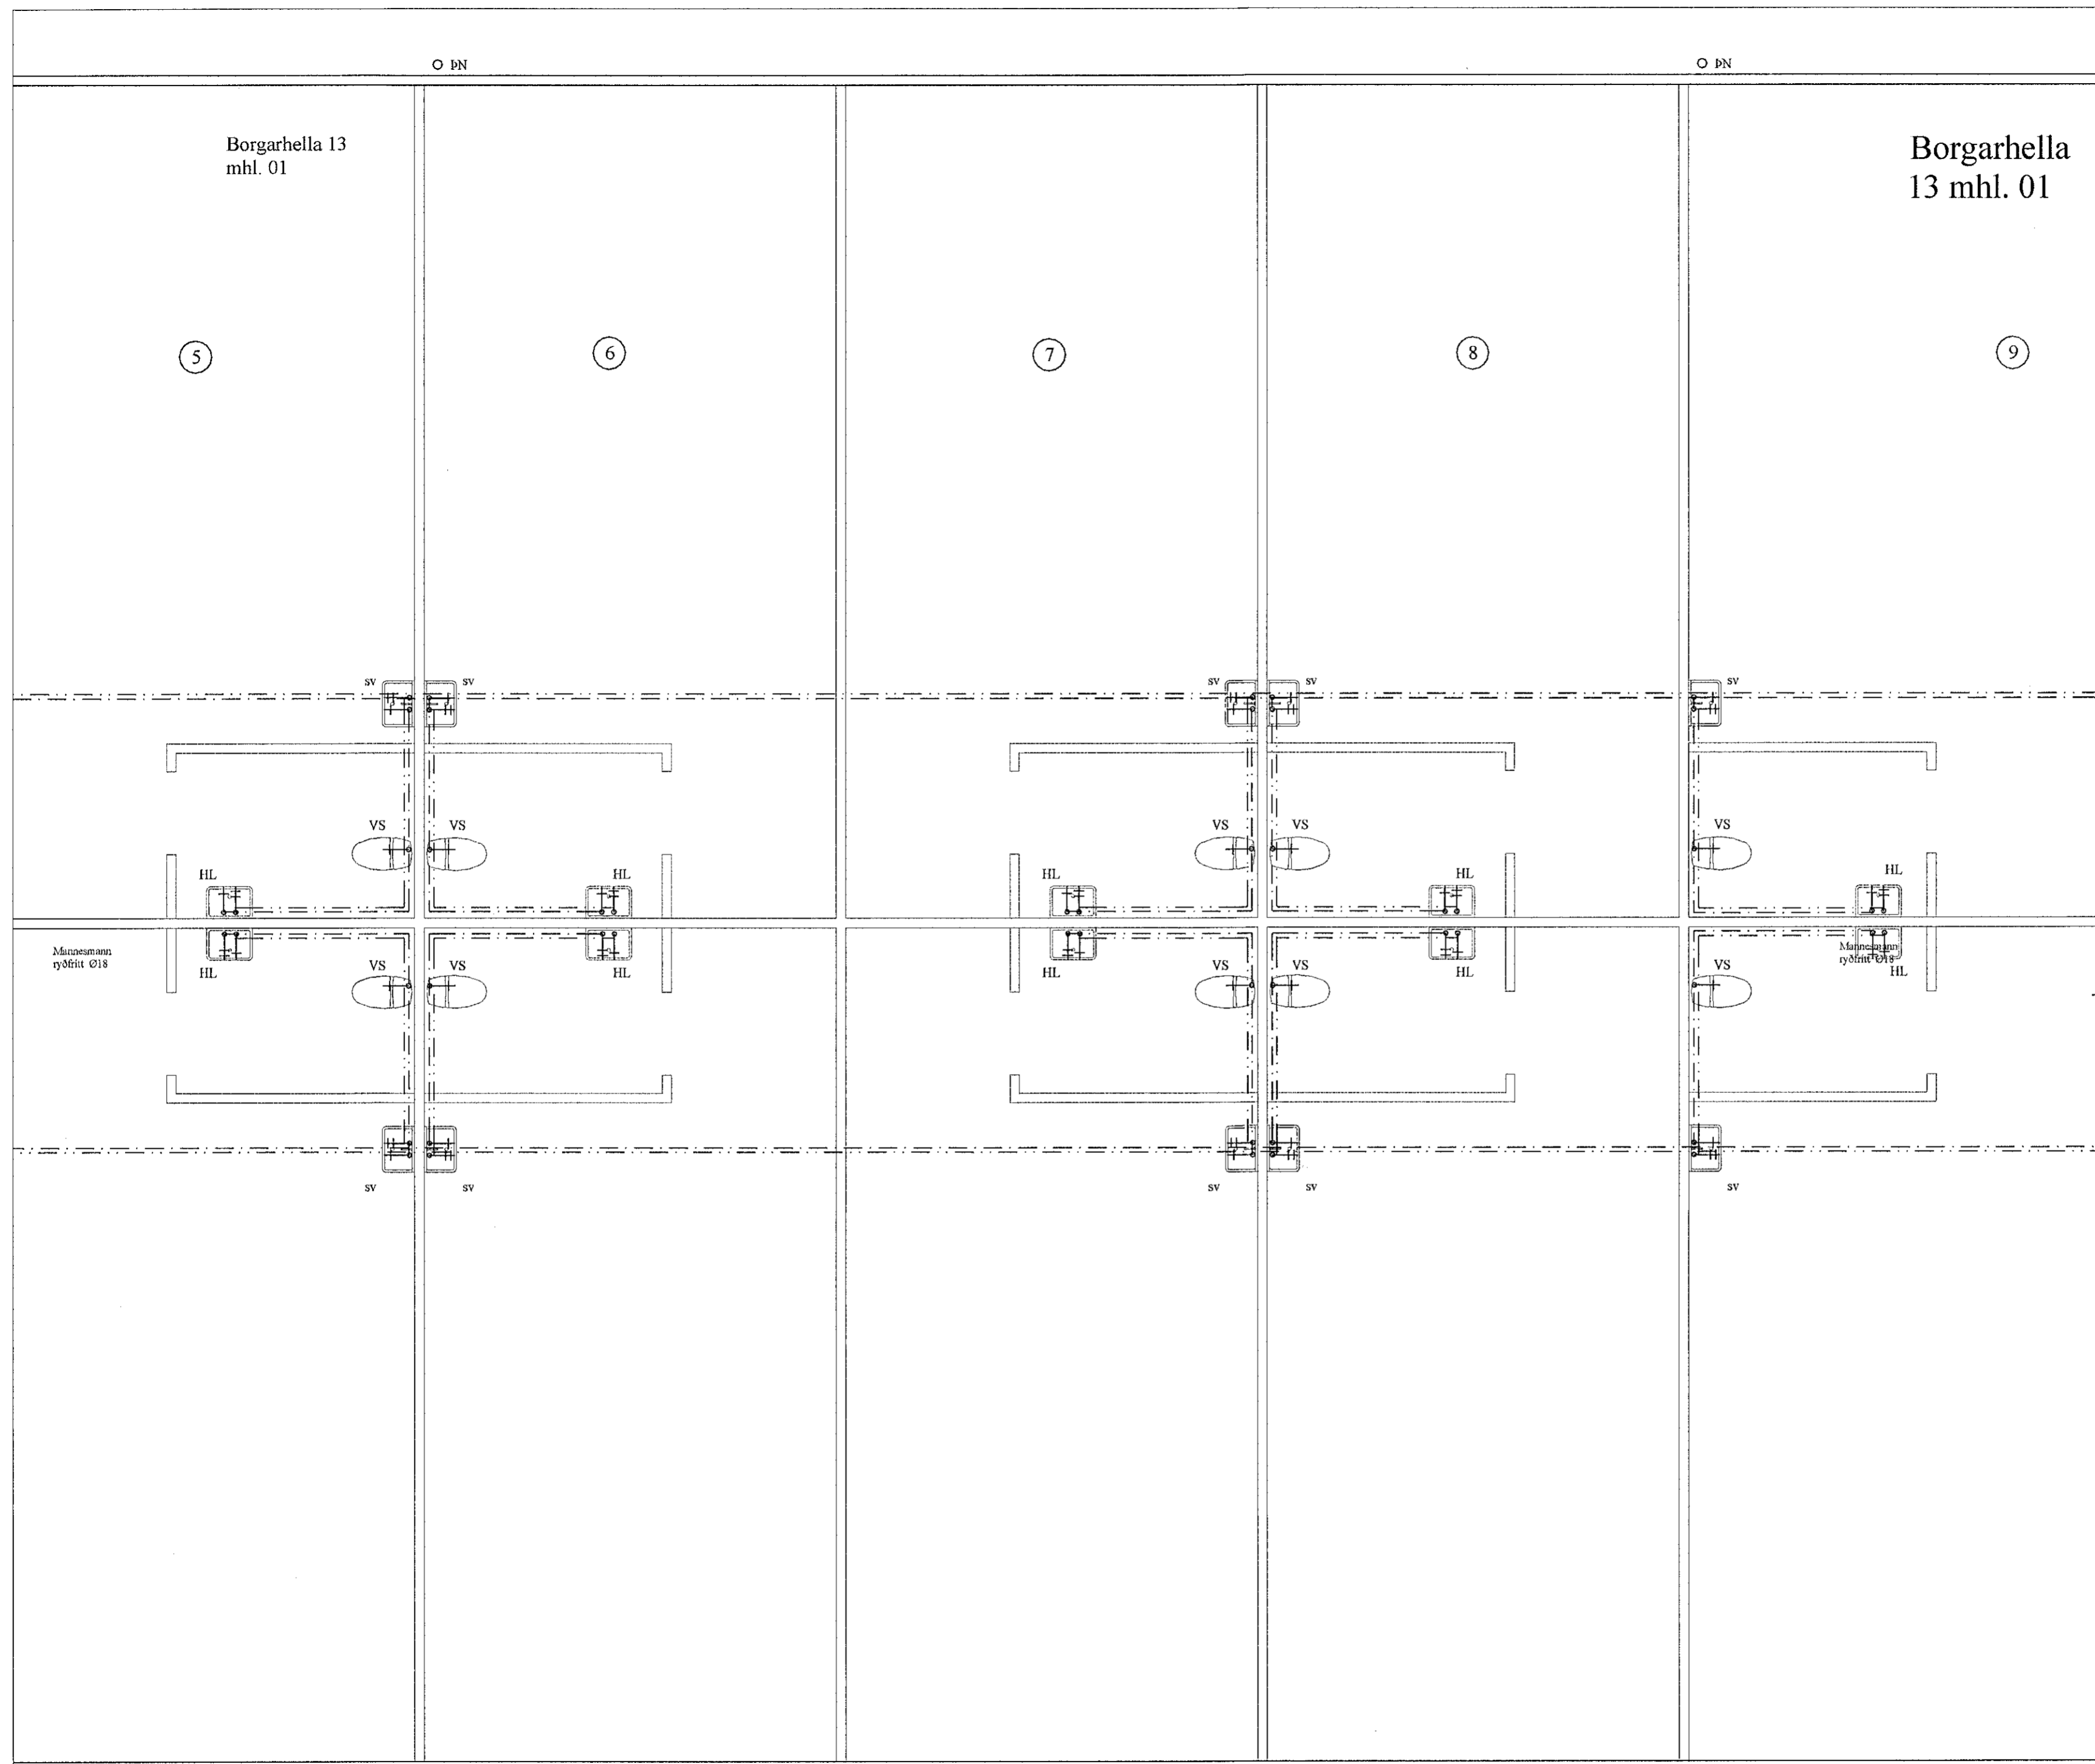

Heitt vatn Ø40
mm SDR 11
Pex einangrað á
milli mhl. 01-02

BR	DAGS	BREYTING	
KG	01.10.2022	Stofn vatnslagna lagðar undir gólfplötu	
HÖNNUNARSTJÓRI:		<i>[Signature]</i>	
 HJAREÐARHOLTI 11 800 SELFOSSÍ Sími: 783 4180 Netfang: kjarfangardars@gmail.com		2201003434	
Ártún ehf. 12.07.2021			
Borgarhella 13 mhl. 01			
Lagnir:			Kvarði 1:50
Grunnmynd neysluvatnslagna			
HANNAD:	TEIKNAD	DAGSETNIG	VERKNUMER
KG	KG	20.12.2021	2021-06
SKRÁARNAFN	SAMÞYKKT	130555-7619	TEIKNINGNUMER:
Borgarhella 13 Lagnir.dwg			316

Grunnmynd fráveitulagna
MKV: 1:50