


Samþykkt þann  
 02. nóv. 2022  
 fh. byggingarfulltrúans í Hafnarfirði  
 Róbert A. Róbertsson

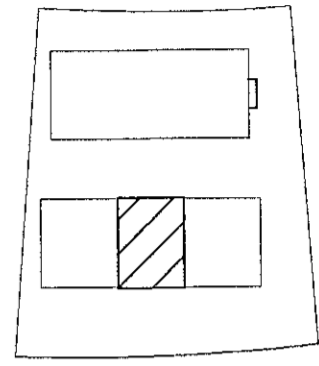

LYKILMYND

BR	DAGS	BREYTING
KG	01.10.2022	Stofn vatnslagna lagðar undir gólfplötu

HÖNNUNARSTJÓRI: *Hanna Ragnveig*  
 2201603439

**K** HJÁRÐARHOLT 11  
 800 SELFOSSÍ  
 Sími: 783 4180  
 Netfang: kjartangardars@gmail.com

Ártún ehf. 12.07.2021  
**Borgarhella 13 mhl.02**  
 Lagnir:  
 Grunnmynd hitalagna. Kvarði 1:50

HANNAÐ:	TEIKNAD	DAGSETNIG	VERKNÚMÉR
KG	KG	20.12.2021	2021-36
SKRÁARNAFN	SAMÞYKKT	130555-7649	TEIKNING NÚMÉR:
Borgarhella 13 Lagnir.dwg			322

Grunnmynd hitalagna  
 MKV: 1:50

○ PN

○ PN