



G: 5.70

Samþykkt þann
07. maí 2013
Byggingufulltrúinn í Hafnarfirði
Fh. Höfður S. Gunnlaugsson

Br. A Stigahús og tröppur leiðr. dags. 10.04.13

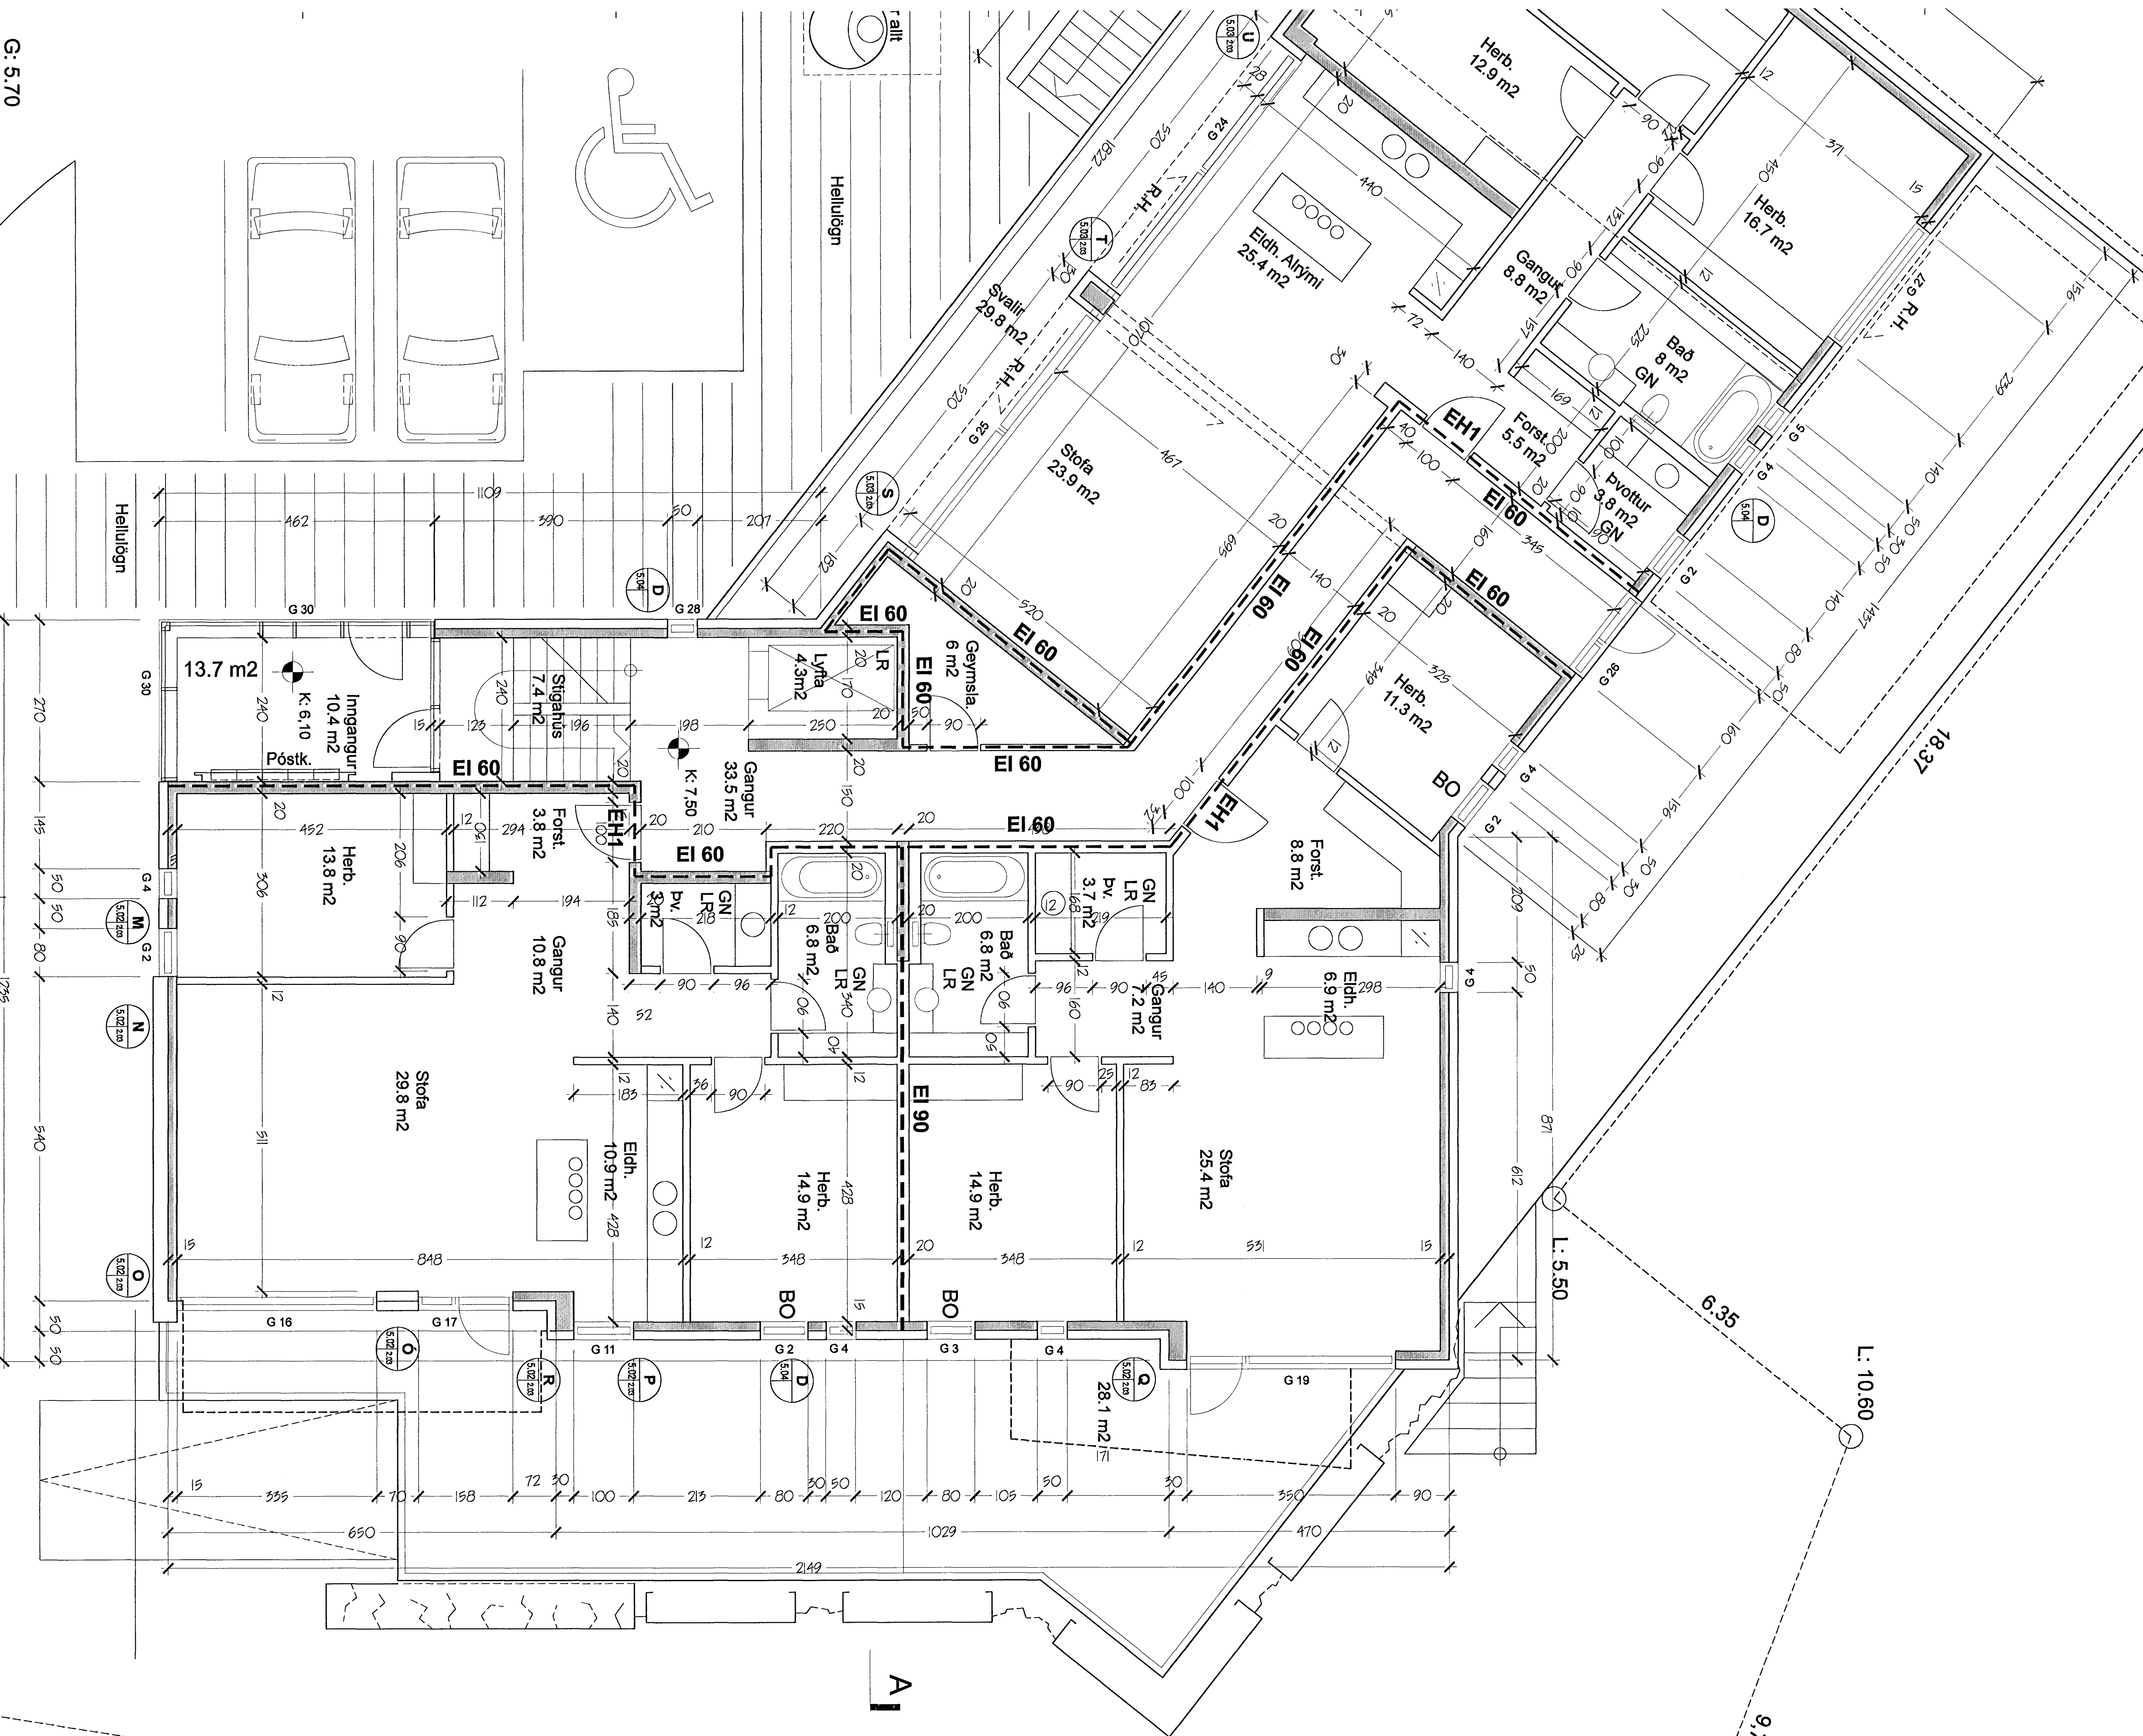

L: 9.70

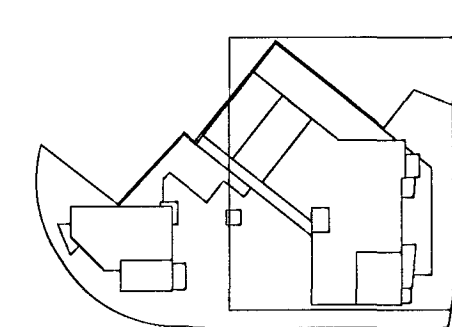

VESTURGATA 18
Fjölbýli í Hfj. mkv: 1:50 **2.03**
Verkefning
Grunnmynd_1. hæð
Suður 18 dags. 29.10.07

Att Arkitektar
Suðurlandsbraut 30 108 Rvk. kt: 590406 0580
tryggvi.tr@gmail.com GSM: 897 2380
Tryggvi Tryggvason
Tryggvi Tryggvason FAI kt: 261256 5769

att arkitektar _ í samstarfi við _ einrúm arkitektar
einrúm arkitektar
glaðshöllum 20 104 Reykjavík
sími 553 8989 fex 568 8989
E.Ú.Í.Í.
Krisla Brynja Gunnarsdóttir arkitektar fuf
kt: 040764 5889 k@einrum.com

