
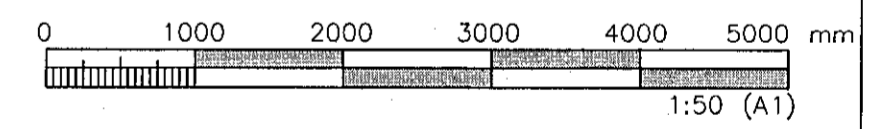


**SKÝRINGAR:**  
ALMENNAR SKÝRINGAR SJÁ TEIKN. AX01

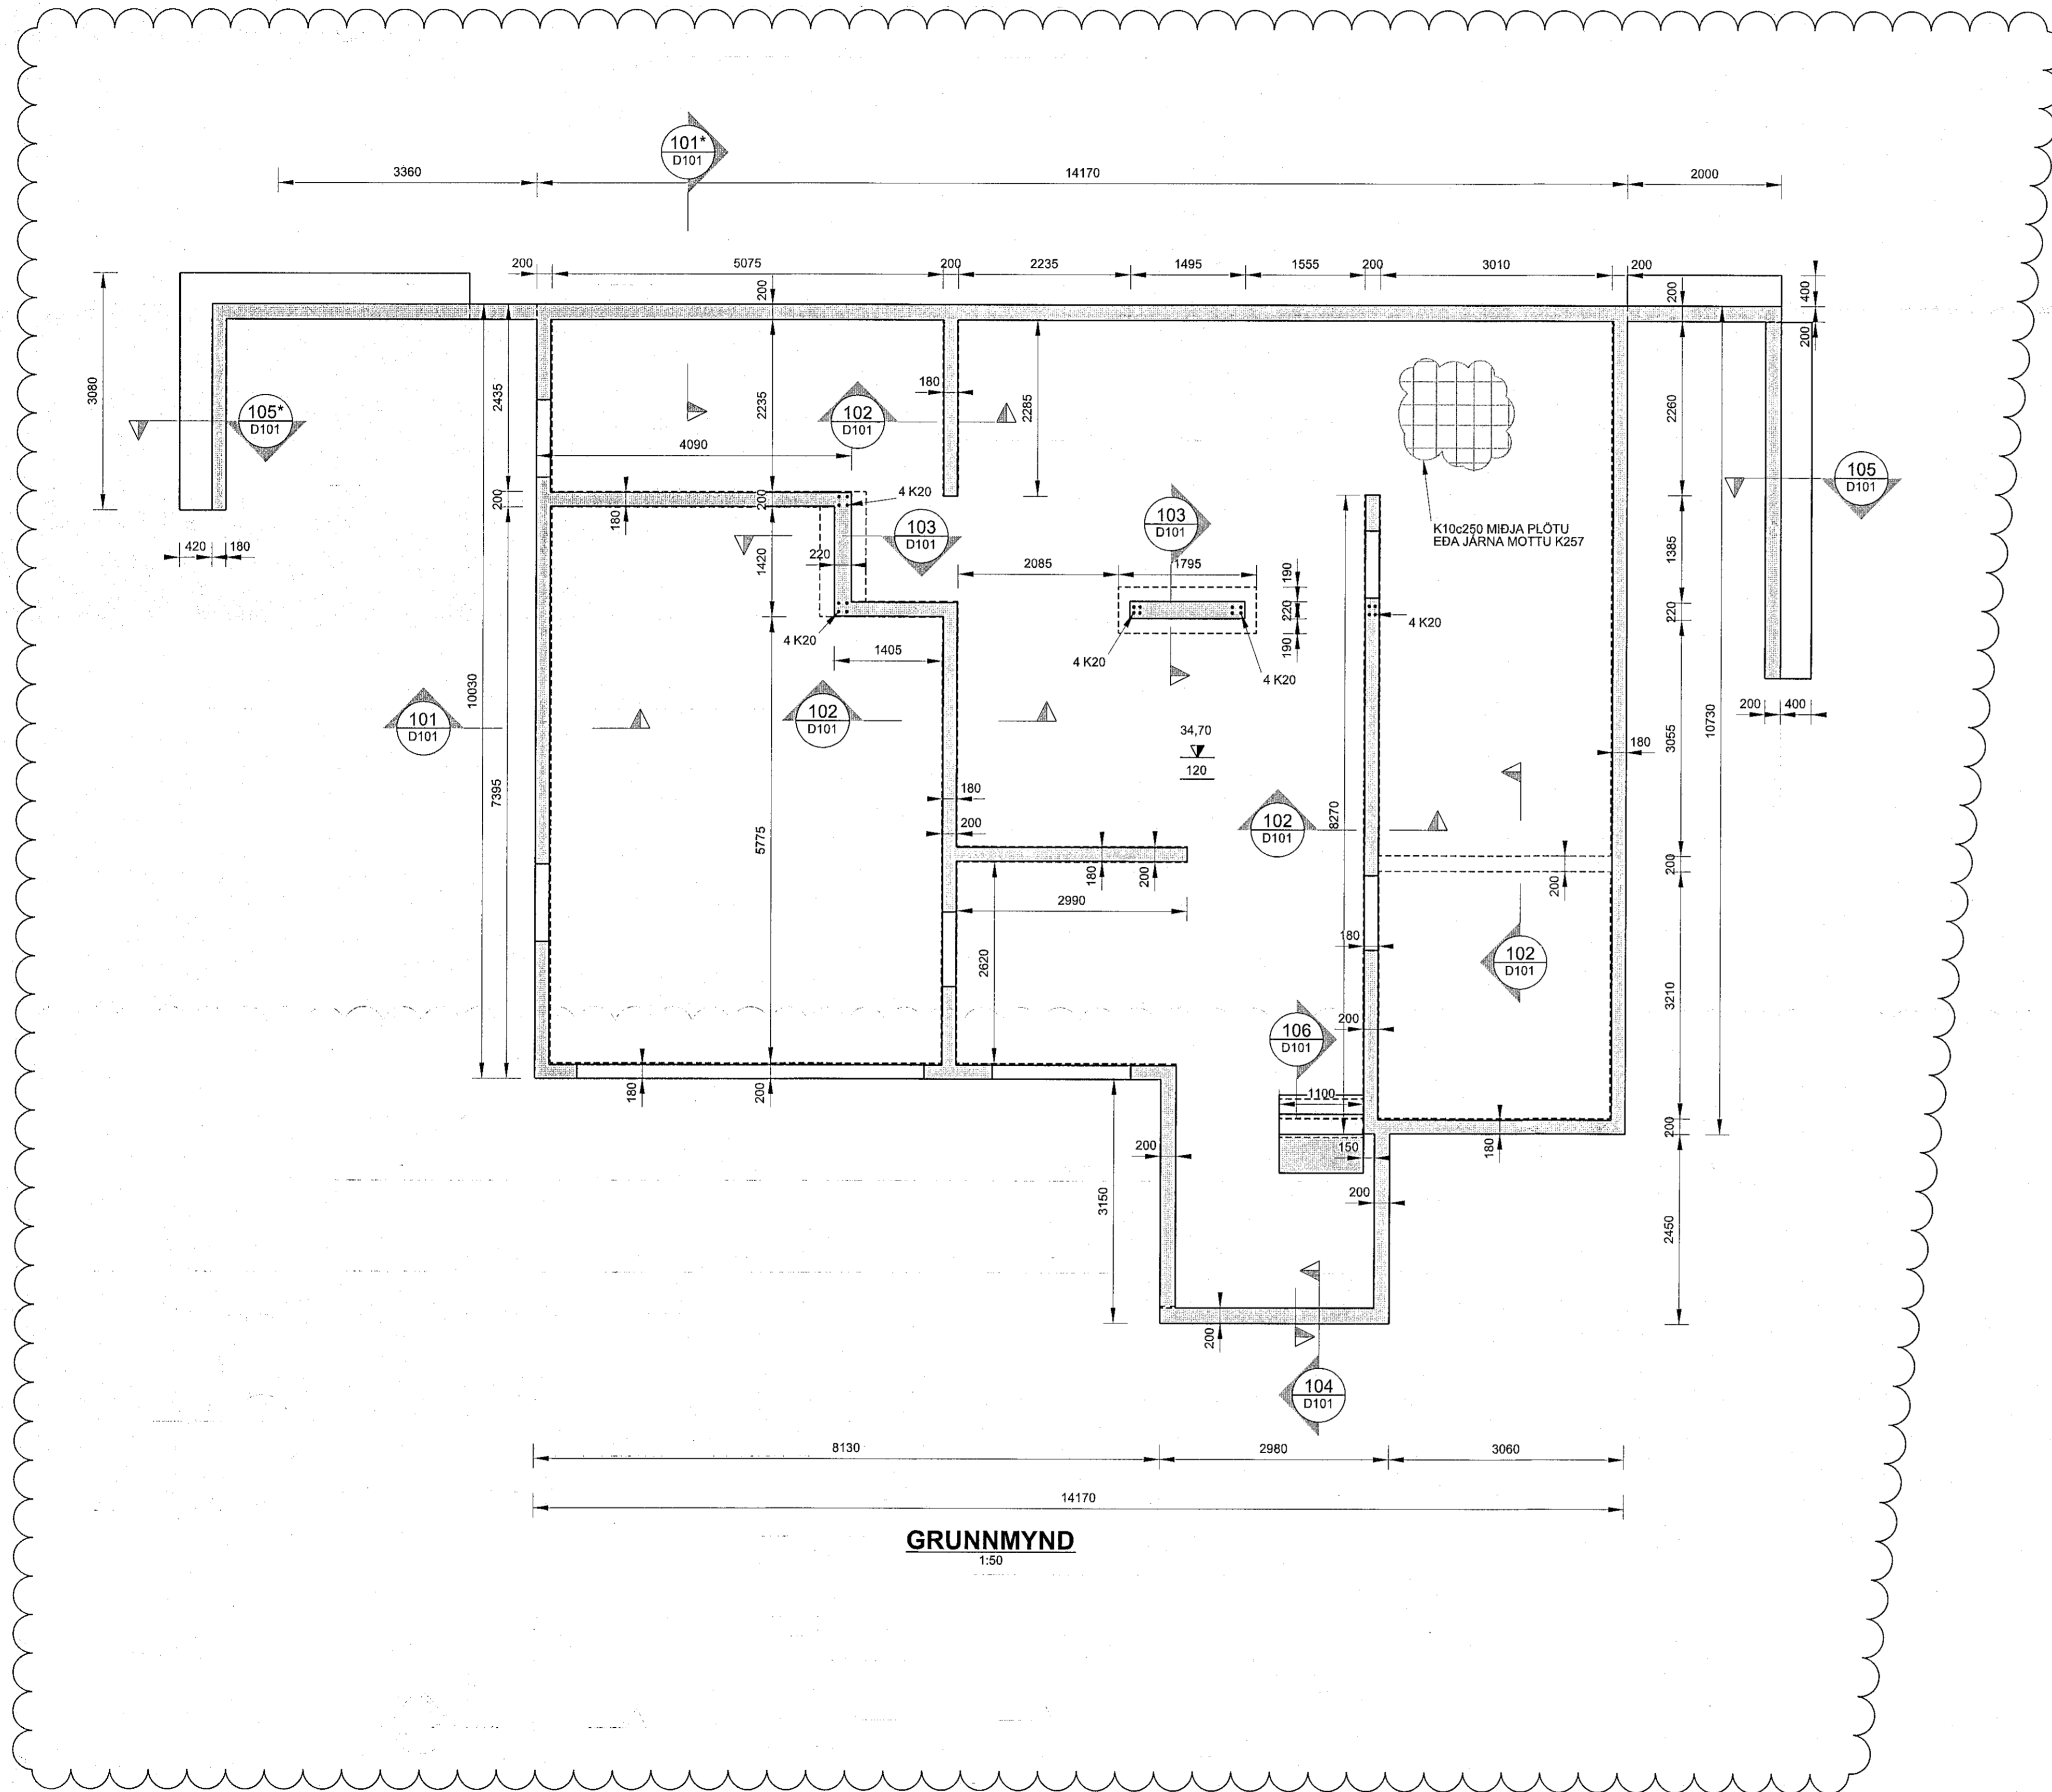

ÚTGÁFUERILL			
ÚTG.	DAGS.	SKÝRINGAR	SMV.
01	24.03.2021	BYGGINGARTEIKNING	SMV SMV
02	10.12.2021	BREYTINGAR Á UNDIRS.	SMV SMV
DAGS UNDIRSKRIFTAR		UNDIRSKRIFT	
10.12.2021			KT:230488-2589
HÖNNUBUR			
Stefán Már Víðisson kt: 230488-2589 Breiðvangur 5, 220 Hafnarfjörður			
HEITI VERKS			
TINNUSKARD 5 221 HAFNARFJÖRÐUR			
HEITI TEIKNINGAR			
BURÐARVIRKI: SÖKKLAR OG GRUNNPLATA GRUNNMYND			
FRUMÚTGAFA	MKV.	STJÓRD	
24.03.2021	1:50	A1	
	TEIKNINGANUMER	ÚTGAFA	
190397-4109	G101	02	

**GRUNNMYND**  
1:50