
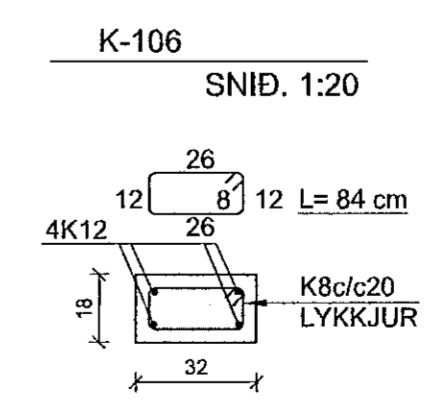
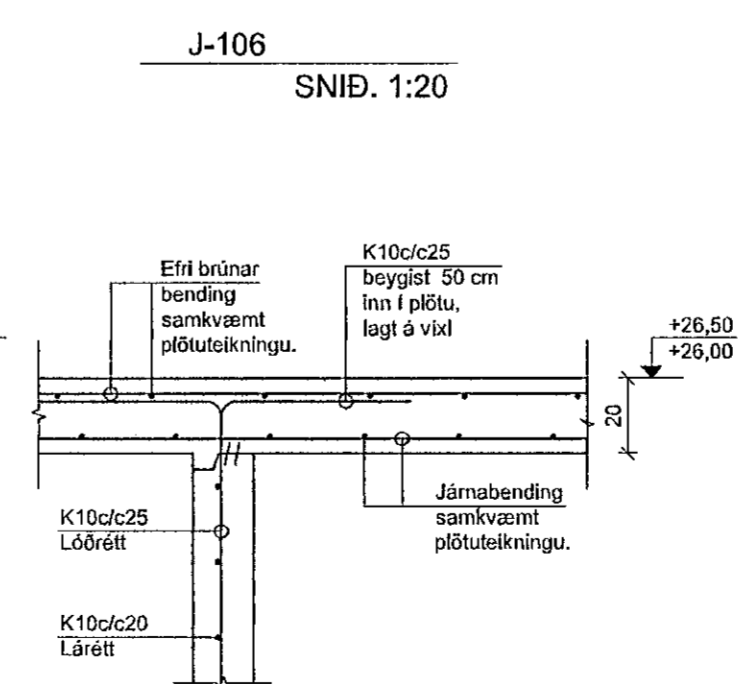
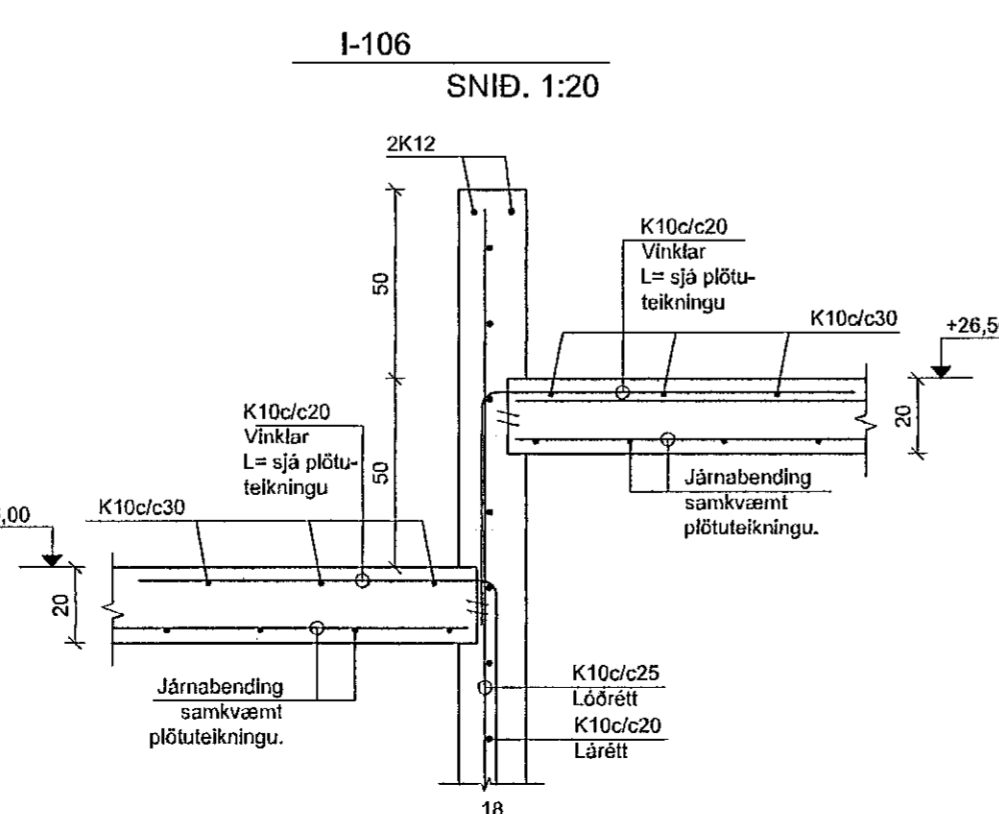
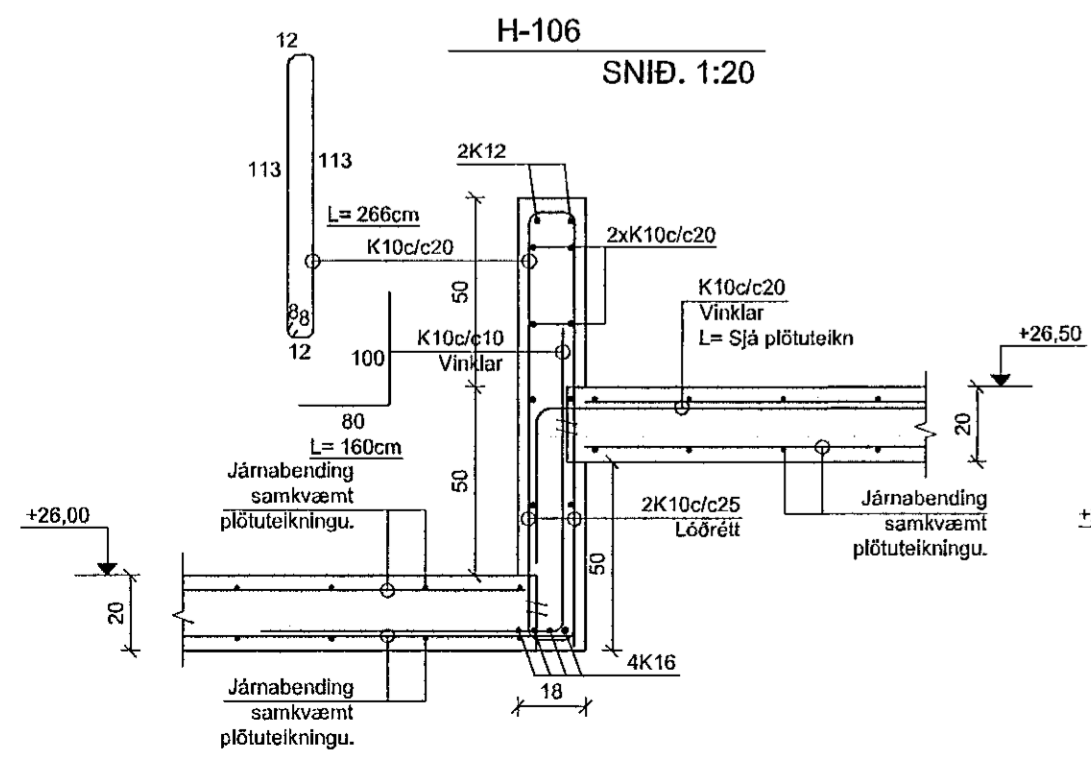
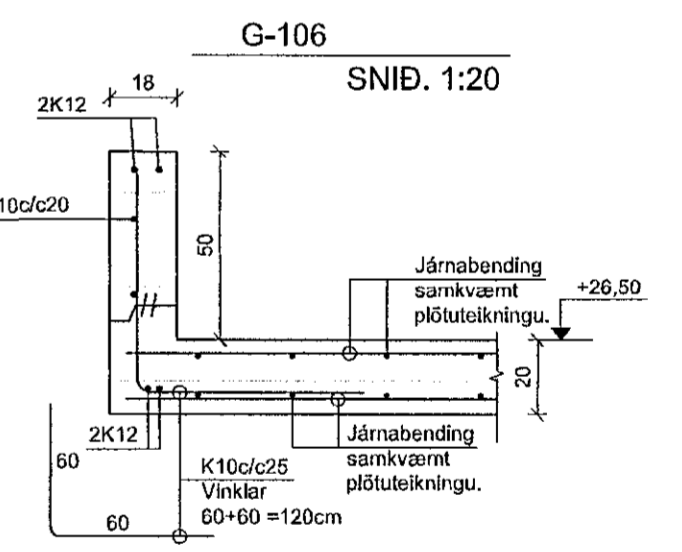
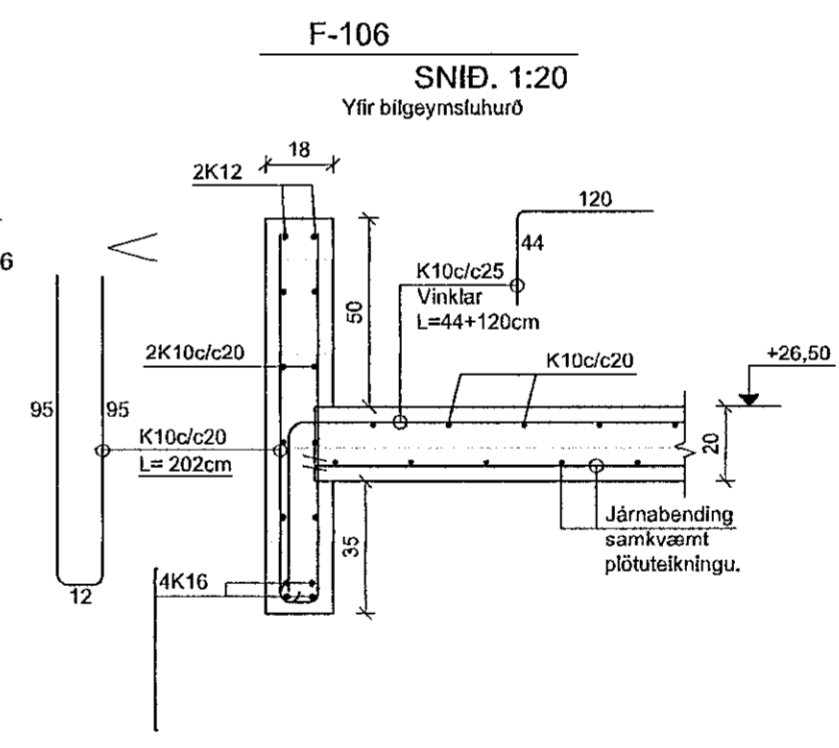
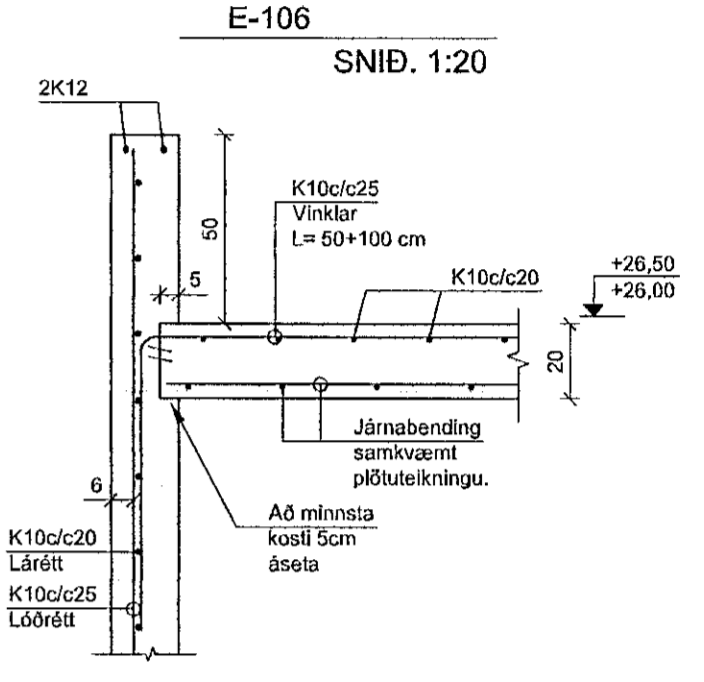
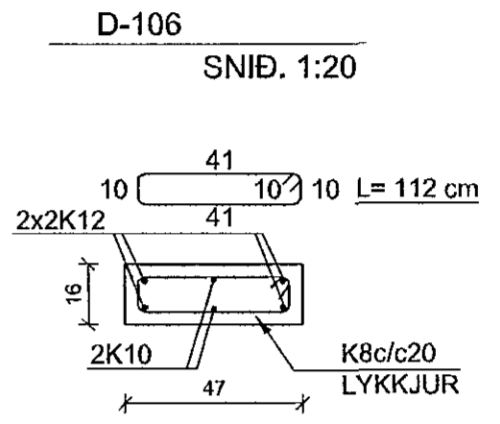
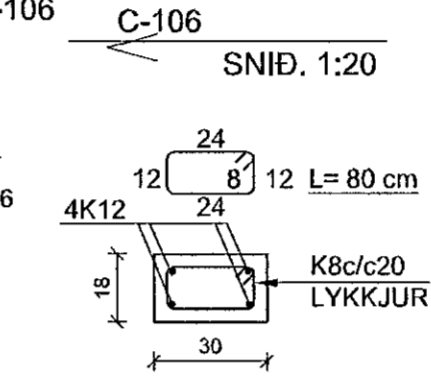
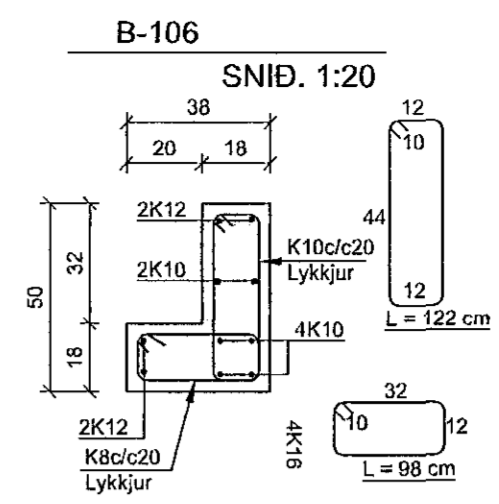
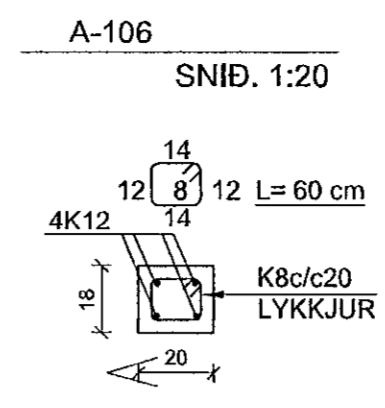


Þakplata, grunnmynd, mkv. 1:50

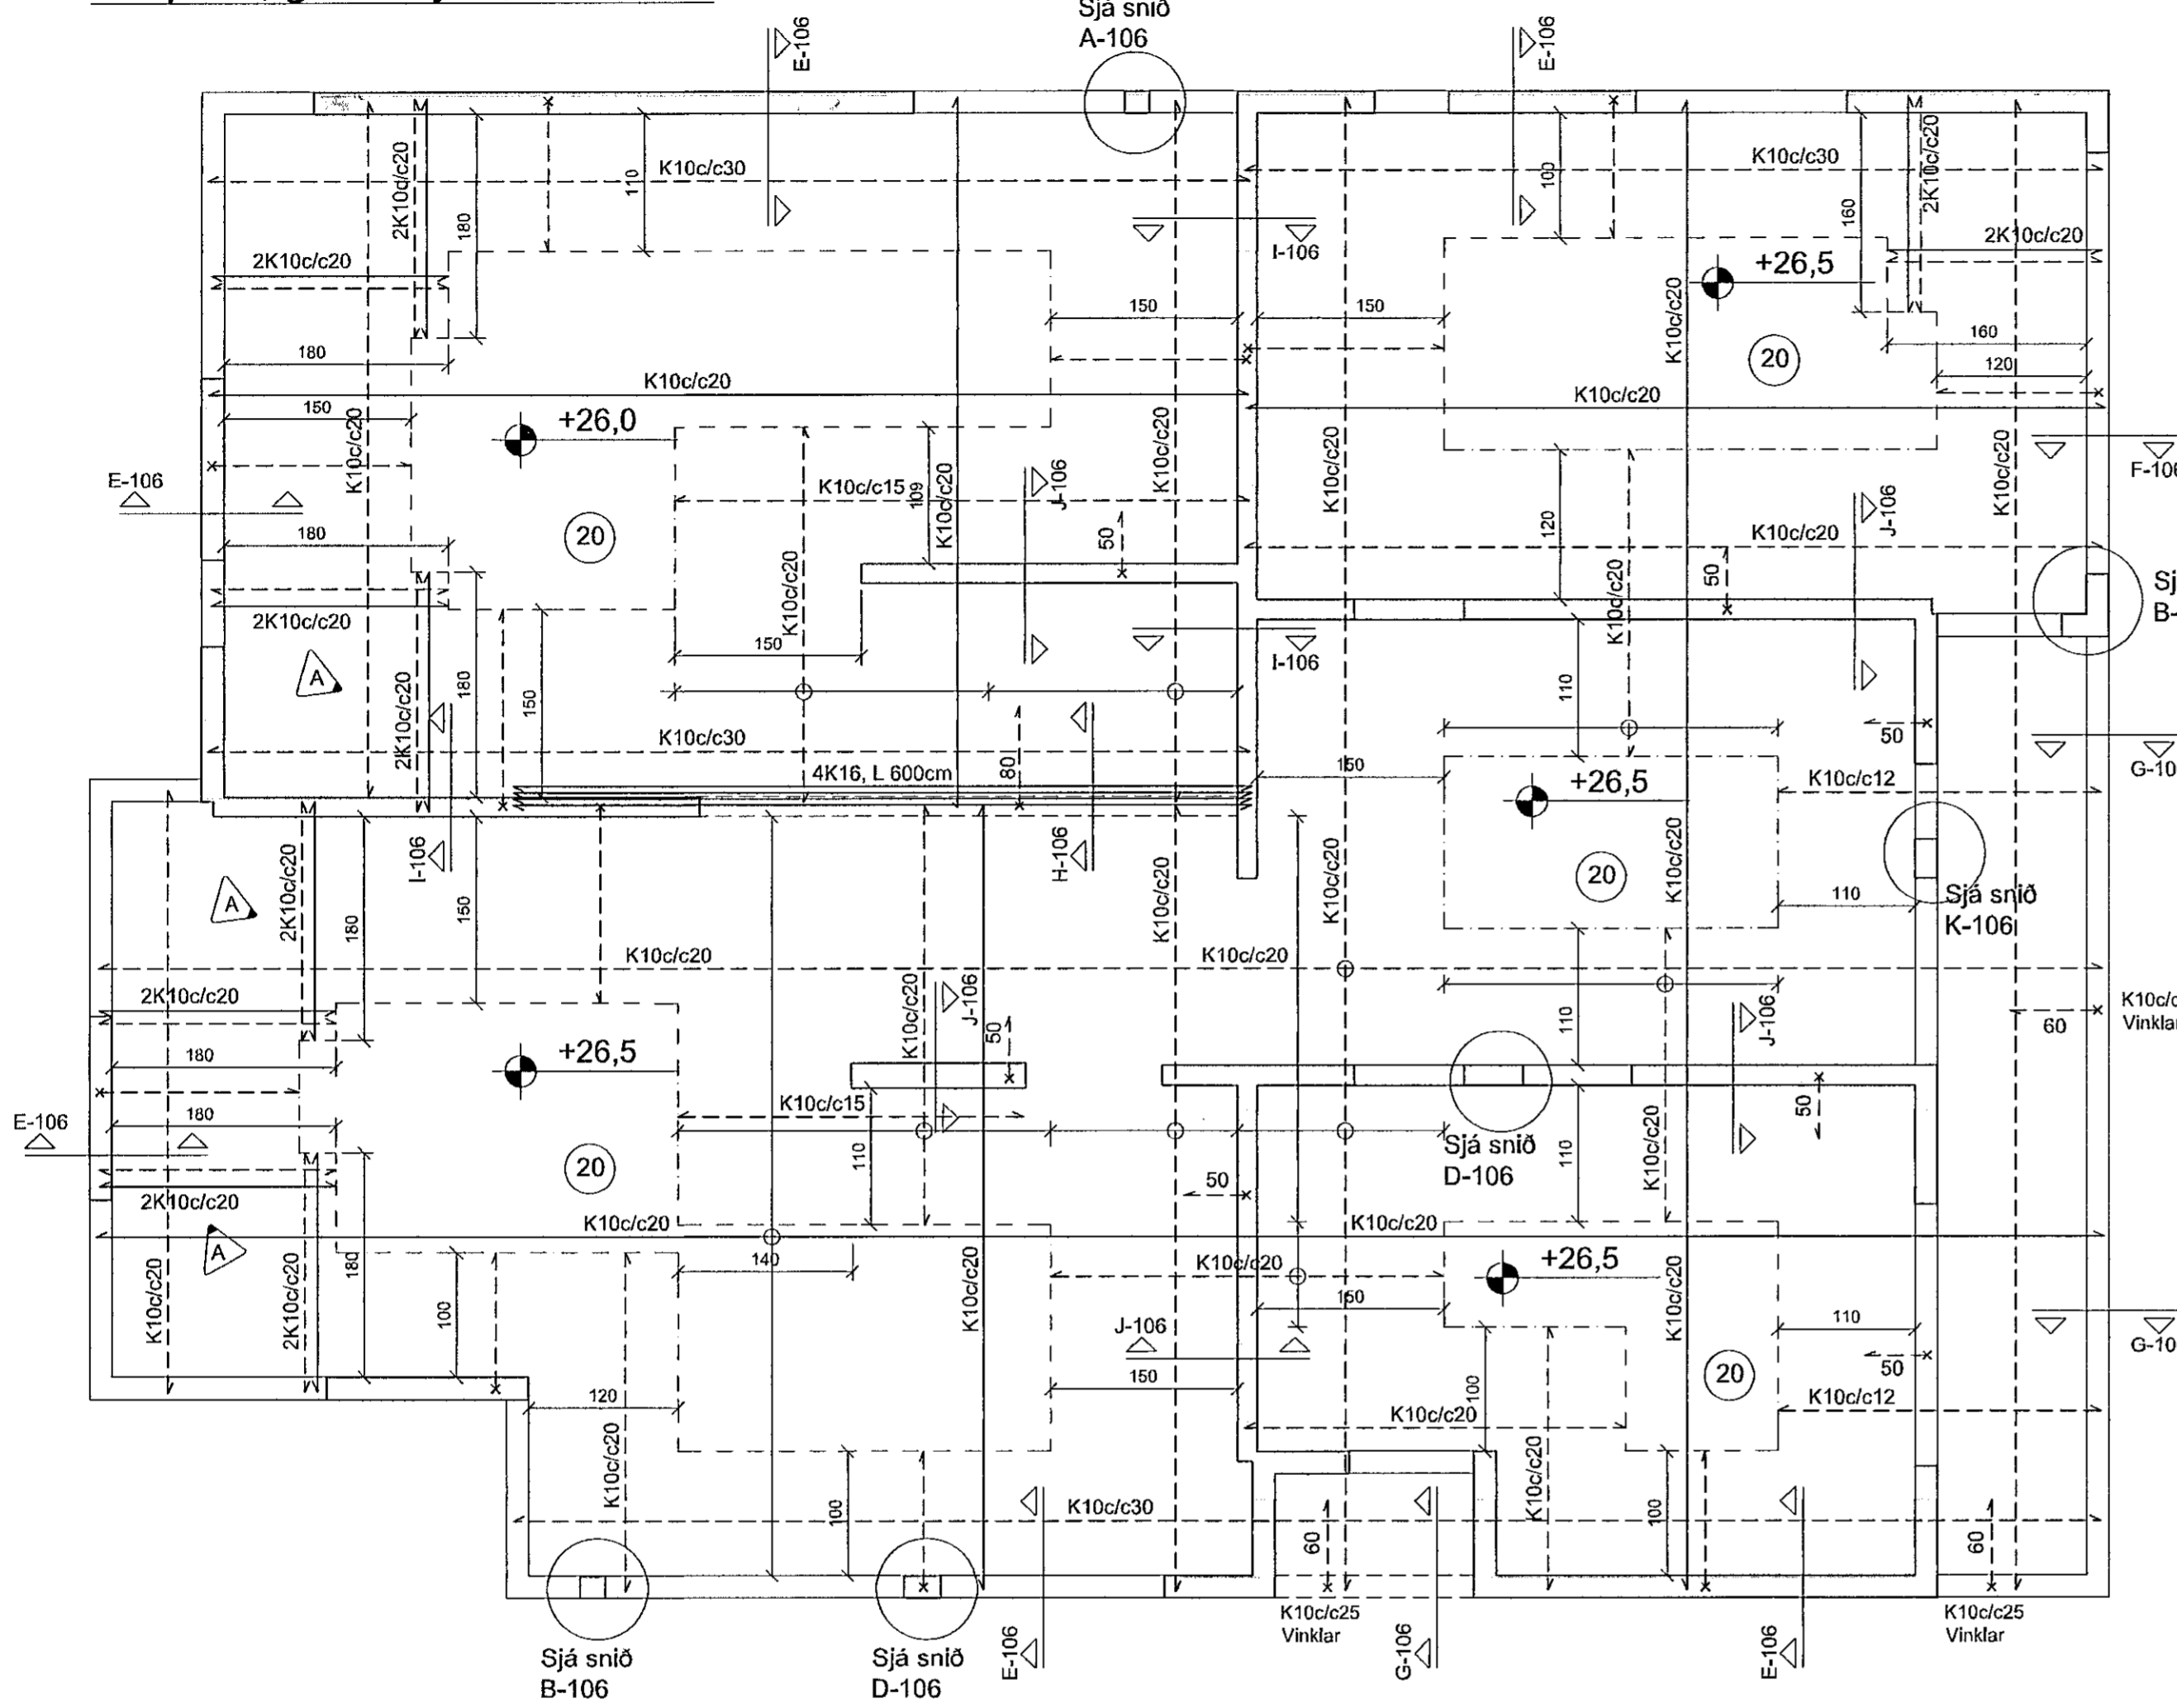

Breyting A: 26.9.14 - Smábreytingar á járnabendingu

Glitberg 3
221 Hafnarfjörður

Þakplata, grunnmynd og snið.	106
Burðarbol	Dags: 09.05.14 Mkv: 1:50, 1:20

TAG teiknistofa
Stúdumúla 9, 108 Reykjavík, sími: 568-6681, 699-4297
tag@teiknistofa.is

Jón Kristjánsson Byggingarverkefndingur
kt: 210754-4829
netfang: jon@tagteiknistofa.is

Atli Jóhann Guðbjörnsson Byggingarverkefndingur
kt: 260978-6789
netfang: atli@tagteiknistofa.is

Atlan hönnuðar: *[Signature]*