
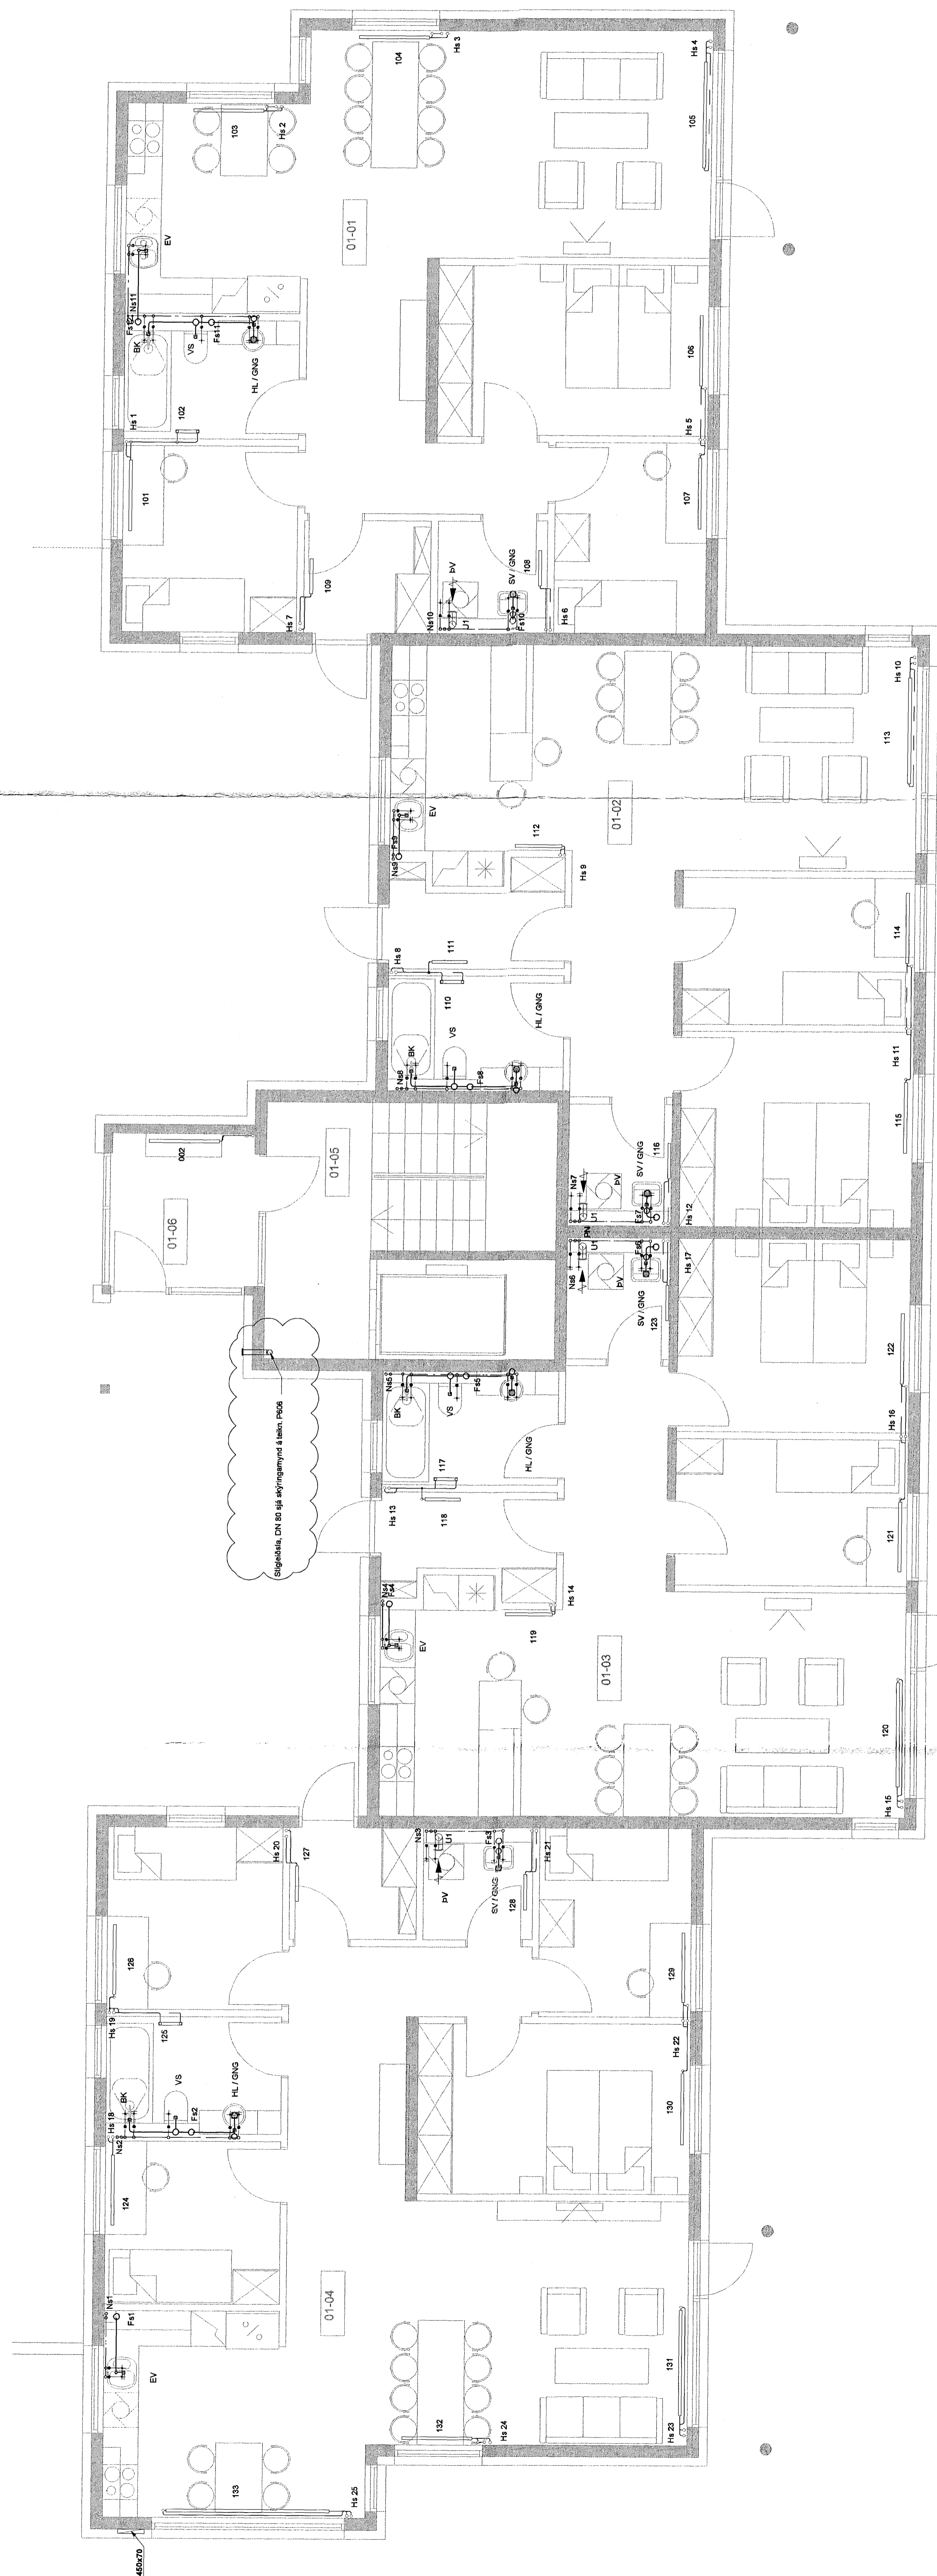


Skýringar:
16-16x2,0 Alplast
20-20x2,0 Alplast
25-25x2,25 Alplast
32-32x3,0 Alplast

ASK
30. apríl 2015
ASK

SKIPALÓN 23

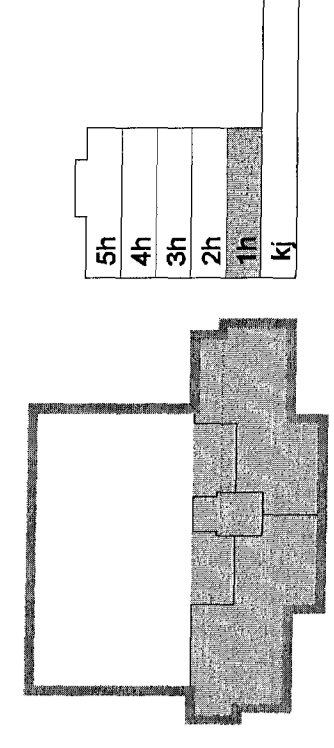

B. 17.04.15 Stigstísla brygð
A. 20.01.12 Laga lagna brott og skýringum bætt w0
Ug. Dægt. Skýng
Hanna Vífrið
SAS/SAS
BS/SAS



VERKFRÆÐISTOFA

BEIARHRAUN 20 · 220 HAFNARFJÖRÐUR · KENNIT. 71078-2899
vib@vib.is · Sími 595 8600 · Fax 595 8610 · www.vsb.is

Artun sérfræðingur
Sveinn Aki Sveinsson Kt. 230855 5608

SKIPALÓN 23
HAFNARFIRÐI

Yfirsk.	Kvæð.	Stað.	Skil.
Bl.	Bl.	Bl.	Bl.
15.12.2006	06926	P211	Ulfar
			B

Lagnir
Hreimatis- og hitalagnir, Loftþrönging 1. hæð
Grummynd