



Skýringar:
16=16x2,0 Alplast
20=20x2,0 Alplast
25=25x2,25 Alplast
32=32x3,0 Alplast

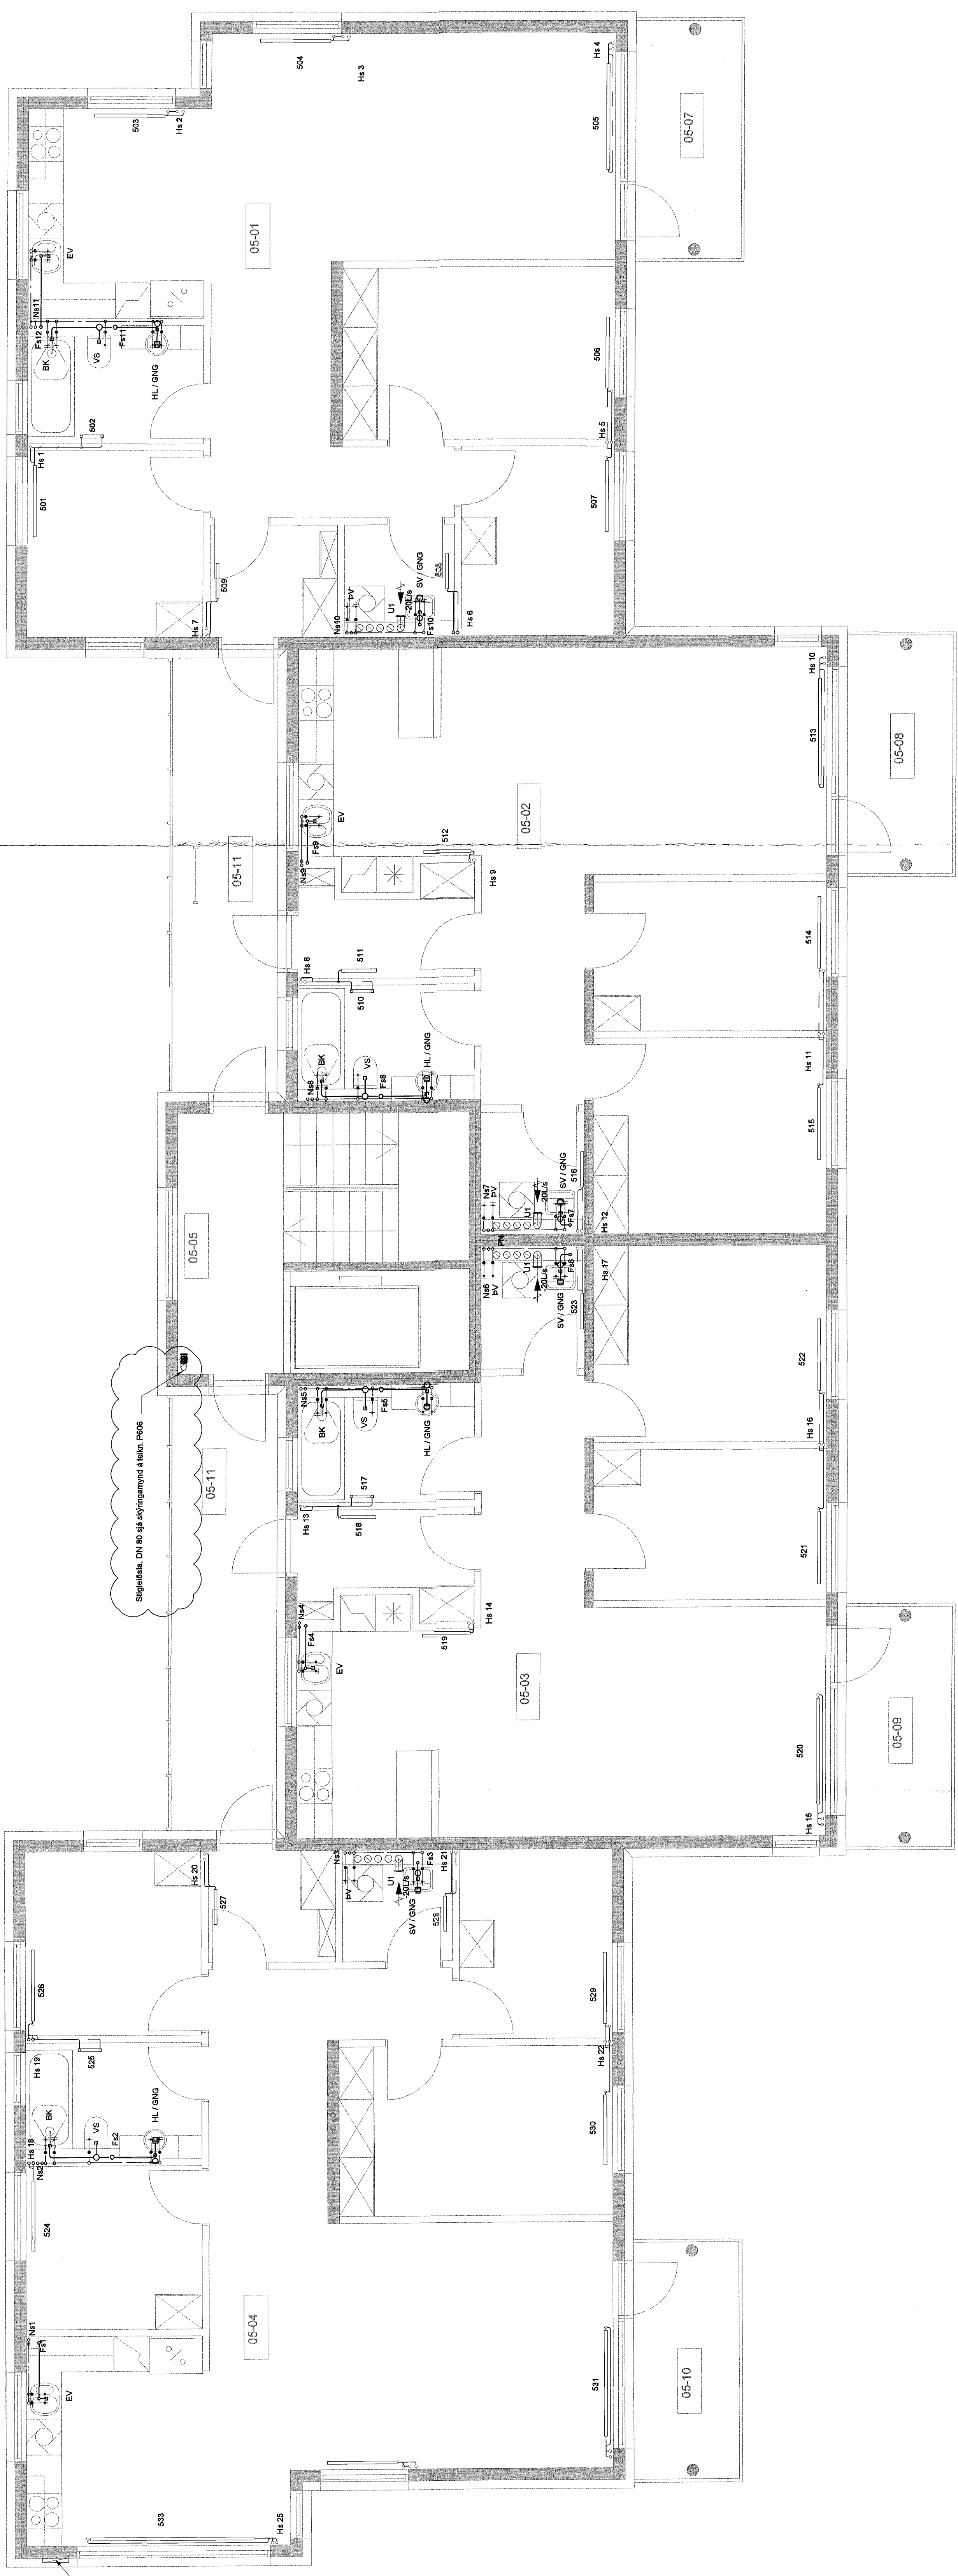

ASK
30. apríl 2015

SKIPALÓN 23

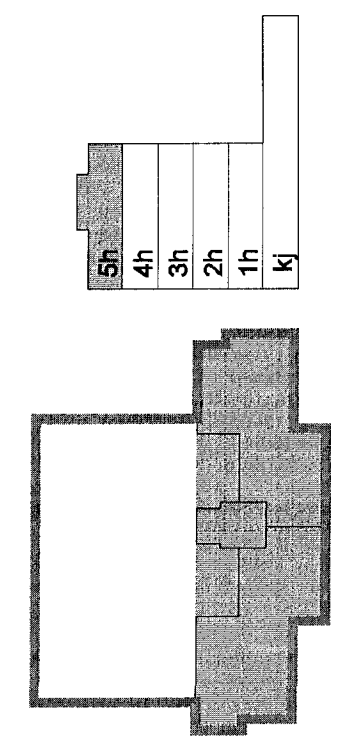

B. 17.04.15 Skjalstafa brott
A. 20.11.14 Laga lagna brott og skýringum bætt úr
Úg. Dagp. Skýring

VSB

VERKFRÆÐISTOFA

BELARHARUN 20 · 220 HAFNARFJÖRÐUR · KENNIT. 710796-2899
vab@vab.is · Sími 585 8600 · Fax 585 8610 · www.vab.is

SKIPALÓN 23
HAFNARFIRÐI
Lagnir
Hreinlætis- og hlalagnir, Loftþræsing 5. hæð
Grummiynd

BL	BL	SAS	SAS	BL	BL
15.12.2006	06926	P231			