


Sampykkt bann

30. júlí 2015

Byggingarfulltrúin í Hafnarfirði  
F.h. Hjálfr S. Gunnlaugsson

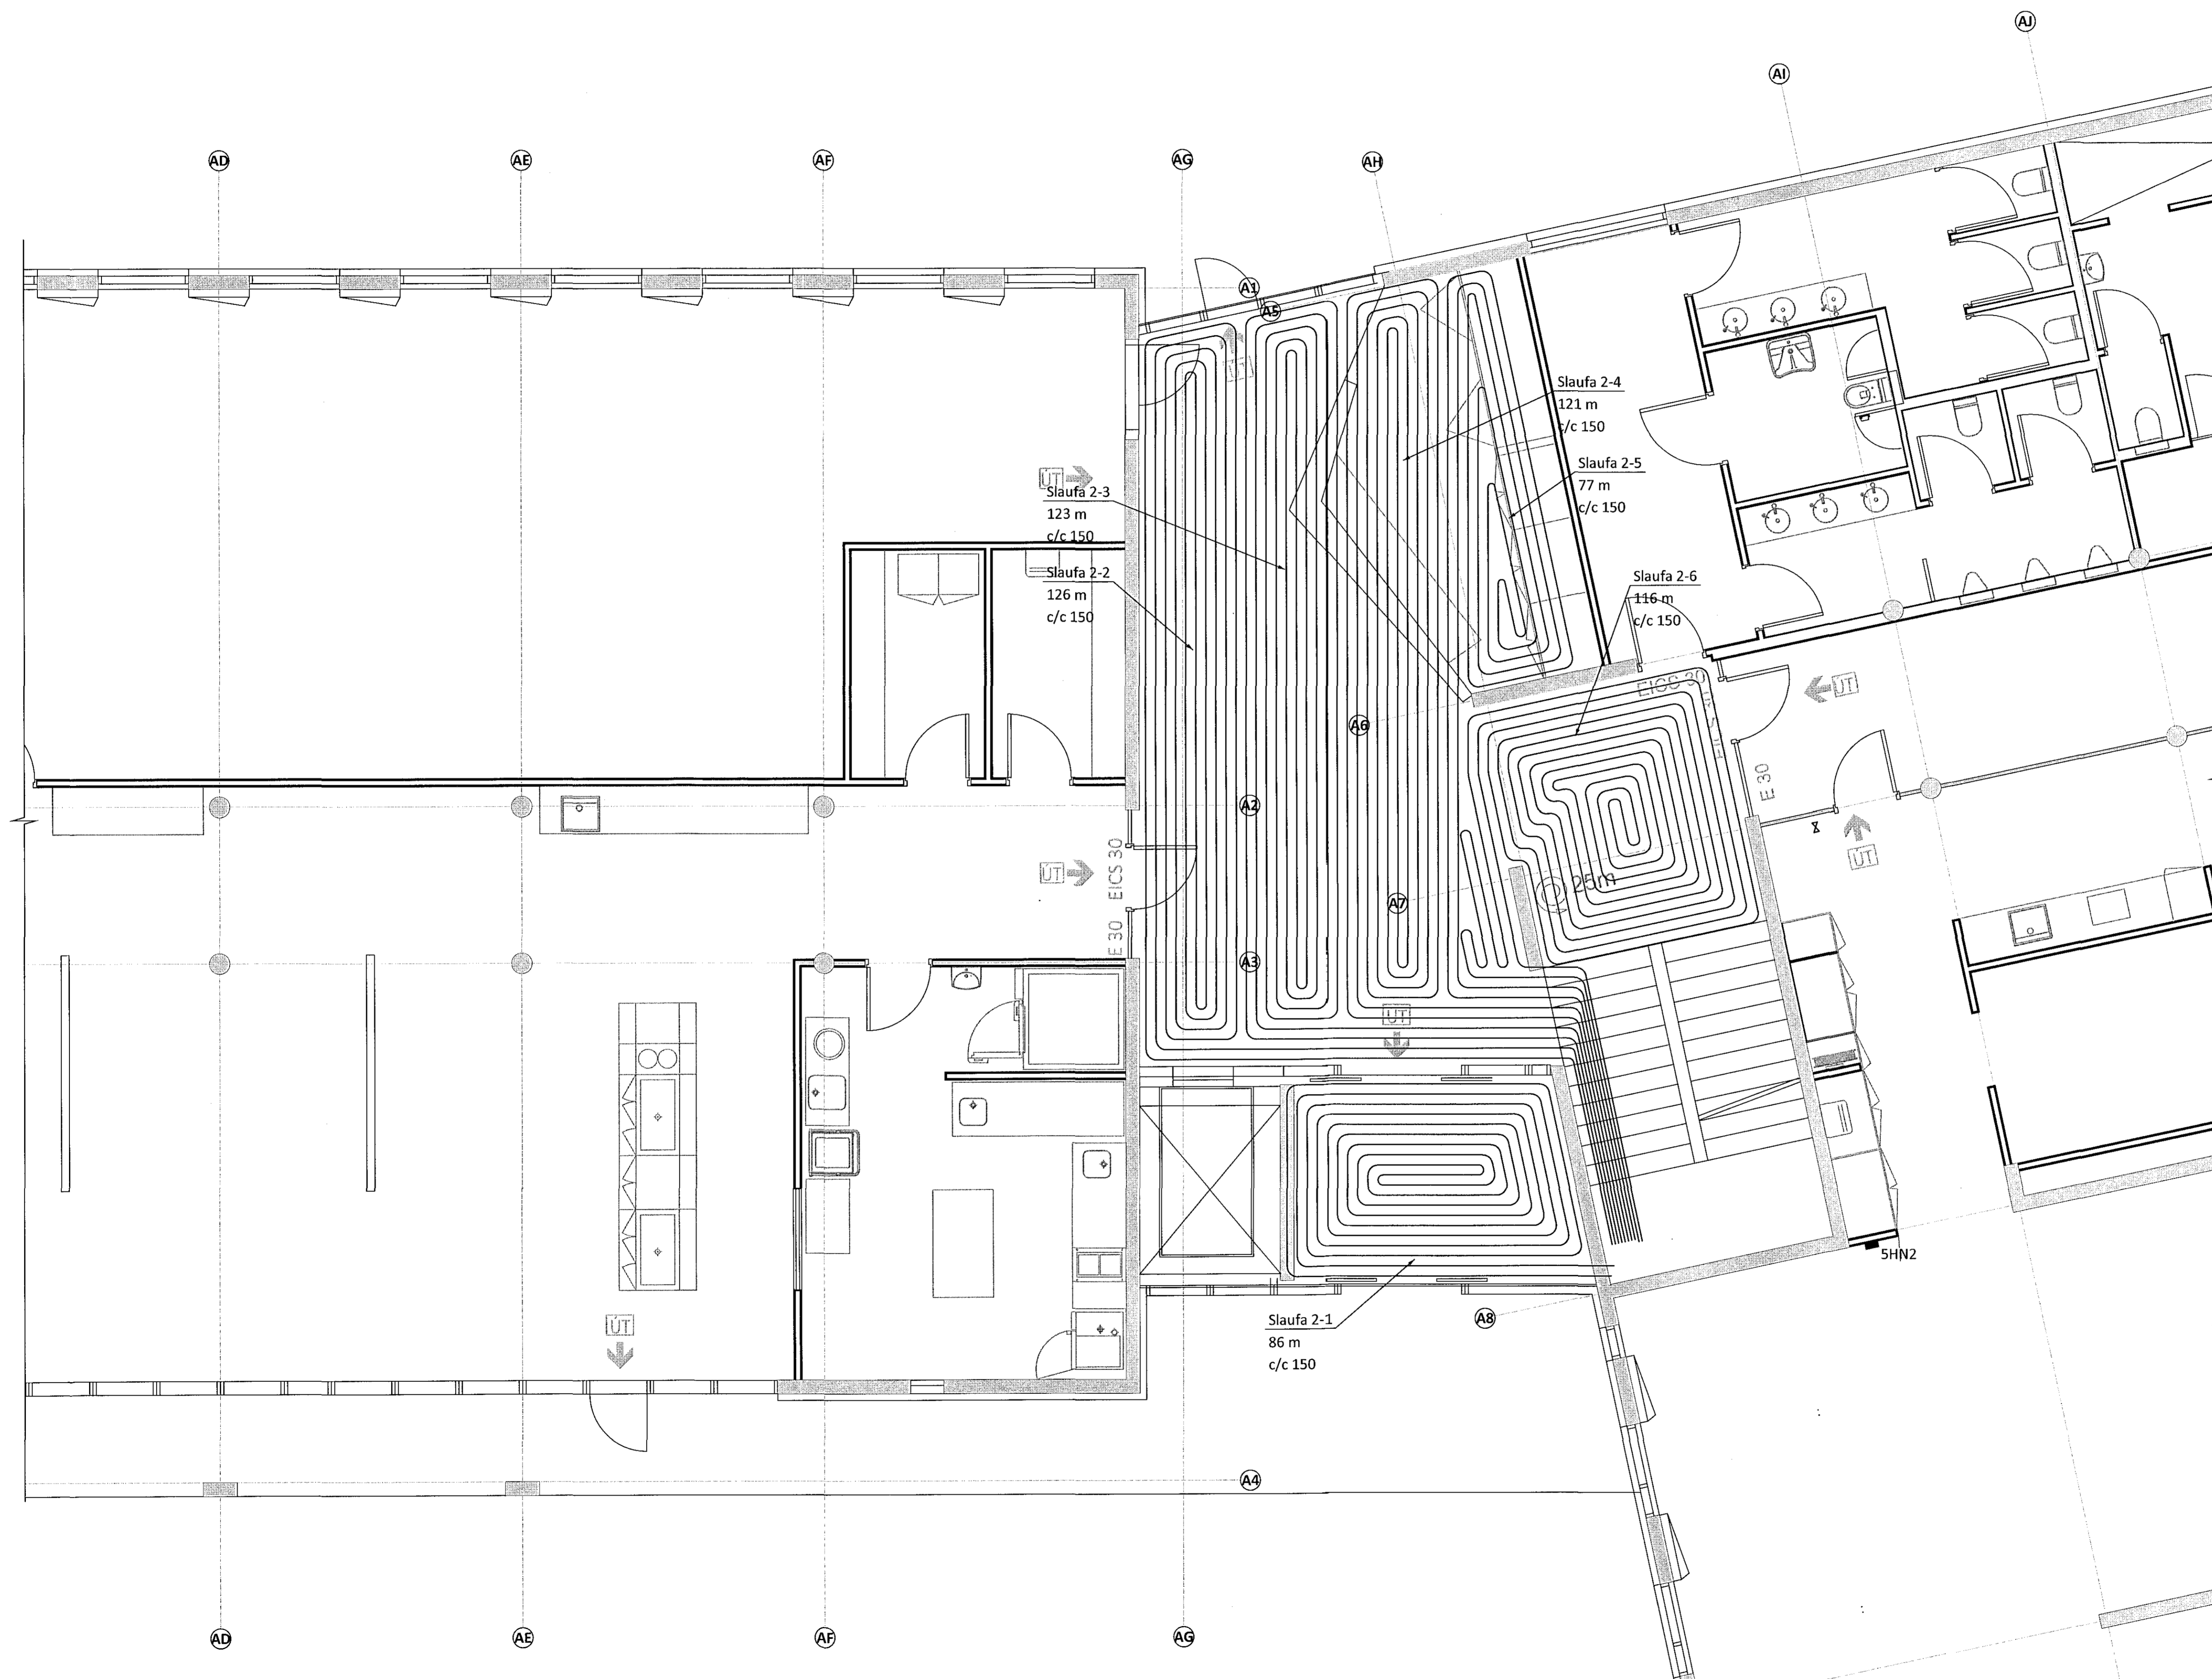



BÚIÐ ER AÐ LEGGJA GÓLFHITALAGNIR

GÓLFHITASKRÁ

Kista 2

SLAUFA NR.	c/c [mm]	AFKÖST [W/m <sup>2</sup> ]	l [m]	STÆRD [m <sup>2</sup> ]	AFKÖST [W]	q [l/min]
2-1	150	70.0	86.0	12.9	903	1.87
2-2	150	70.0	126.0	18.9	1323	2.74
2-3	150	70.0	123.0	18.45	1292	2.67
2-4	150	70.0	121.0	18.15	1271	2.63
2-5	150	70.0	77.0	11.55	809	1.67
2-6	150	70.0	116.0	17.4	1218	2.52
SAMTALS			649 m		6.8 kW	14.09 l/min

LYKILMYND

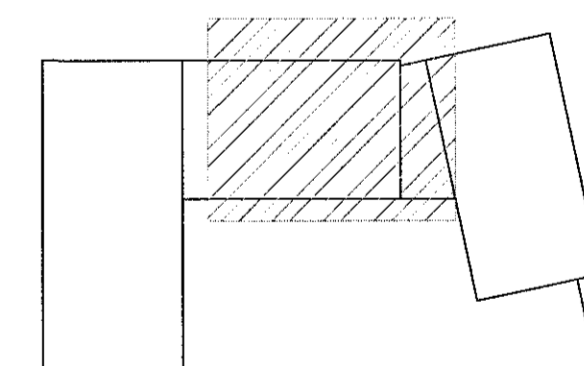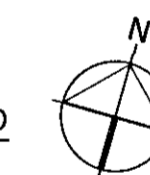

ÁRITUN BYGGINGARFULLTRÚA KT. 24.12.15-30.15

ALMENNAR SKÝRINGAR SJÁ TEIKNINGAR -3-A001


A 27.04.15 HÖNNUN FYRIR STEYPA BYGGINGU  
BR. DAGS. BREYTING SAMP.



**FLUGVELLIR 1** HAFNARFIRÐI  
NÝBYGGING  
HITA- OG PRÍFAKERFI  
1. HÆÐ GRUNNMYND  
GÓLFHITALAGNIR

SAMPYKKT:	KT. 121260-4.680		
HÖNNUÐUR	YFIRFARIÐ	DAGS. ÚTG.	DAGS. BREYT.
HPV hjakti@ferill.is	PAG	10.11.14	27.04.15
MKV. 1:50	VERKNR. 14014	TEIKN. NR. 3-1107	BREYT. A

Ferill ehf Mörkin 1 108 Reykjavík Sími: 575 1600 Fax: 575 1601 www.ferill.is