


SÍÁ TEKNINGU P 1002 FYRIR FRAMHALD

LYKILMYND

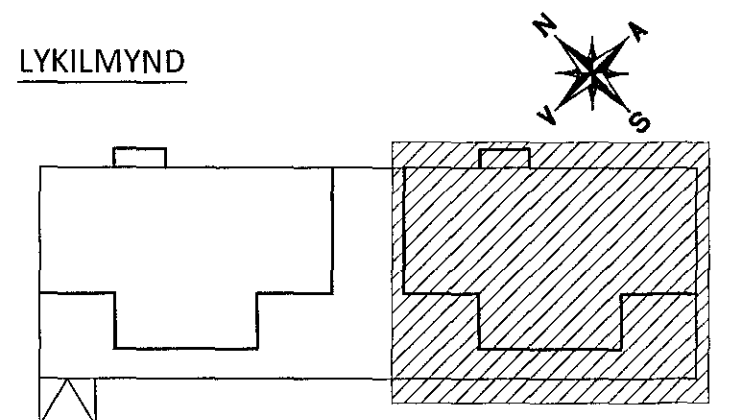

ÁRITUN ADALHÖNNUBAR: *fh* KT.

A 01.10.15 REGNVATNSLAGNIR FÆRDAR INN Í BILAKJALLARA			
BR. DAGS. BREYTING			
ferill VERKFRÆÐISTOFA			
HERJÓLFSGATA 32-34 HAFNARFJÖRDUR			
FJÖLBÝLISHÚS			
LAGNIR KJALLARI GRUNNMYND			
SAMÞYKKT Á <i>Þor Gunnarsson</i> 276760-4229 <i>DAG</i>			
HÖNNUBAR HPV hjalti@ferill.is	YFIRFARIB PAG	DAGS. ÖTG. 05.05.15	DAGS. BREYT. 01.10.15
MKV. 1:50	VERKNR. 14103	TEIKN. NR. P 1003	BREYT. A
Ferill ehf. Mörkin 1 108 Reykjavík Sími: 575 1600 Fax: 575 1601 www.ferill.is			