



ÁRTUN HÖNNUNARSTJÓRNAR
 DAGSETNINGARÁLLPERIÓTTAR
 29.07.2015

HÖNNUNARSTIG: VERKTEIKNING

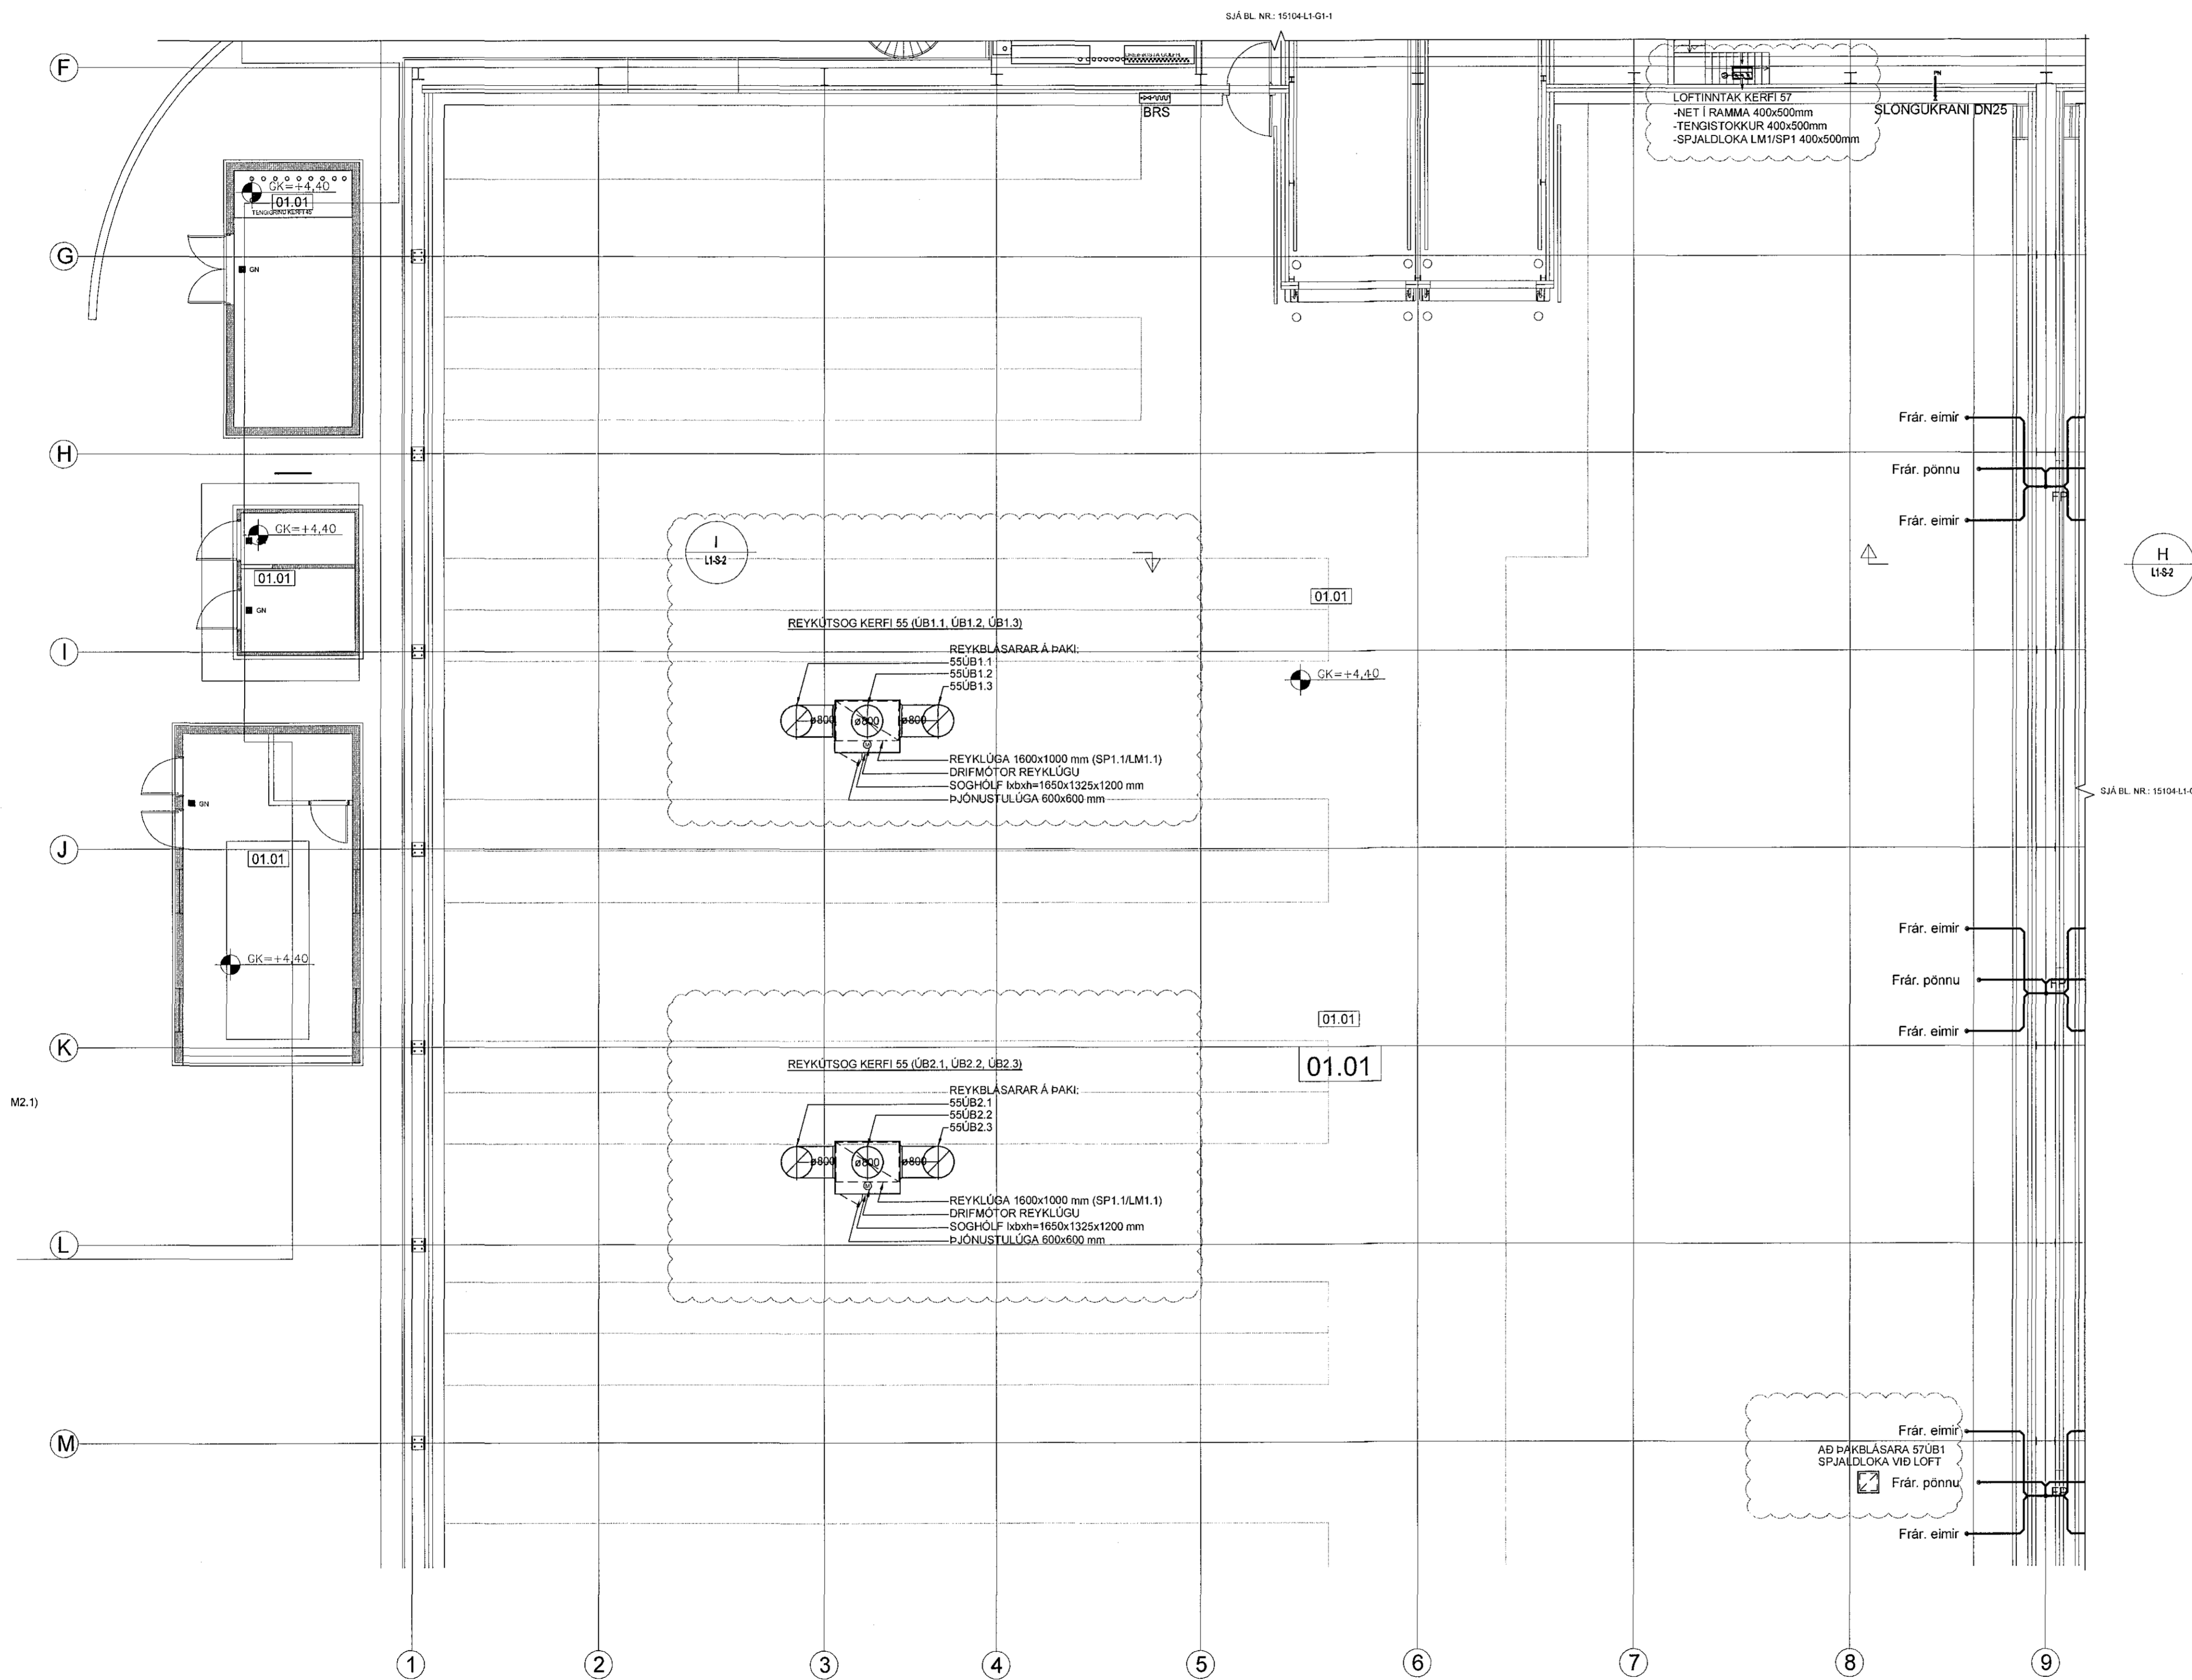

TILVÍSANIR:
 ALMENNAR SKÝRINGAR SJÁ BL. NR.: L1-A-1

B	03.11.2015	LOFTR. KERFI 55.57 BÆTT VÍÐ	KH	PH
A	15.06.2015	VERKTEIKNING	GA	PH
BR	DAGS	BREYTING	REKIN	TEKIN

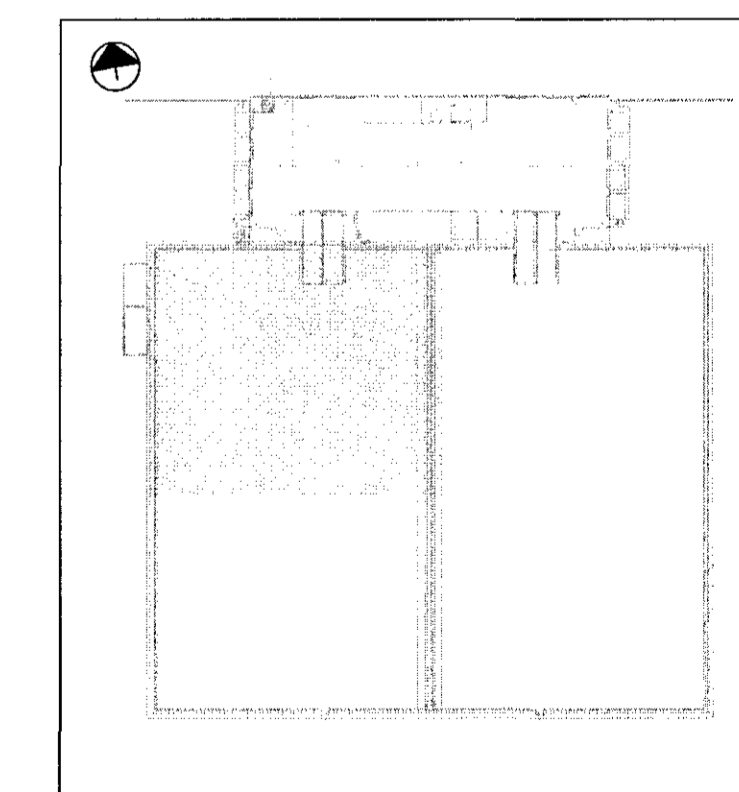

VSÓ RÁÐGJÖF
BORGARTÚN 20, 105 REYKJAVÍK, Sími 595 9000, Sími 595 9010, Netfang vsgj@vsol.is

ÓSEYRARBRAUT 22
 FRYSTIGEYMSLA EIMSKIPS

ÞRIFA-, HITA OG LOFTRÆSIKERFI
 1-2. HÆÐ
 GRUNNMYND

KV. NR. 1:100
 VERNR. 15104
 TEKIN NR. L1-G1-3
 REYKJAVÍK 06.03.2015
 B

