


Samþykkt þann
04 FEB 2016
 Byggingafulltrúinn / Hafnarfróð
 F.h. Sigurður Steinar Jónsson

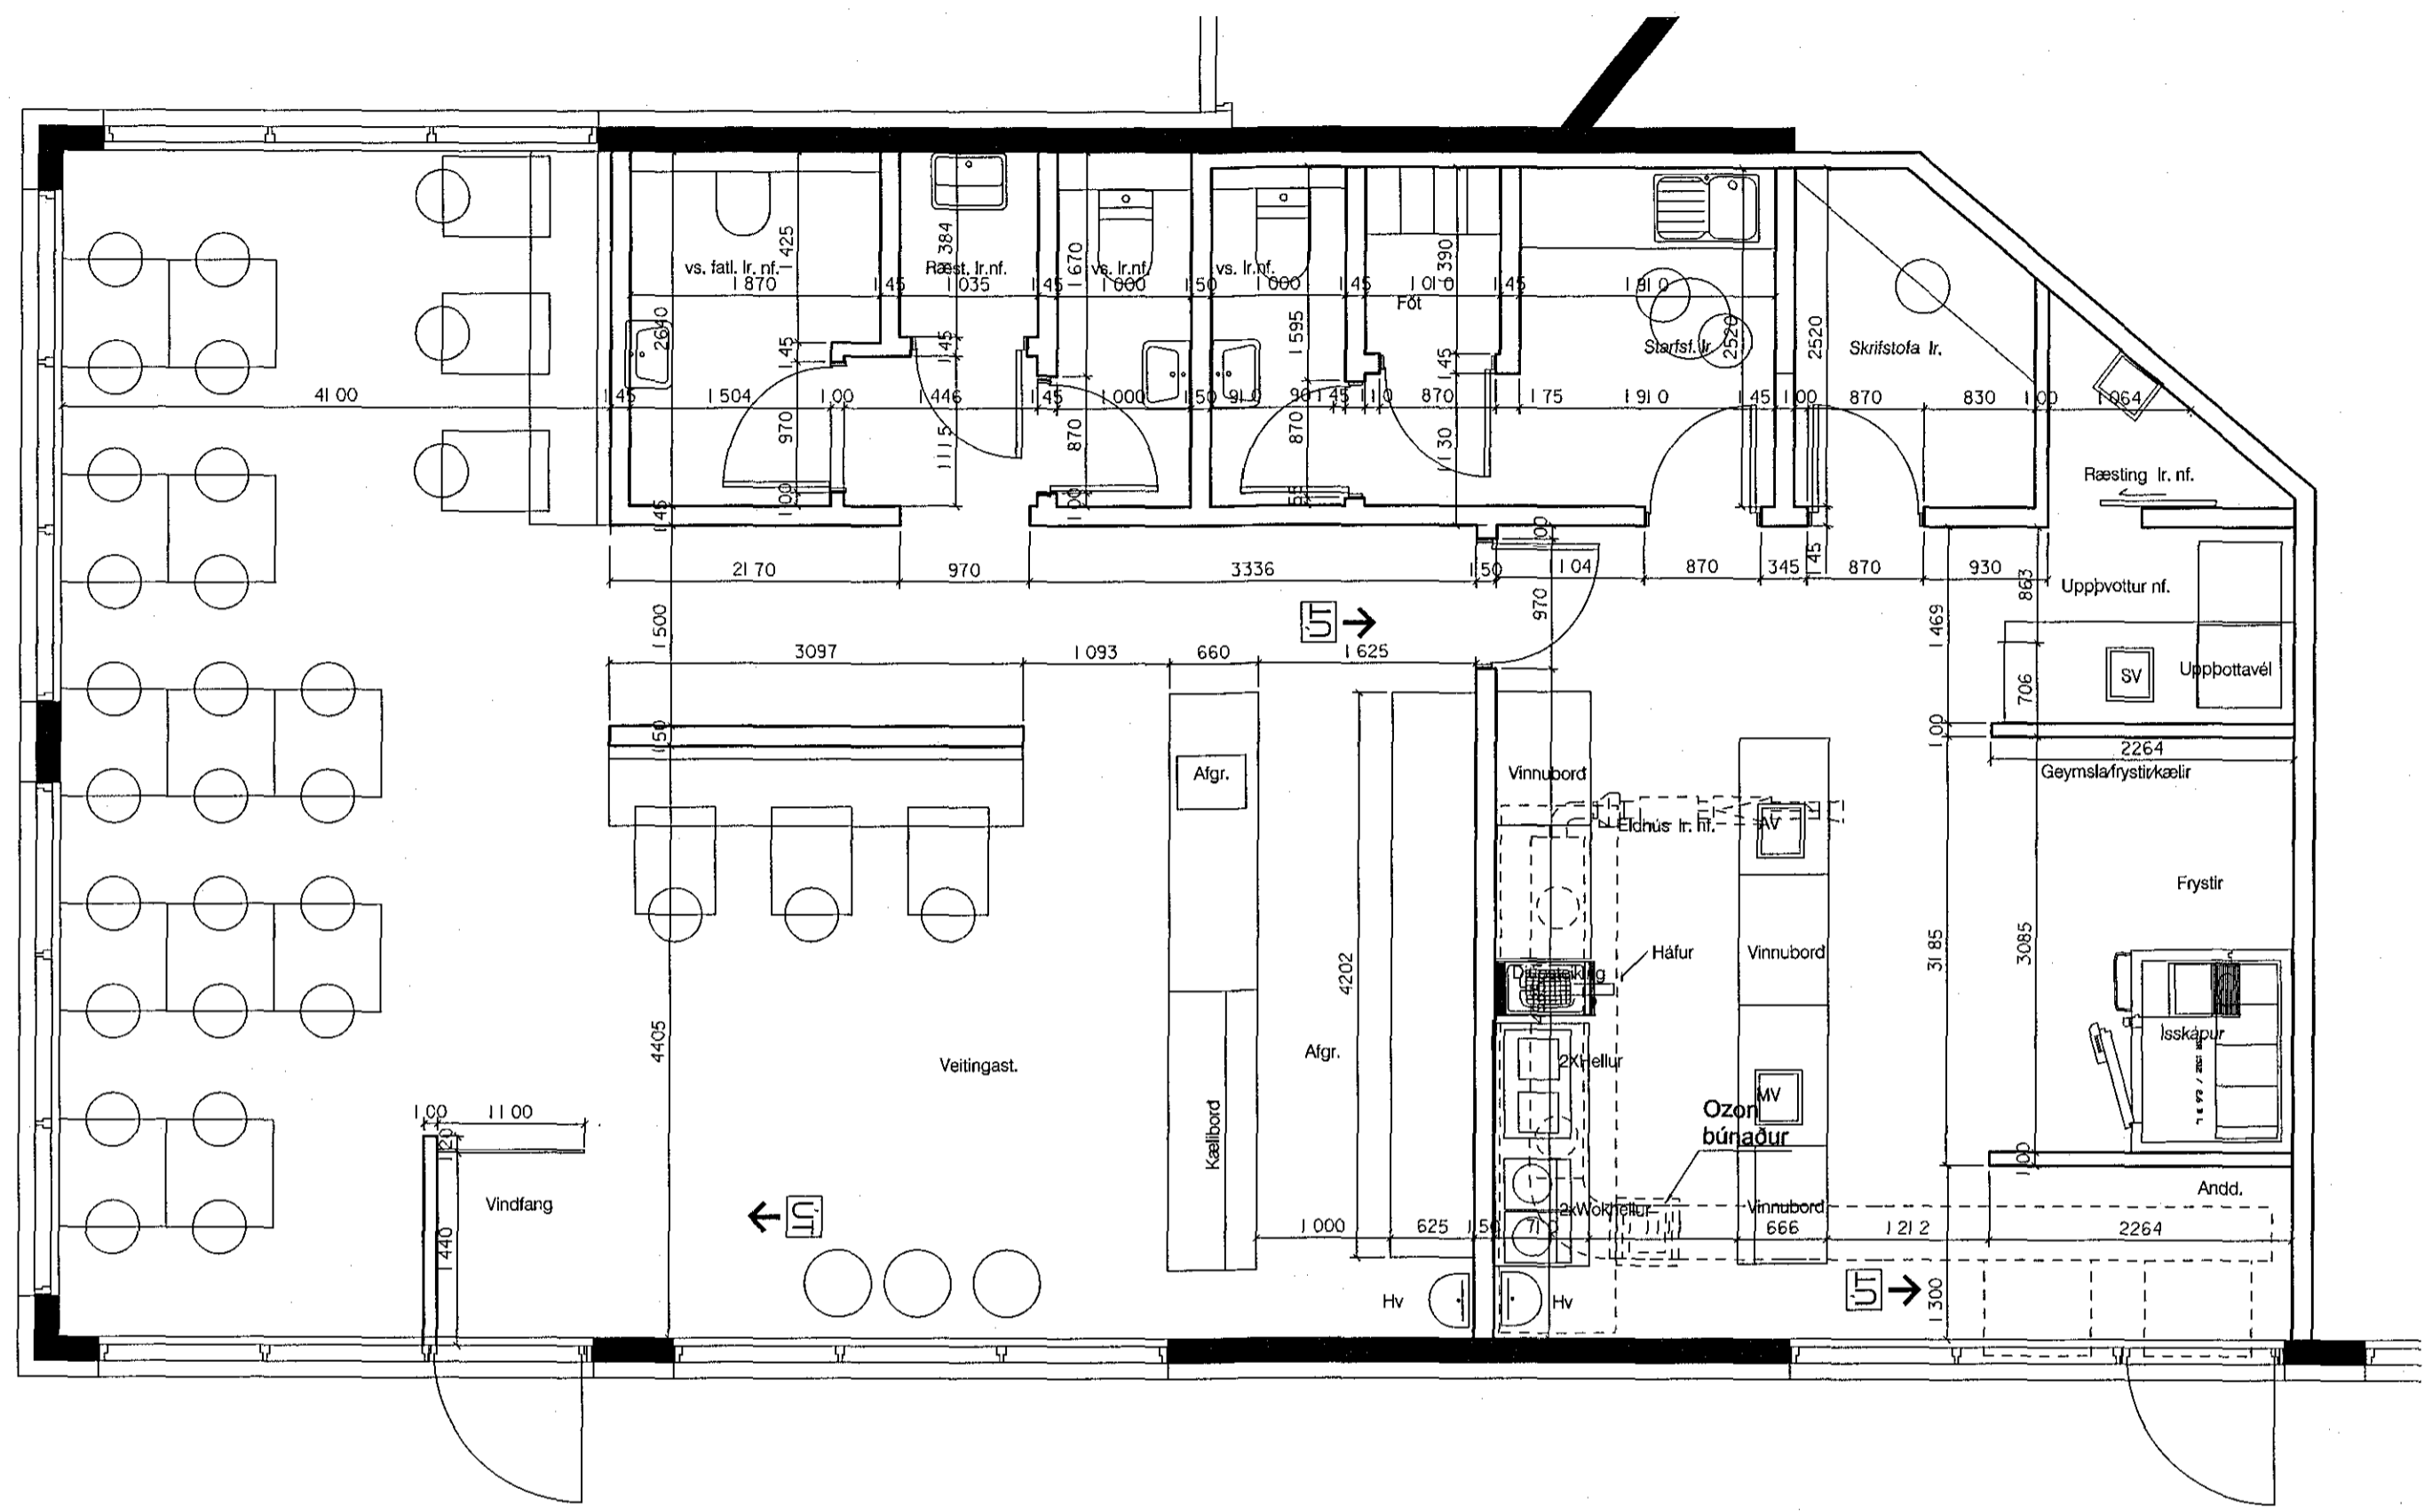

Verkefni: Fjardargata 19

Grunnmynd
 Reyndrateikning

Teikning nr. 050
 Mál 1:50
 Dags. 01.02.2016
 Teiknad

Adalstræti 11 101 Reykjavík
 Sími: 5511790 Fax 5622275
 5621790 gpark@gpark.is

Gudni Pálsson Arkitekt FAI
 Kt. 291246-4519