


Samþykkt þann
 15 MAR 2016
 Byggingafulltrúi / Hafnarfjarðar
 F.h. Sigurður Steinar Jónsson

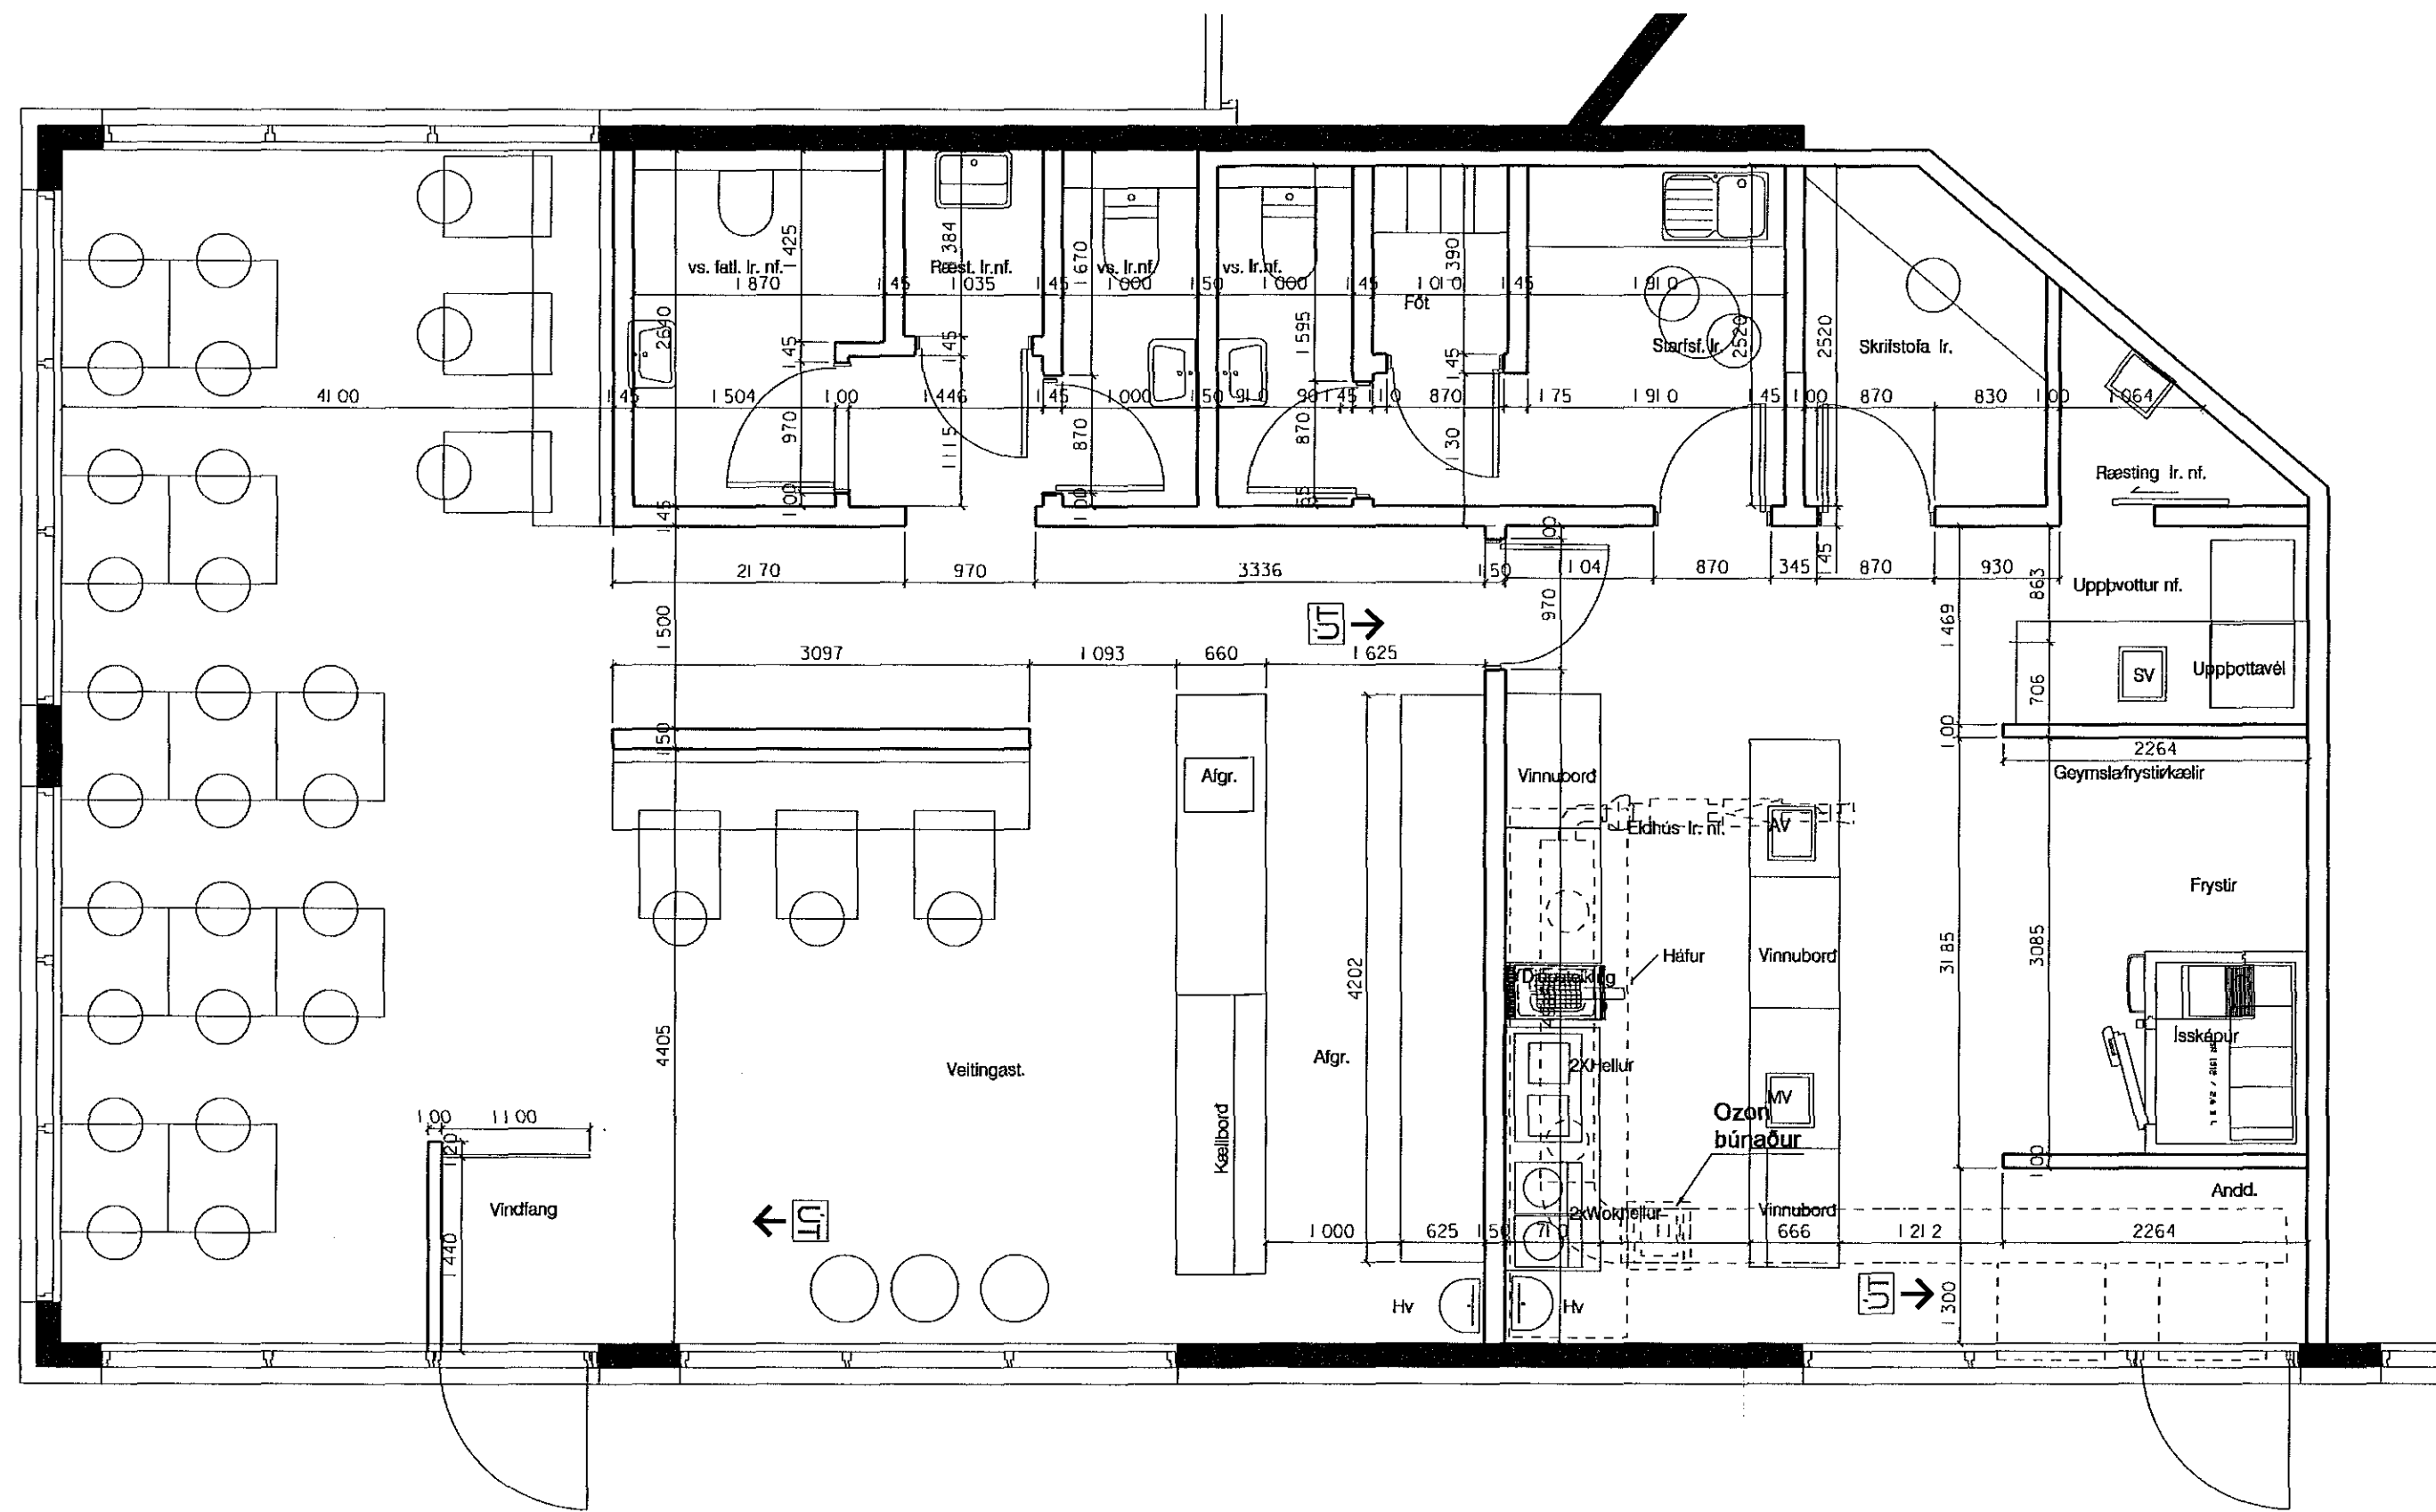

GP ARKITEKTAR

Verkefni: Fjardargata 19

Grunnmynd
 Reyndrateikning

Teikning nr. 050
 Mál 1:50
 Dags. 01.02.2016
 Teiknad

Adalstræti 11 101 Reykjavík
 Sími: 5511790 Fax 5622275
 5621790 gpark@gpark.is
 Góðni Pálsson Arkitekt FAI
 Kt. 291246-4519



Digitally signed by Gunnar H Kristjánsson
 DN: cn=Gunnar H Kristjánsson, o=Iceland, ou=GPARK ARKITEKTAR, email=g.gunnarbrun@gmail.com
 Reason: I have reviewed this document
 Location
 Date: 2016-02-24 09:16Z

