

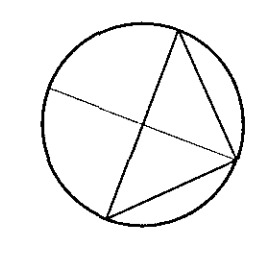


Samþykkt þann
15 MAR 2016
 Byggingafulltrúinn í Hafnarfríð
 F.h. Sigurður Steinar Jónsson

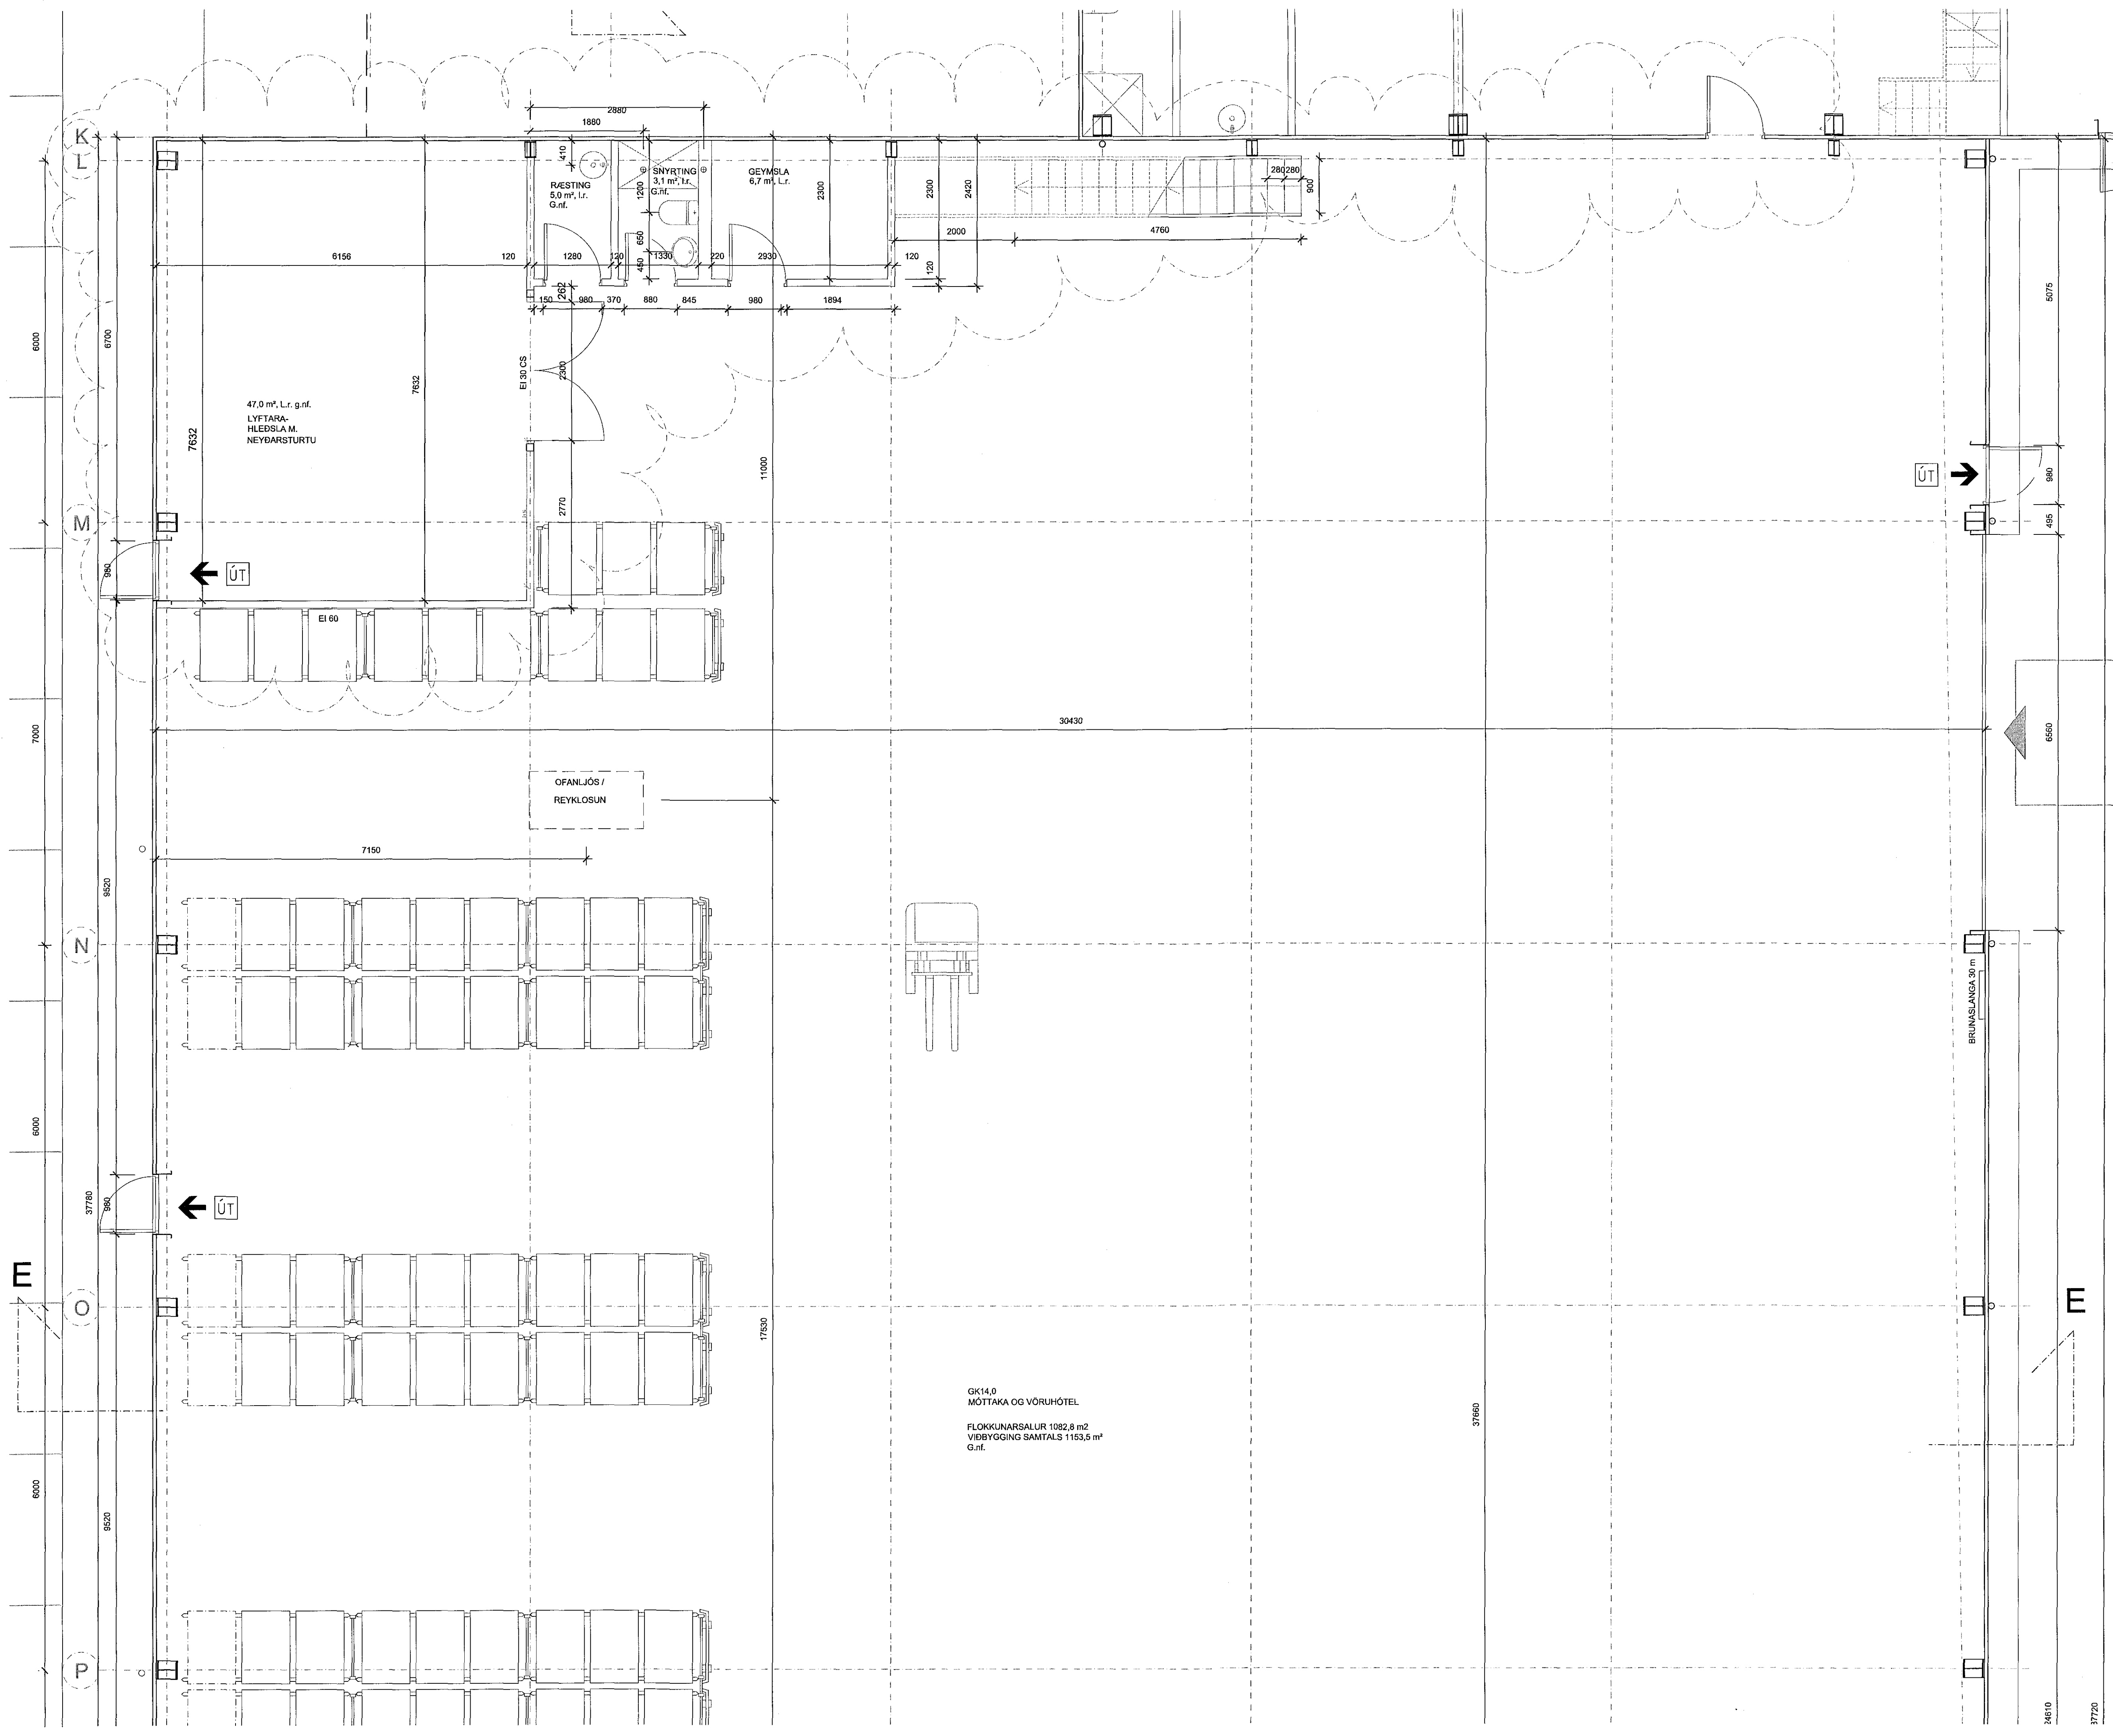

GRUNNMYND 1. HÆÐ, M: 1:50
 N.B. Öll gatmál eru kammál.

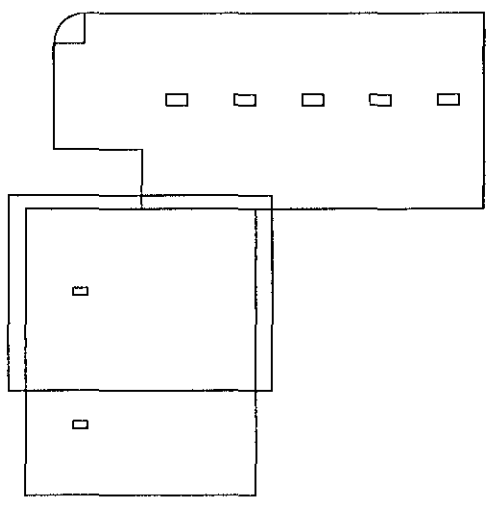

BREYTINGAR

NR.	DAGS.	BREYTING	SP.

TEKTON
 HÖNNUN - SKIPULAG - RÁÐGJÖF

BORGARTÚN 6 TEL: +354 561 1910
 105 REYKJAVÍK FAX: +354 561 1921
 ICELAND TEKTON@TEKTON.IS
 KT: 471293-2109 WWW.TEKTON.IS
 HAUKUR HARBÁRSON ARKIT. FAÍ / FSSA KT: 221182-2269
 GUÐM. HUGI GUÐMUNDSSON KT: 211066-5129
 GUNNLAUGUR JÓNASSON ARKIT. KT: 090462-2299
 ÞORLEIFUR EGGERTSSON ARKIT. KF: 0405653-4849

SAMÞYKKT
 VERK
 HRÁÐFLÚTNINGAR / FEDEX
 SELHELLA 9

TEIKNING
 VIÐBYGGING GRUNNMYND 1 HÆÐ 3. HLUTI

KVARDI
 1:50

DAGS.
 13.03.2016
 TEIKNAD AF
 GJ

TEIKNING NR.

A0211

GK14.0
 MÖTTAKA OG VÖRUHÓTEL
 FLOKKUNARSALUR 1082,8 m²
 VIÐBYGGING SAMTALS 1153,5 m²
 G.nf.

37660

24810

37720