


2/3 16 160 23 23

Grunnmynd 1:50

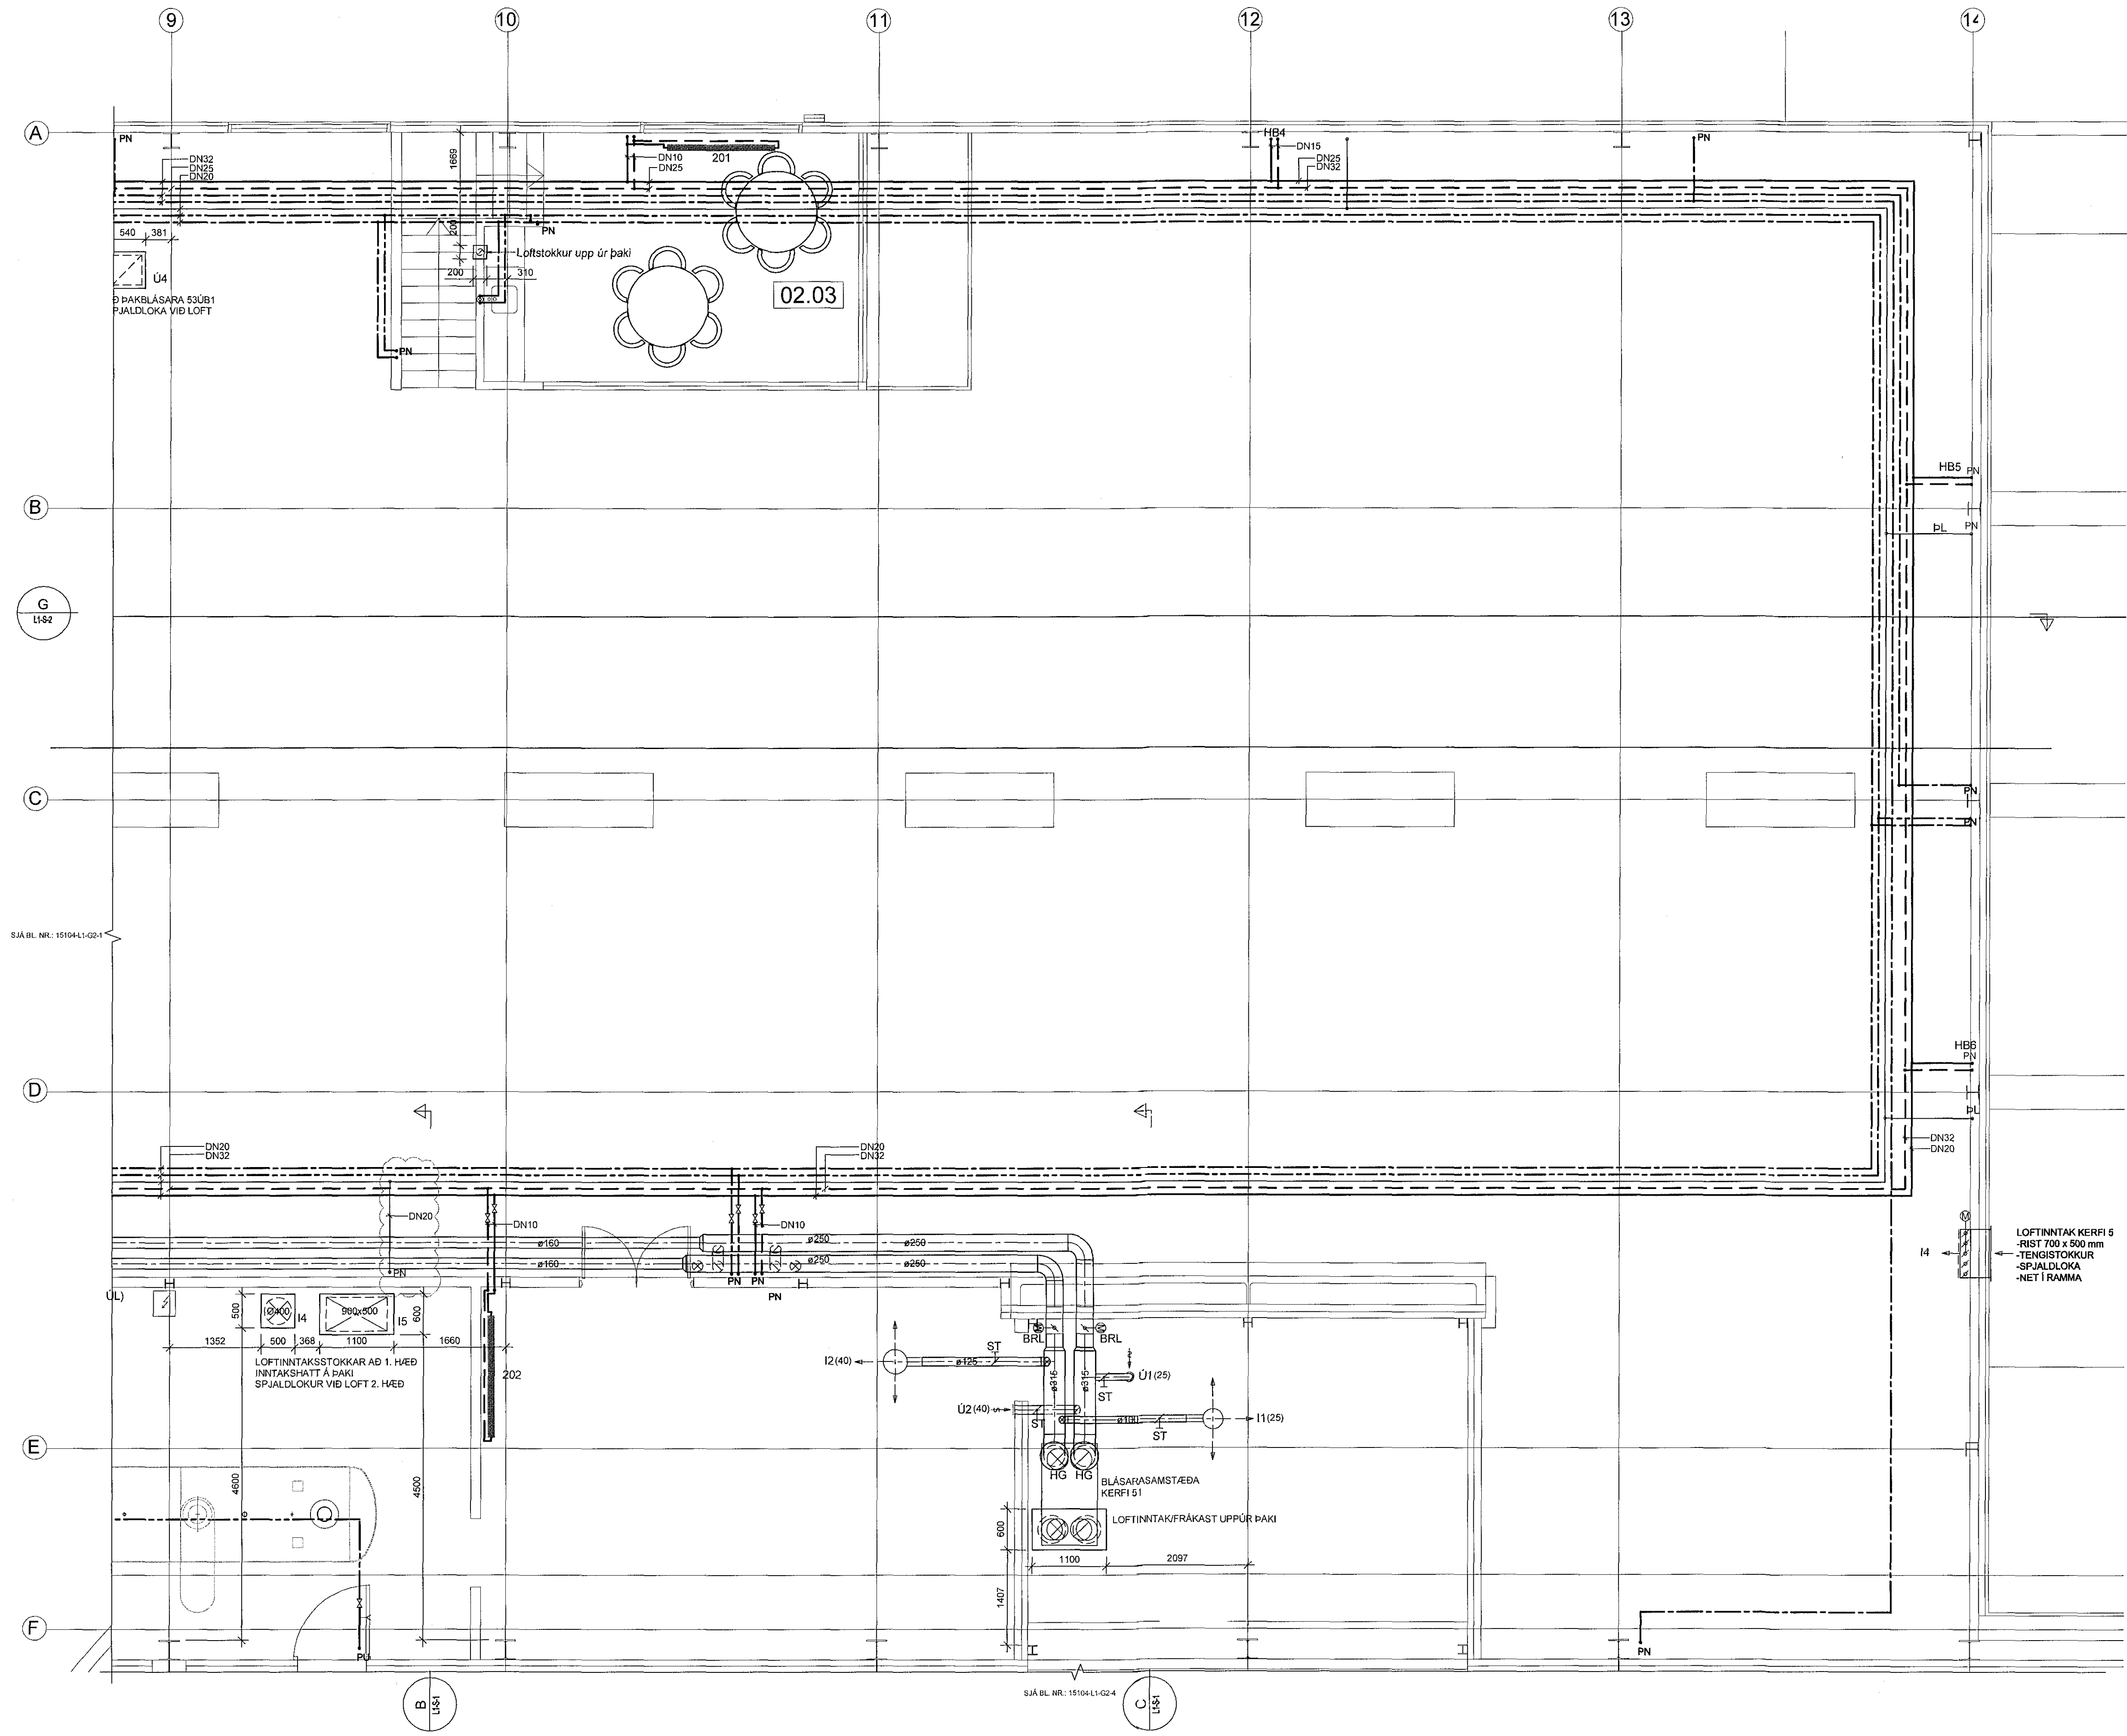


Samþykkt þann
16 MAR 2015
 Þvingingahillirinn (Hafnarvegur)
 Fri. Sigurður Steinar Jónsson

ÁRSTUN HÖNNUNARSTIGS
 DAGSETNING AÐALSPJÓÐARINNAR
23.01.2016

HÖNNUNARSTIG: VERKTEIKNING

TILVÍSANIR:
 ALMENNAR SKYRINGAR SÁL BL. NR.: L1-A-1

C: 17.09.2015	Göt. og úr þakinn	GH	LL
B: 15.09.2015	Meistarar	GA	PH
A: 12.09.2015	Skilríki	GA	PH
BR. DAGS.	BREYTING	REKNI	TEKNI

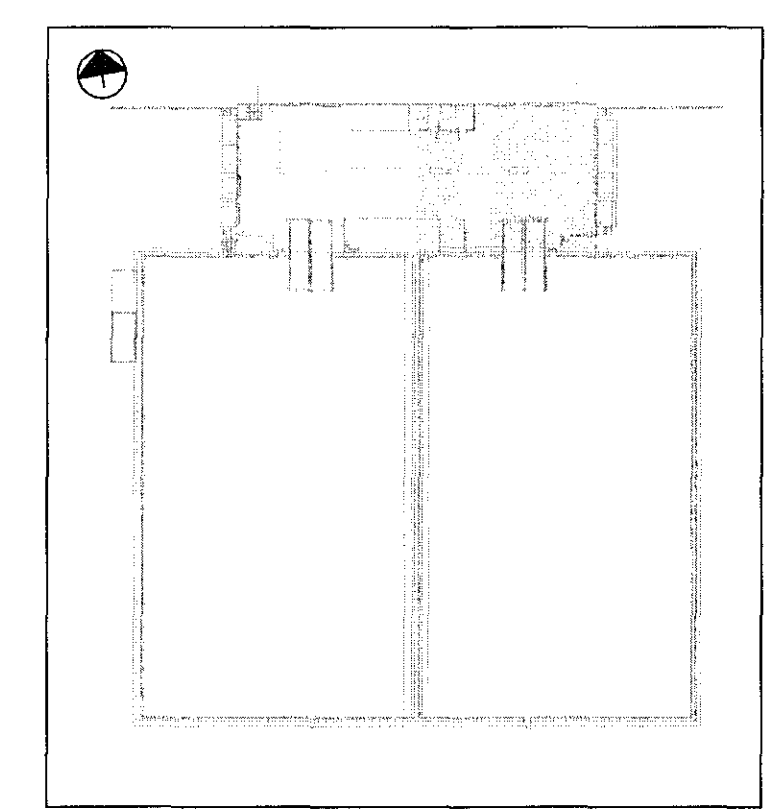

VSÓ RÁÐGJÖF
SKOÐAVATNI 26, 105 REYKJAVÍK, CHL 100 8000, Símanúmer 560 9010, NETFANG netfang@vs.ro.is

ÖSEYRARBRAUT 22
 FRYSTIGEYMSLA EIMSKIPS

ÞRIFA-, HITTA OG LOFTRÆSIKERFI
 2. HÆÐ
 GRUNNMYND

UNNBYRIR
 YFIRFAR
 SÁMRYGGI
 KT.
 HEYKJAVÍK

GA/201
 PH
 PH
 30087-0009
 06.03.2015

KVARNR 1:50
 VERKNR 15104

TEKNI NR. L1-G2-2
 BFL C



S:\015104\15104L1-G2-1-2.dwg