


SIÁ FRAMHALD Á TEIKNINGU -2-0102

LYKILMYND:

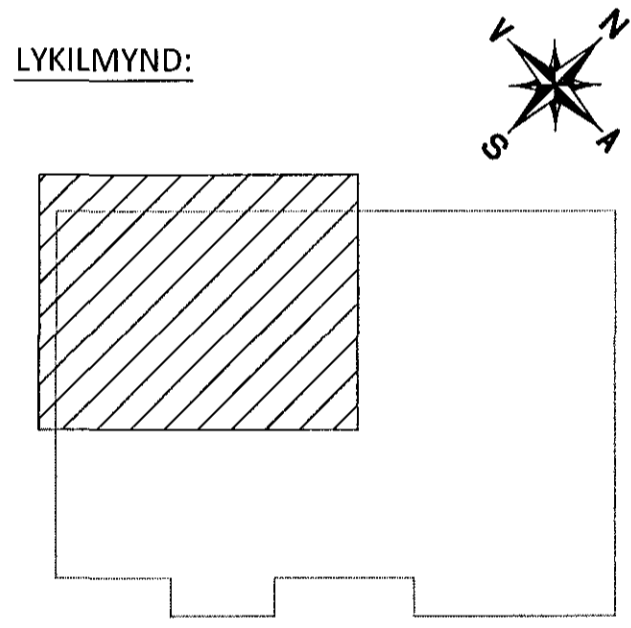

ÁRITUN ÁDALHÖNNUNNDAR: *[Signature]* KT. 230564-4369

C	21.06.16	REYNDARTEIKNING
B	22.01.16	FÆRSLA Á STÚTUM
A	09.09.15	FÆRSLA Á GN OG PN
BR.	DAGS.	BREYTING



FLATAHRAUN 13 HAFNARFJÖRDUR
 NÝBYGGING KRÖNUVERSLUN
 GRUNNLAGNIR
 GRUNNMYND
 1.HLUTI

SAMÞYKKT *[Signature]* 270760-4229 *[Signature]*

HÖNNUNUR	YFIRFARIR	DAGS. ÚTL.	DAGS. BREYT.
GP	gummi@ferill.is	13.07.15	21.06.16
MKV. (A1)	VERKNR.	TEIKN. NR.	BREYT.
1:50	14048	2 - 0101	C