


V:\Flatahraun\13\Teikningar\6-SNJÓBRÆÐSLA\14048-6-1000.dwg

SJÁ FRAMHALD Á TEIKNINGU -6-1002

LYKILMYND

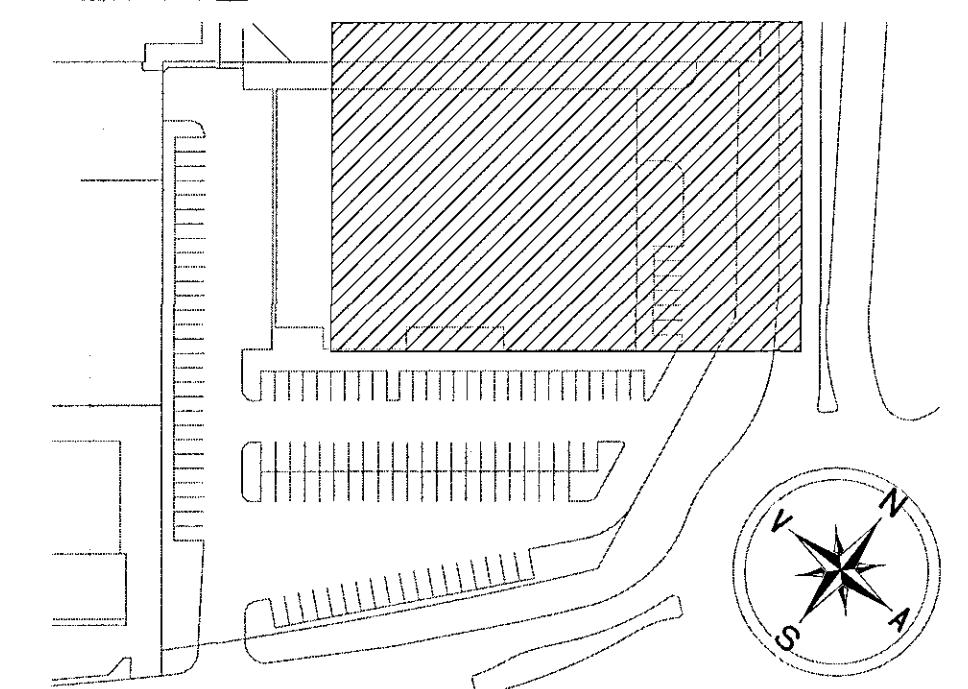

ÁRITUNARFULLTRÚA: *[Signature]*
Kt. 220564-4369

ALMENNAR SKÝRINGAR SJÁ TEIKNINGU NR. -6-001

A	21.06.16	REYNDARTEIKNING	<i>[Signature]</i>
BR.	DAGS.	BREYTING	



FLATAHRAUN 13 HAFNARFJÖRDUR
NÝBYGGING KRÖNUVERSLUN
SNJÓBRÆÐSLA
GRUNNMYND
1. HILUTI

SAMPYKKT: <i>[Signature]</i> KT. 270760-4229 <i>[Signature]</i>			
HÖNNUÐUR	YFIRFARID	DAGS. ÚTG.	DAGS. BREYT.
GP	gummi@ferill.is	DAG	13.11.15
MAX. (A1)	1:100	VERNR.	14048
		TEKNA. NR.	6 - 1001
		BREYT.	A