


Samþykkt þann  
09. mars 2018  
Byggingaálfuráráðgjafi

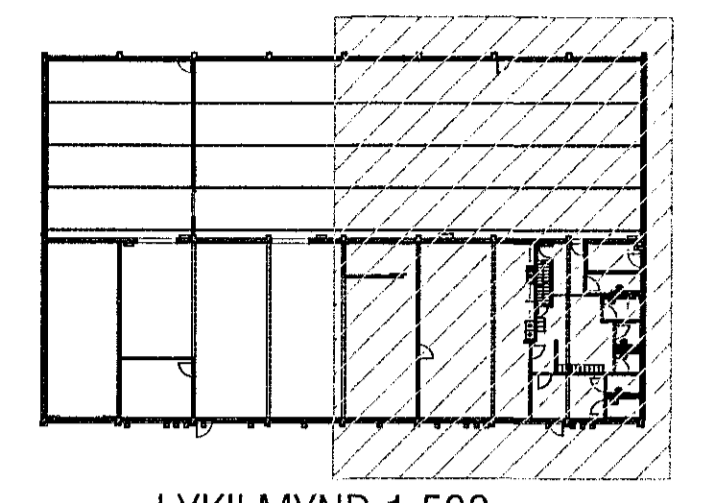

LYKILMYND 1:500

Breyting 20.02.2018  
Loftrásiklefi settur inn. Gluggi á vestrhlö settur inn.

<b>VEKTOR</b> - hönnun og ráðgjöf - Síðumúla 3, 108 Rvk, s: 554-6650 / 897-5363		Sigurður Halsteinsson Byggingaálfuráráðgjafi Húsnúmer 7140 email: sigurdur@vektor.is	
Tekn. nr.: Samþykkt: <i>[Signature]</i>		Dálshraun 6, Hafnarfirdi SÉRTEIKNING GRUNNMYND	
Tölur: 400   4570   400   2340   530   400   250   400   250   400   385   2370   2215   400   400   250   400   250   400   3345		Húsnúmer: SH Vorkr.: MA Dagssetning: 22.03.2017 Málsvæði: 1:50 Tölur: S-02	