



Samþykkt þann  
26 MAJ 2017  
Byggingarfulltrúinn í Hafnarfirði  
F.Þ. Sigurður Steinar Jónsson

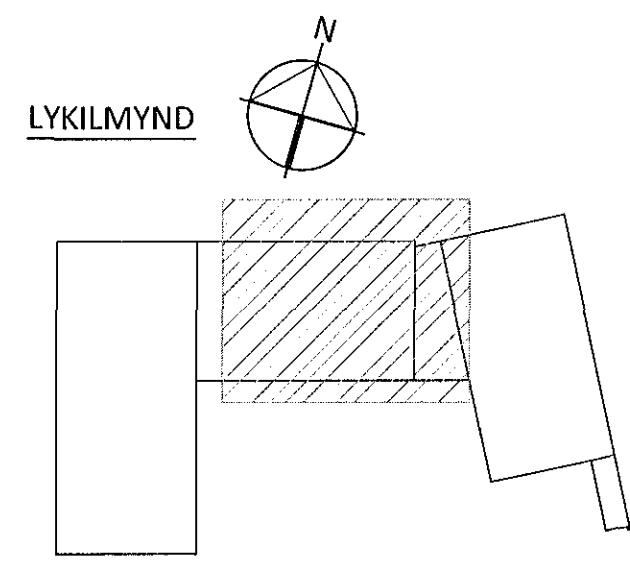

ÁRITUNADALHÖNDUÐAR: *OKS* KT: *01251-2017*

B	13.07.15	LOFTRÆSTISTOKKUM BREYTT	<i>OKS</i>
A	02.06.15	LOFTRÆSTISTOKKUM BREYTT	
BR.	DAGS.	BREYTING	SAMP.

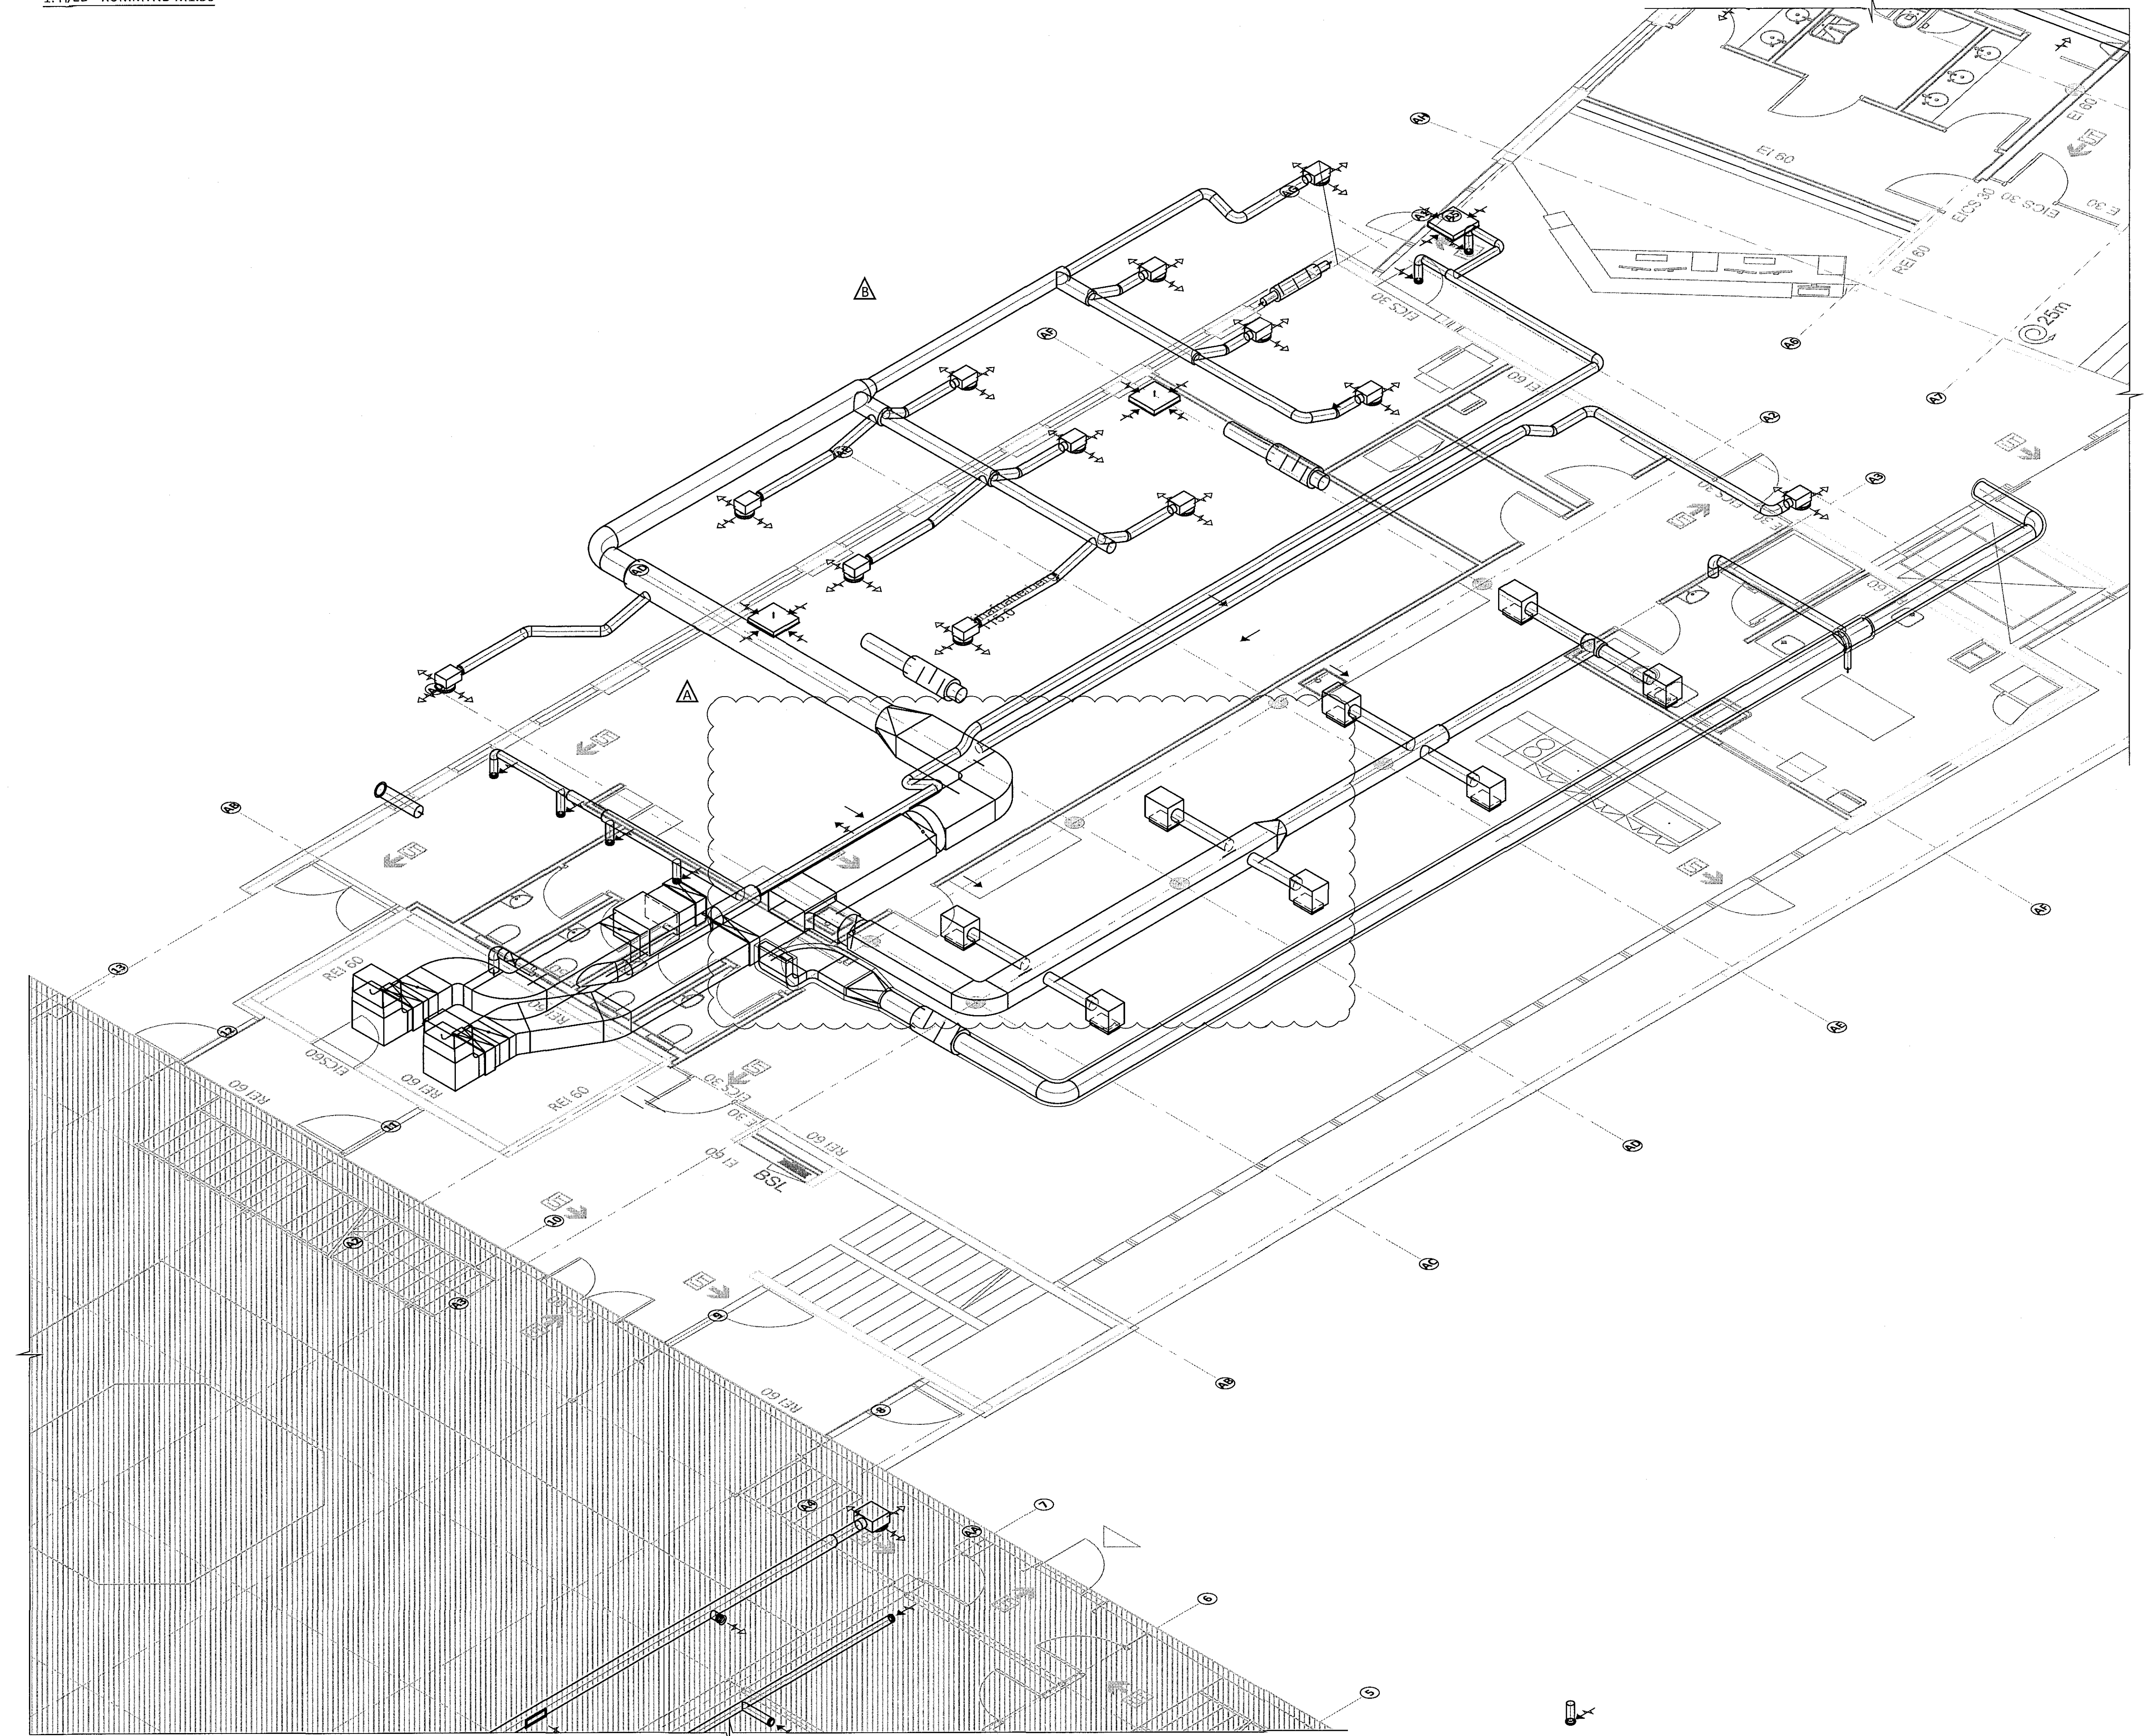

**FLUGVELLIR 1** HAFNARFIRÐI  
NÝBYGGING  
LOFTRÆSING  
1. HÆD  
RÚMMYND

SAMPYKKT:		KT: <i>OKS</i>	
HÖNNUÐUR	YRFARID	DAGS. ÚTG.	DAGS. BREY.
ERV <i>ein@ferill.is</i>	PAG	29.04.15	13.07.15
MKV.	VERKNR.	TEIKN. NR.	BREYTT.
1:50	14014	5 - 1113	B