
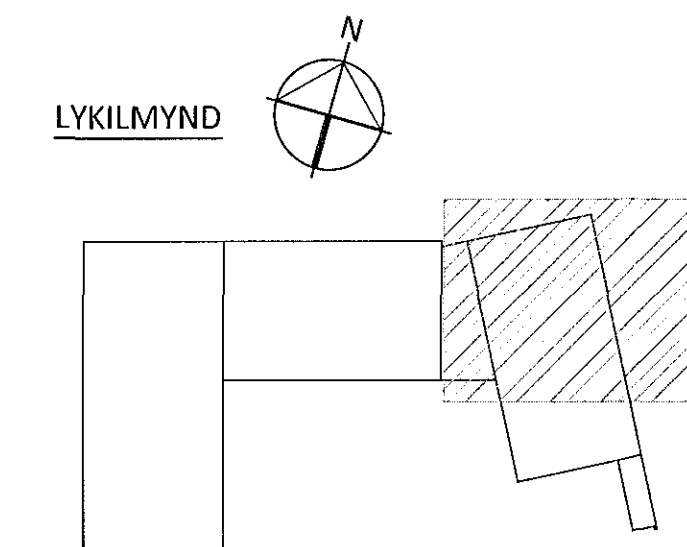


Samþykkt þann
26 MAY 2017
Byggingarfulltrúinn í Hafnarfirði
F.h. Sigurður Steinar Jónsson

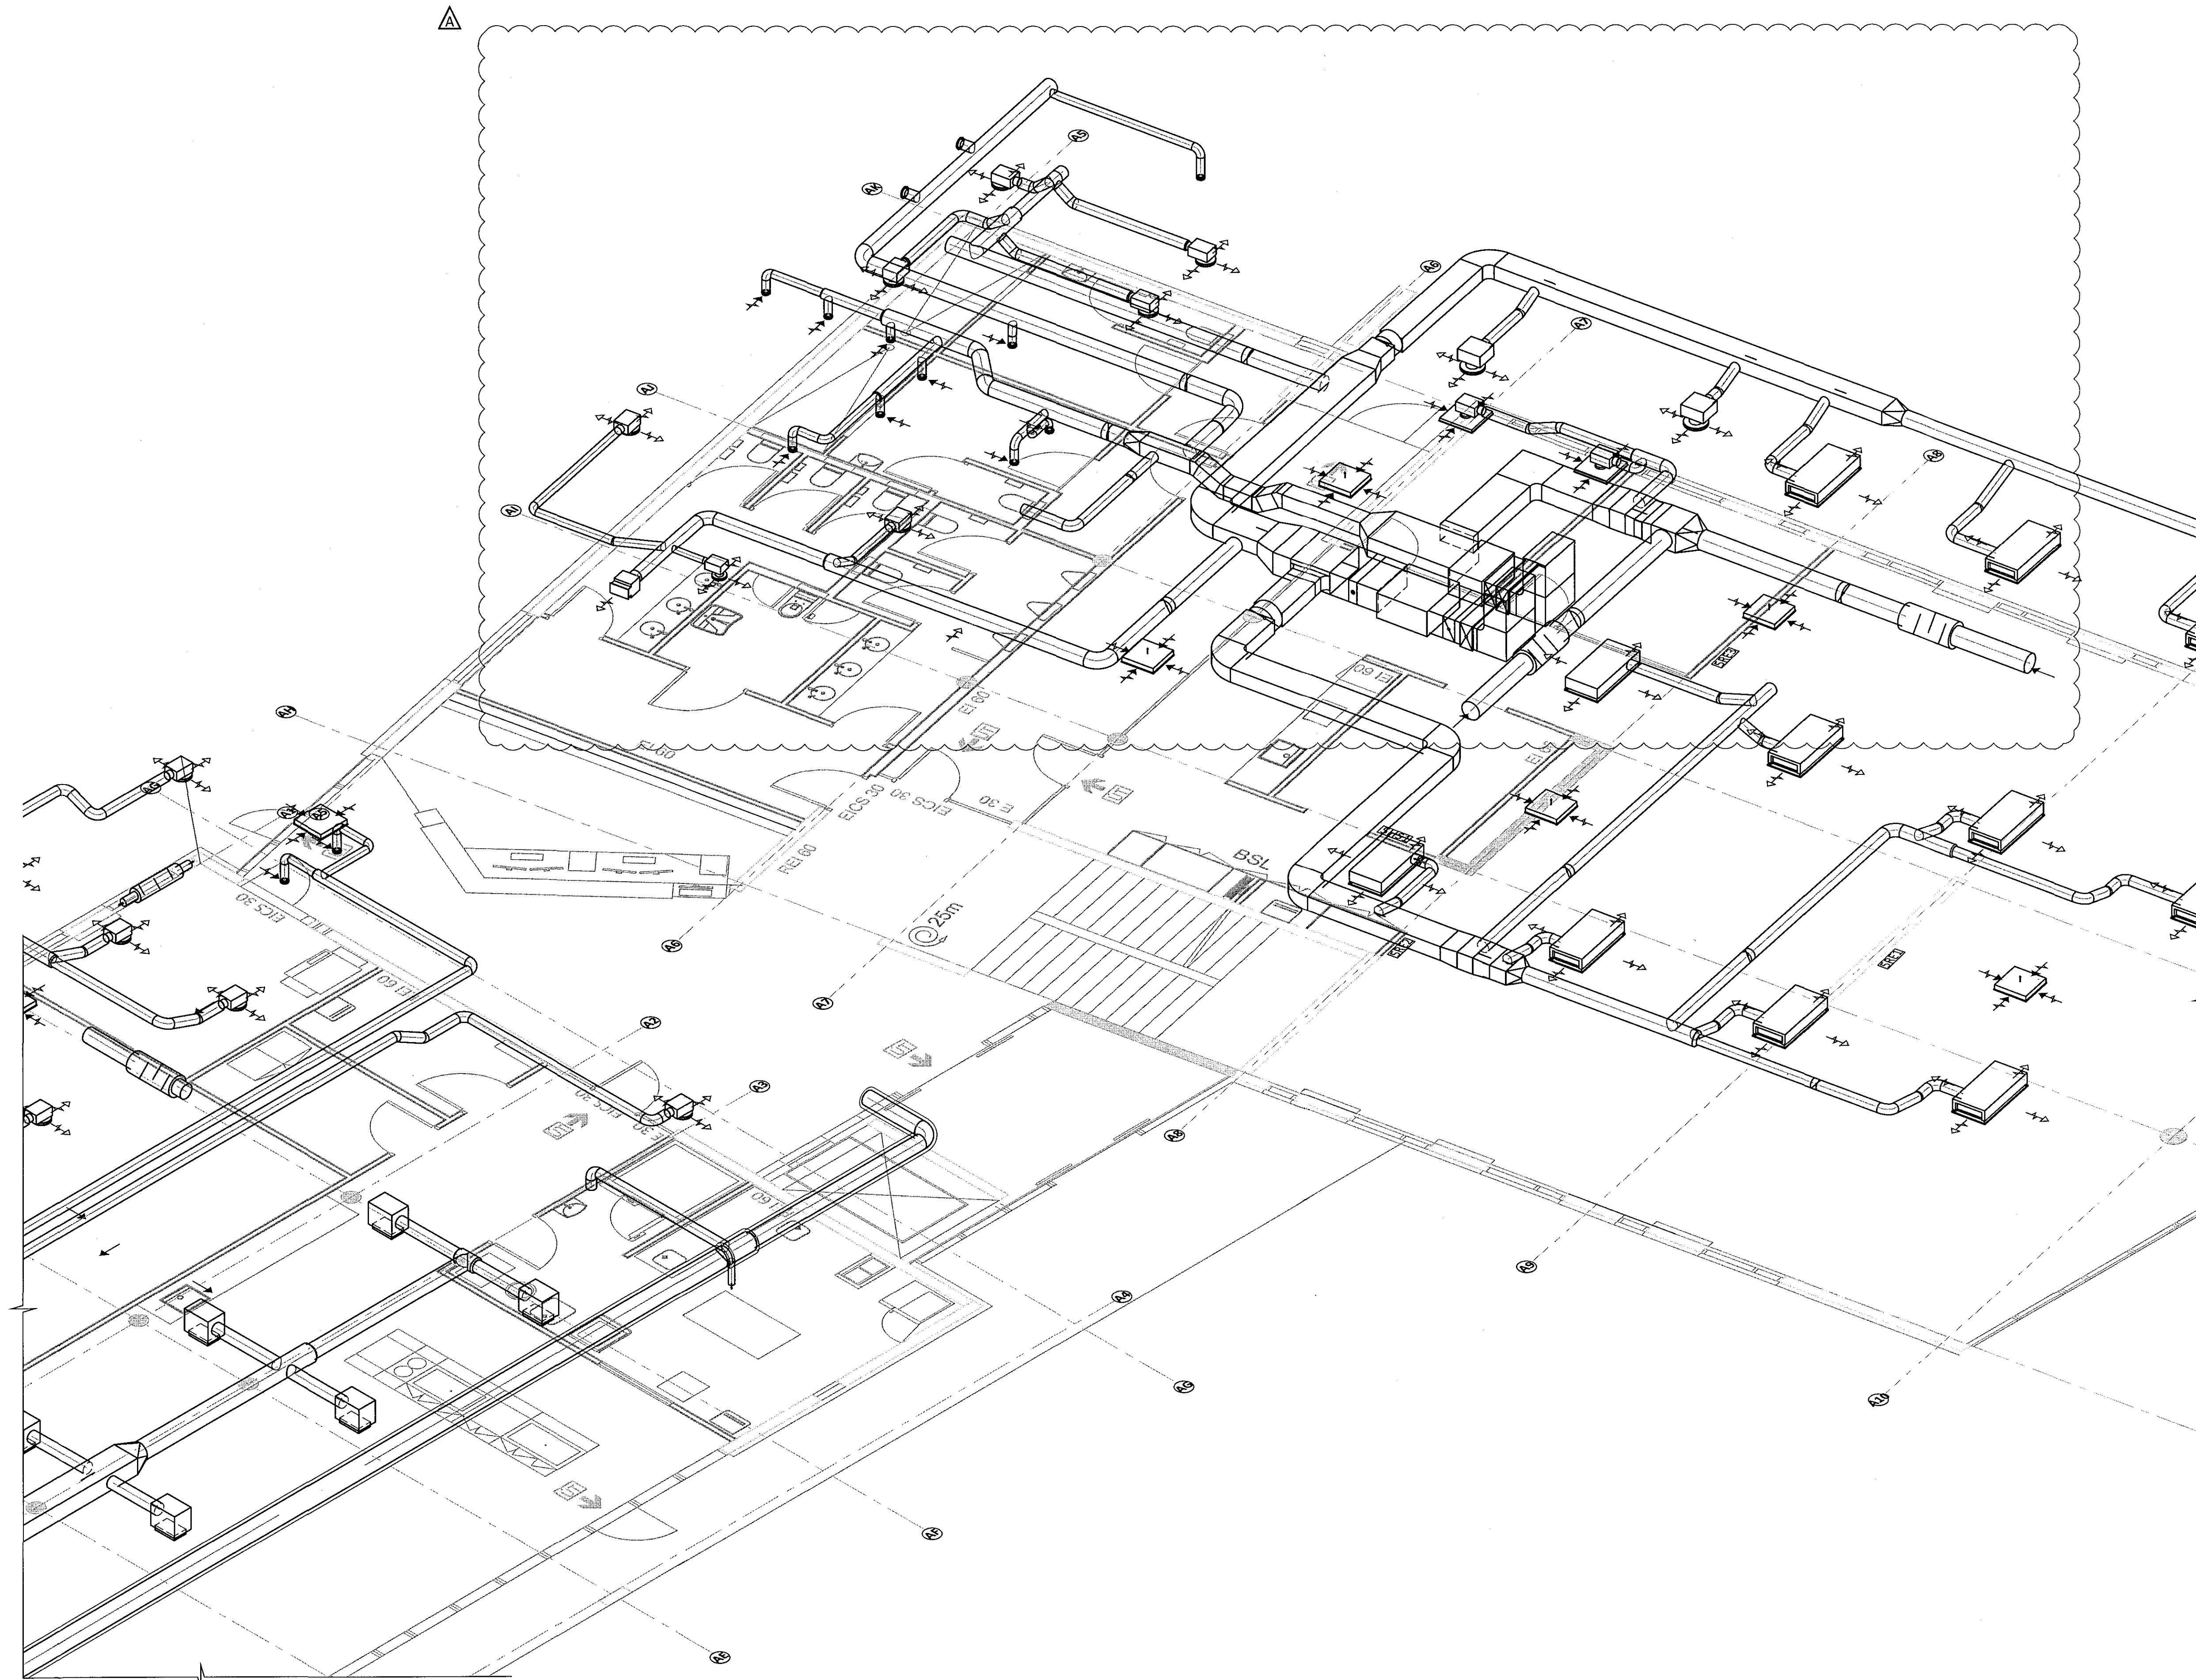

ARITUN ARM HÖNNUNAR: *[Signature]* KT. 04.07.2019

V:\Flugvellir\1\Teikningar\5-LOFTRÆSING\14014-5-1100.dwg

A 11.08.15 FÆRSLA Á LÖGNUM				ÞAG
BR.	DAGS.	BREYTING		SAMD.
ferill VERKFRÆÐISTOFA				
FLUGVELLIR 1		HAFNARFIRÐI		
NÝBYGGING				
LOFTRÆSING				
1. HÆÐ				
RÚMMYND				
SAMÞYKKT KT. <i>[Signature]</i> 270280-4220 ÞAG				
HÖNNUNDIR:	YFIRFÁRNI:	DAGS. ÚTGA:	DAGS. BREYTT:	
ERV einar@ferill.is	PAG	29.04.15	11.08.15	
MKV. 1:50	VERKNR. 14014	TEIKN. NR. 5-1114	BREYTT. A	
Ferill ehf. Mörkin 1 108 Reykjavík Sími: 575 1600 Fax: 575 1601 www.ferill.is				