


SECTION VIEW GRIDLINE 9 SC1:50

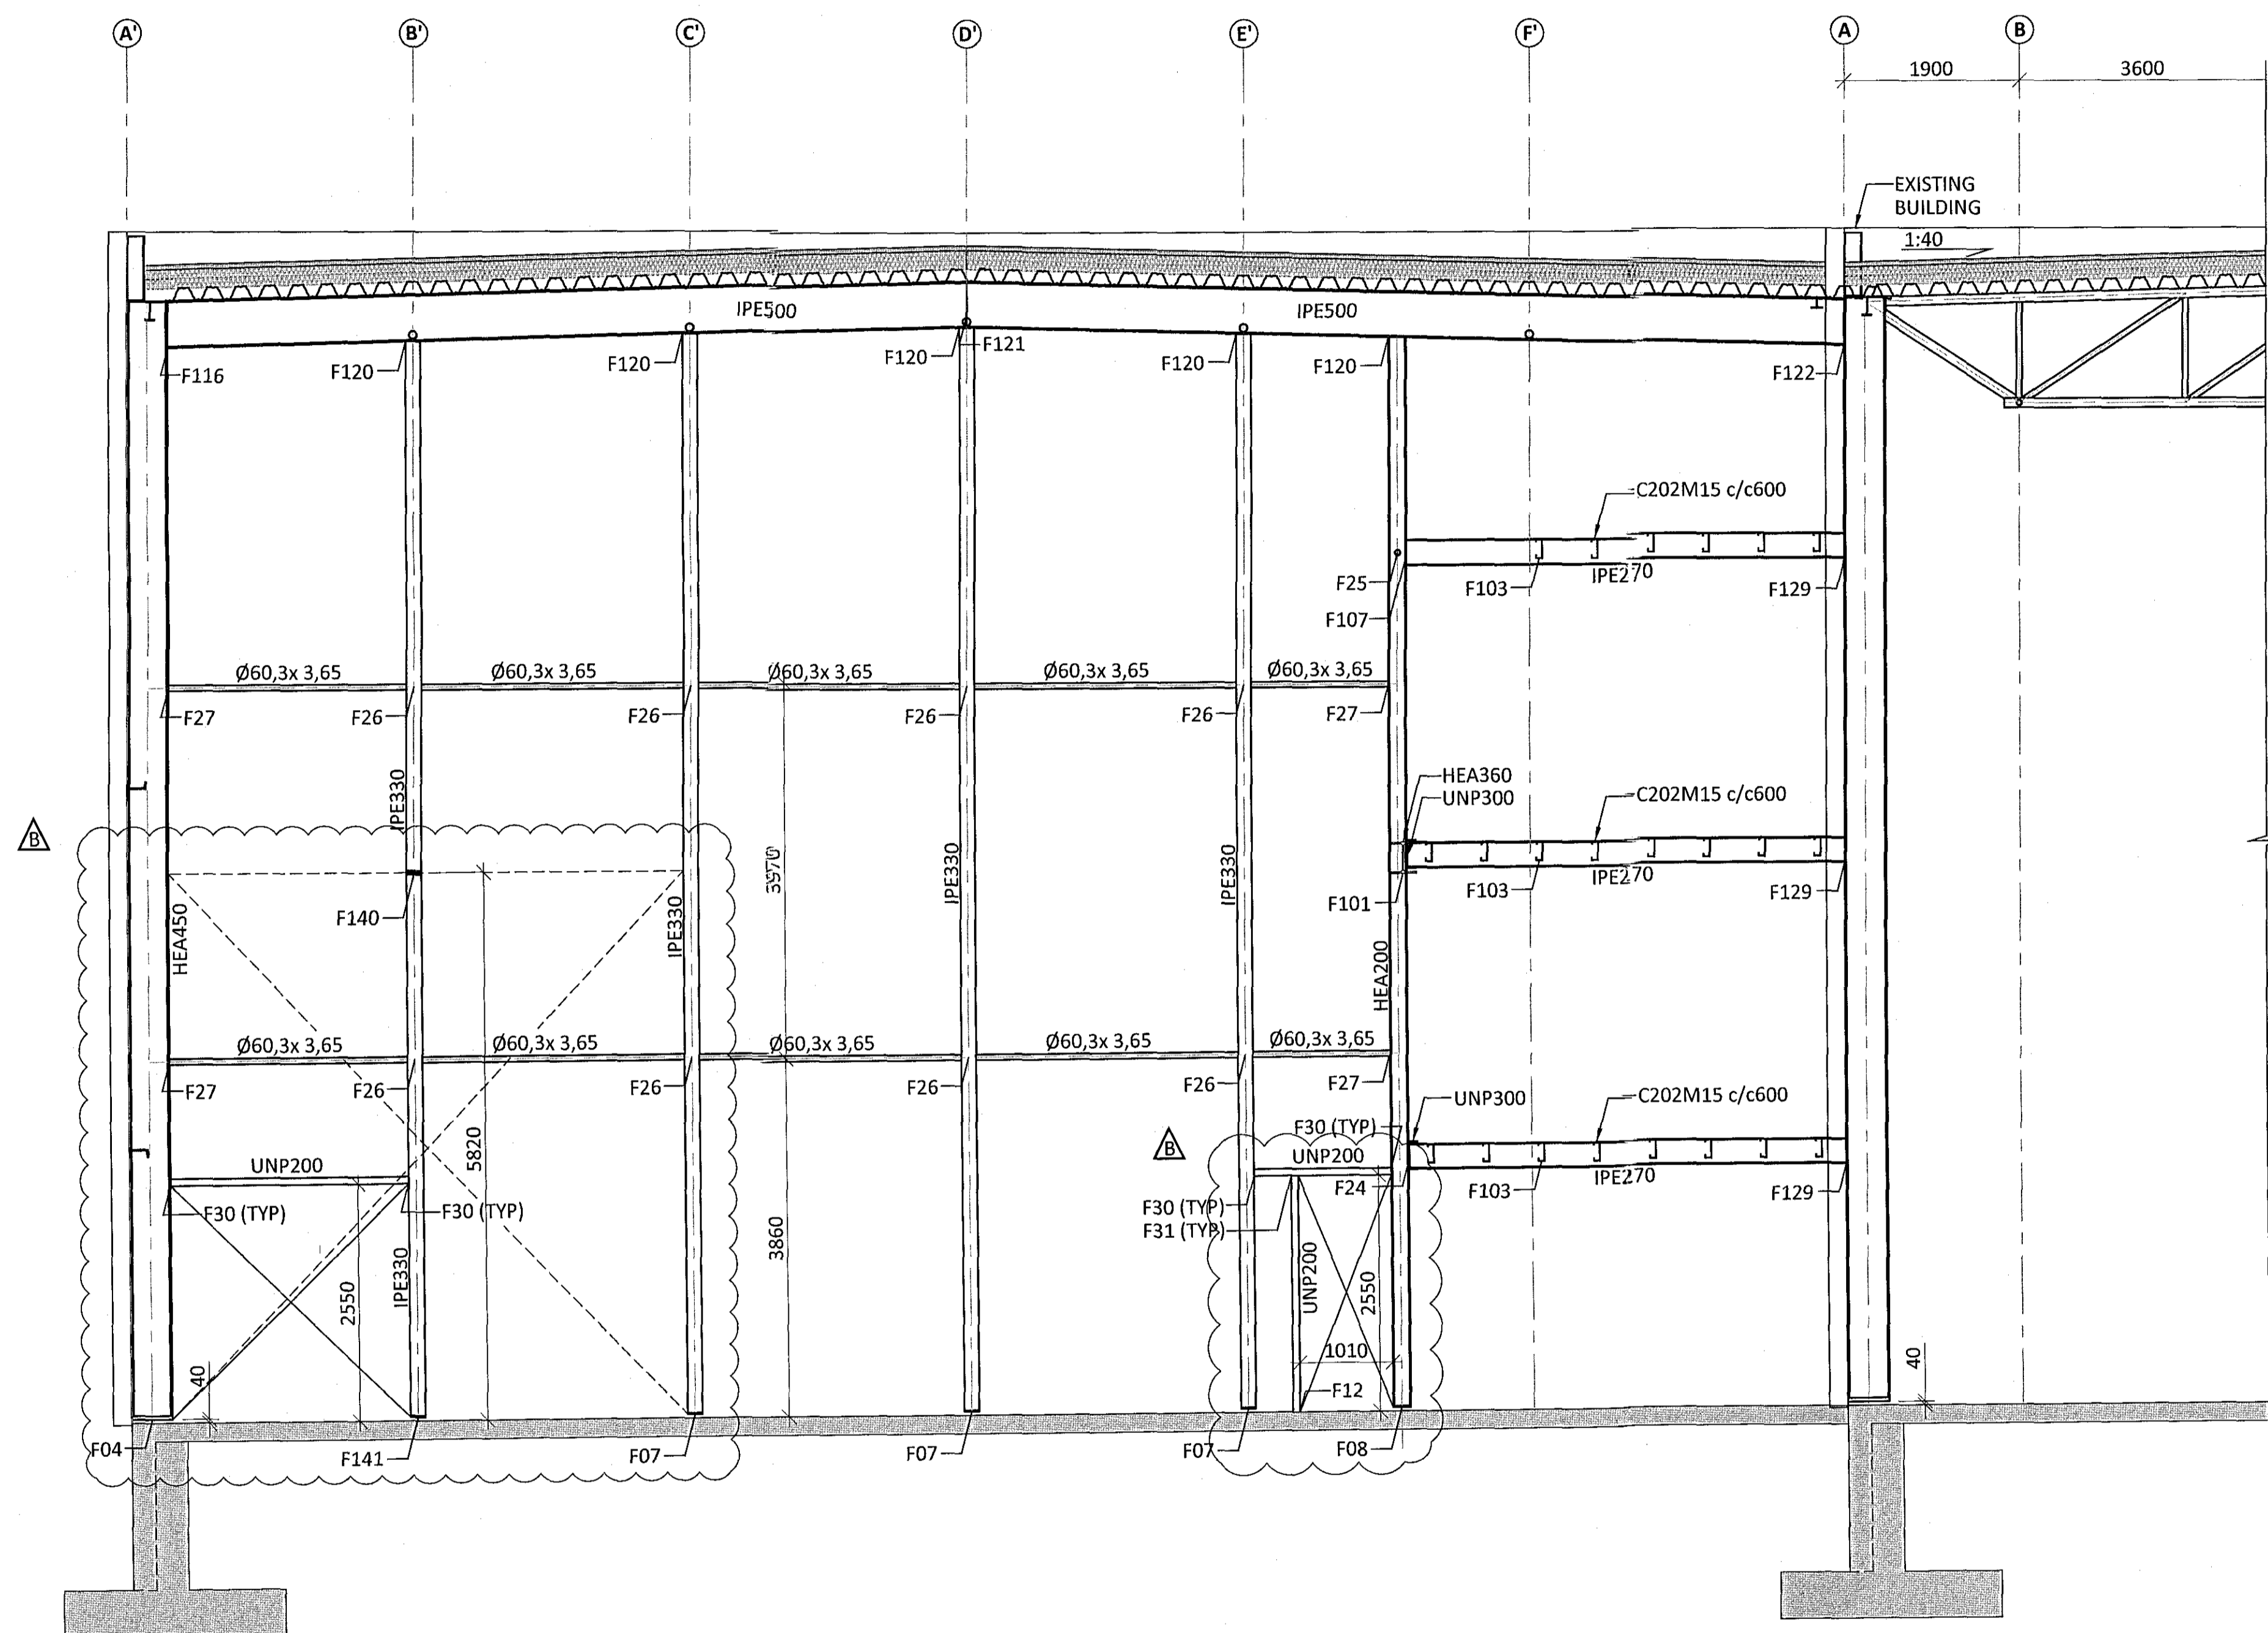

02107A 091251-2019

B	30.05.17	DOOR OPENINGS ADDED	
A	03.05.17	UNP300 PROFILES RAISED BY 25mm	
REV	DATE	DESCRIPTION	APPR.
ferill			
FLUGVELLIR 1		HAFNARFIRÐI	
FLIGHT SIMULATOR BUILDING			
STEEL STRUCTURE			
WALLS			
ELEVATION GRIDLINE 9			
APPROVED	ID No.		
DESIGNED	CHECKED	DATE	REV. DATE
PÓ	SB	04.04.17	30.05.17
thorri@ferill.is			
SCALE	PROJECT No.	DWG. No.	REV.
1:50	14014	1 - 2515	B
Ferill ehf. Mörkin 1 108 Reykjavík Iceland Tel +354 575 1600 www.ferill.is			