


ELEVATION VIEW GRIDLINE 13
SC1:50

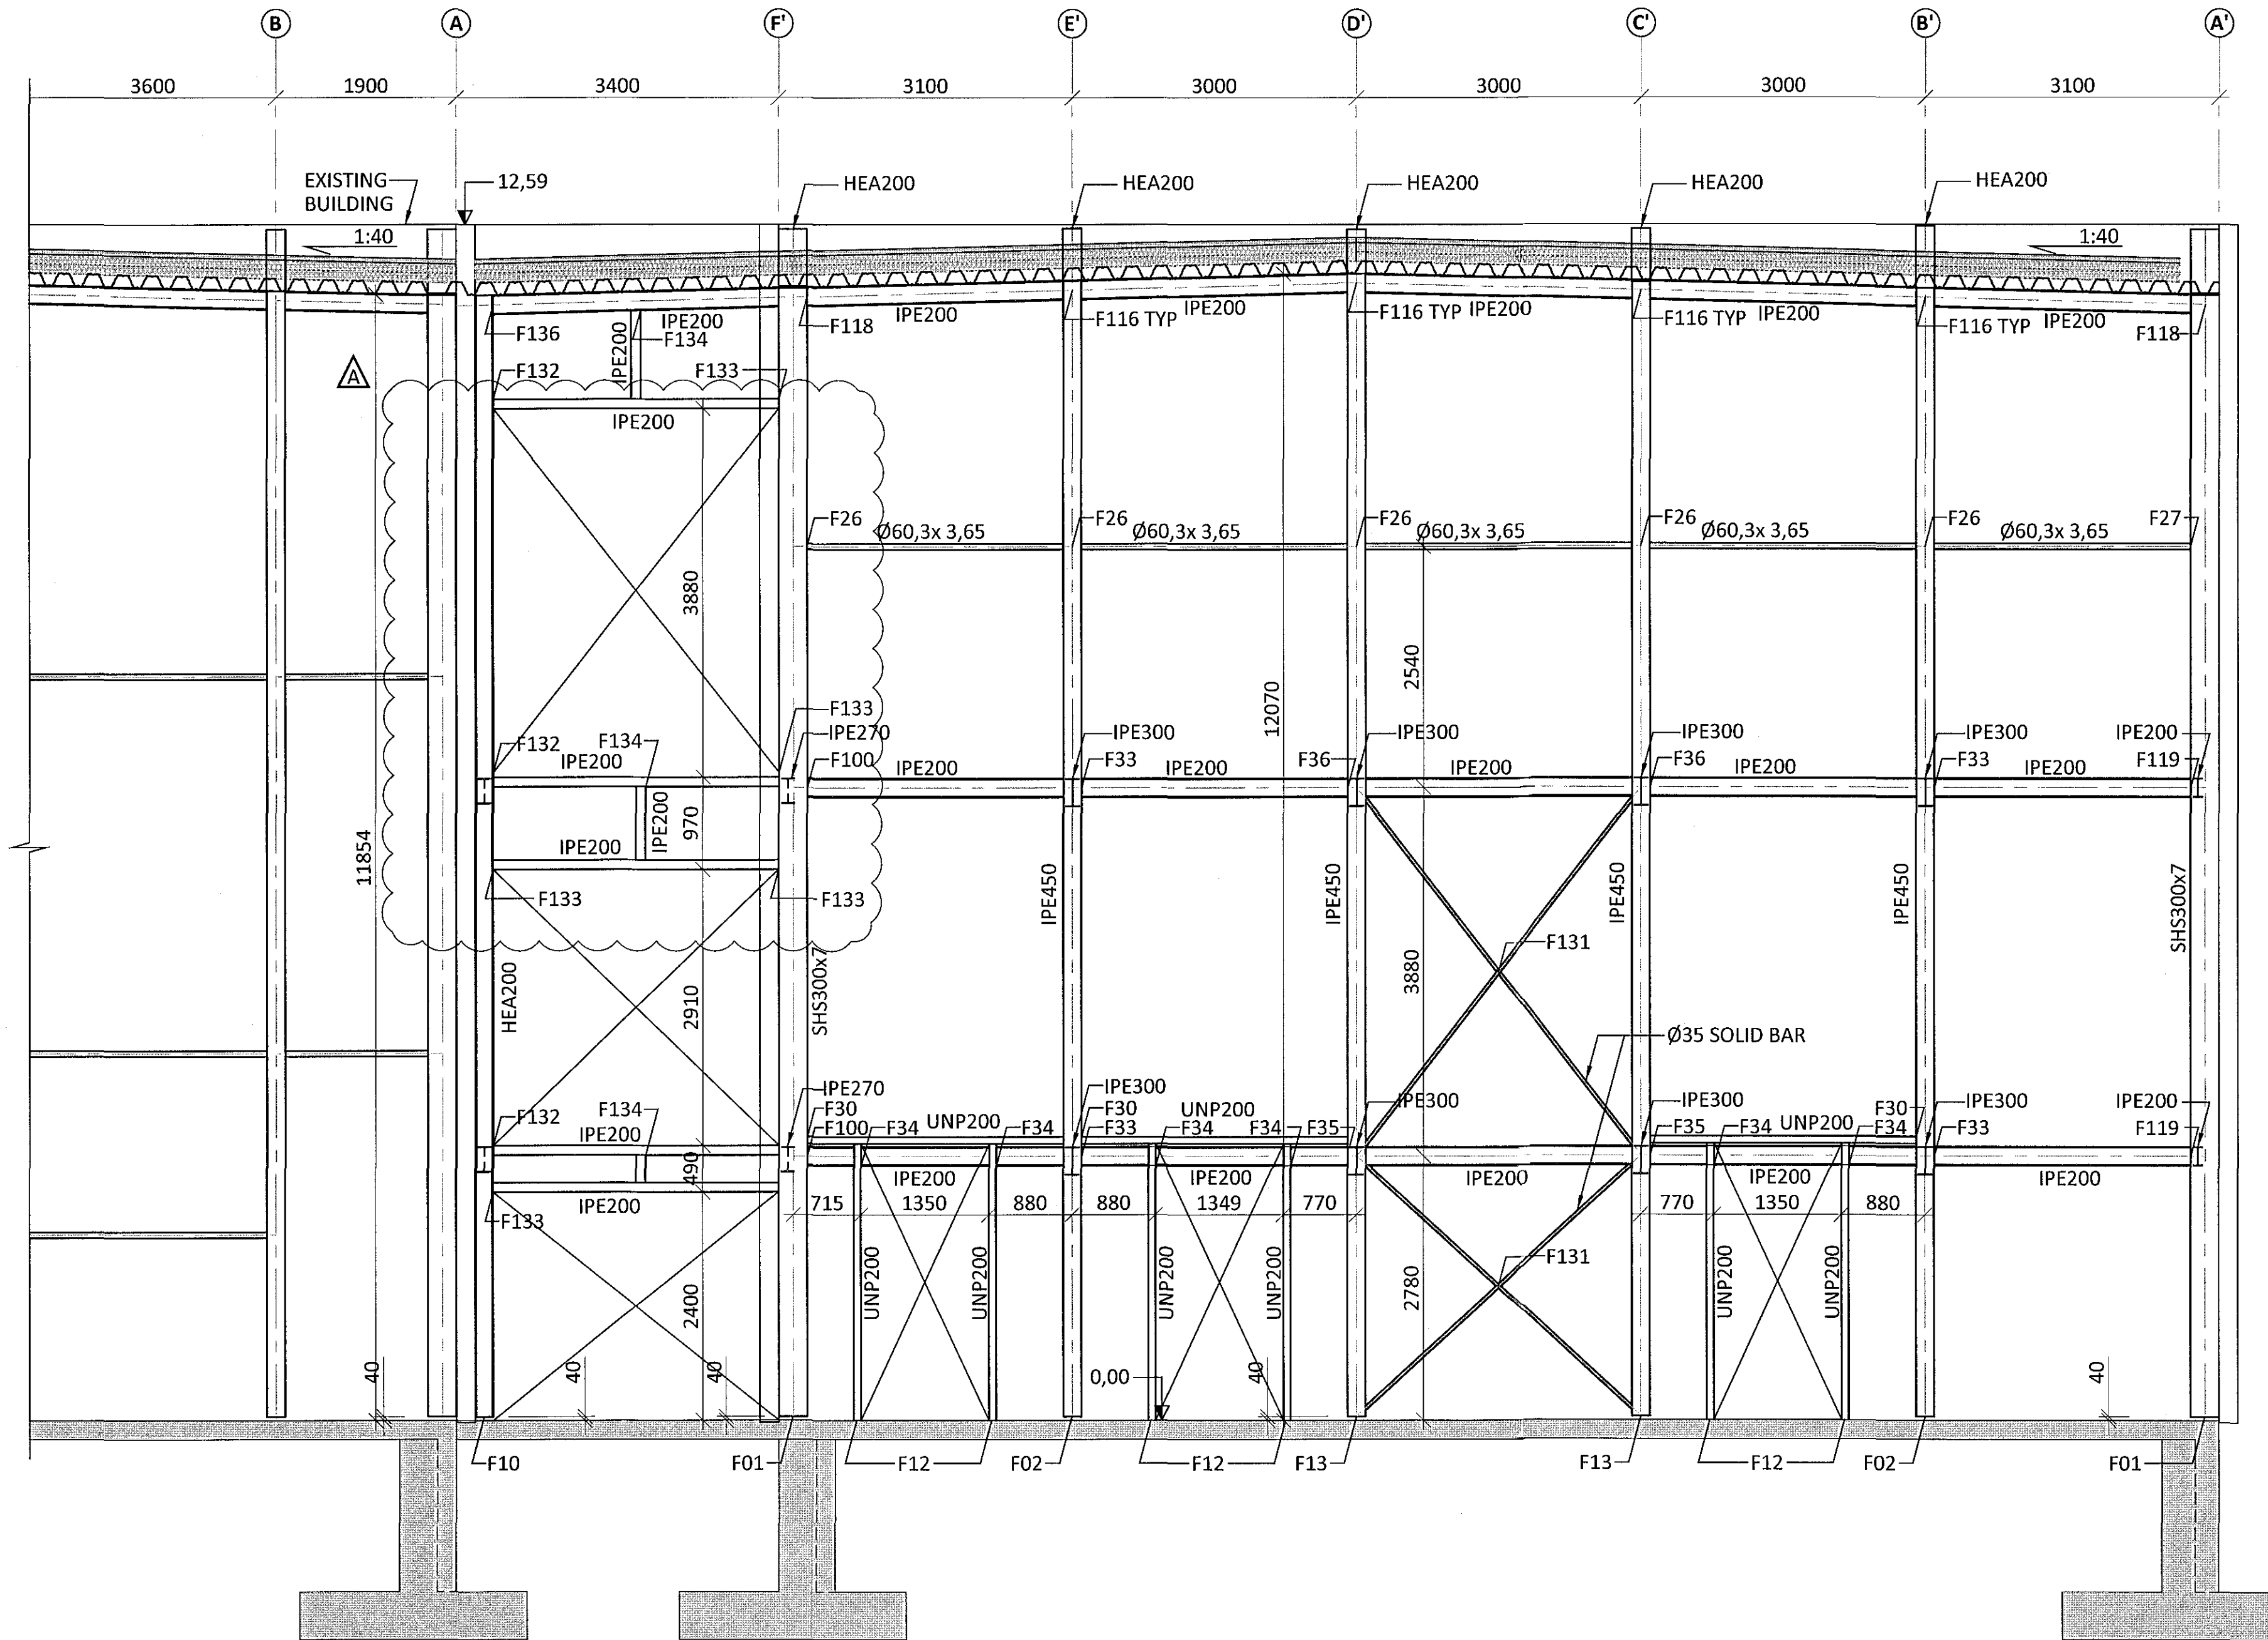

- GENERAL NOTES:
- ALL UNITS ARE mm
 - ALL ELEVATIONS ARE m
 - ALL STEEL SHALL BE ACCORDING TO EN 1993-1-1:2005
 - EXECUTION OF STEEL STRUCTURE SHALL BE ACCORDING TO EN 1090-2-2008
 - STEEL GRADE OF MEMBERS SHALL IN GENERAL BE S235 EXCEPT CROSS BRACING (SHS100x5) SHALL BE STEEL GRADE S355
 - ALL BOLTS SHALL BE IN CLASS 8.8
 - SURFACE TREATMENT OF ALL STEEL SHALL BE ACCORDING TO CORROSION CATEGORY C3. STEEL SHALL BE PAINTED WITH PRIME COAT AND ON TOP OF THAT TWO LAYERS OF APPROPRIATE PAINT OF DARK GRAY COLOR (RAL 7016, GLOSS 35-40%) MINIMUM THICKNESS SHALL BE 100µm. PAINT SYSTEM SHALL BE APPROVED BY FERILL.

ÓMÓÐ 01.05.2017

A 11.05.17 WINDOW ORIENTATION CHANGED			
REV.	DATE	DESCRIPTION	APPR.
ferill			
FLUGVELLIR 1		HAFNARFIRÐI	
FLIGHT SIMULATOR BUILDING			
STEEL STRUCTURE			
WALLS			
ELEVATION GRIDLINE 13			
APPROVED: <i>[Signature]</i> ID No. 160172-3879			
DESIGNED:	CHECKED:	DATE:	REV. DATE:
bO	SB	04.04.17	11.05.17
SCALE:	PROJECT No.:	DWG. No.:	REV.:
1:50	14014	1 - 2511	A