


ELEVATION VIEW GRIDLINE 1  
SC1:50

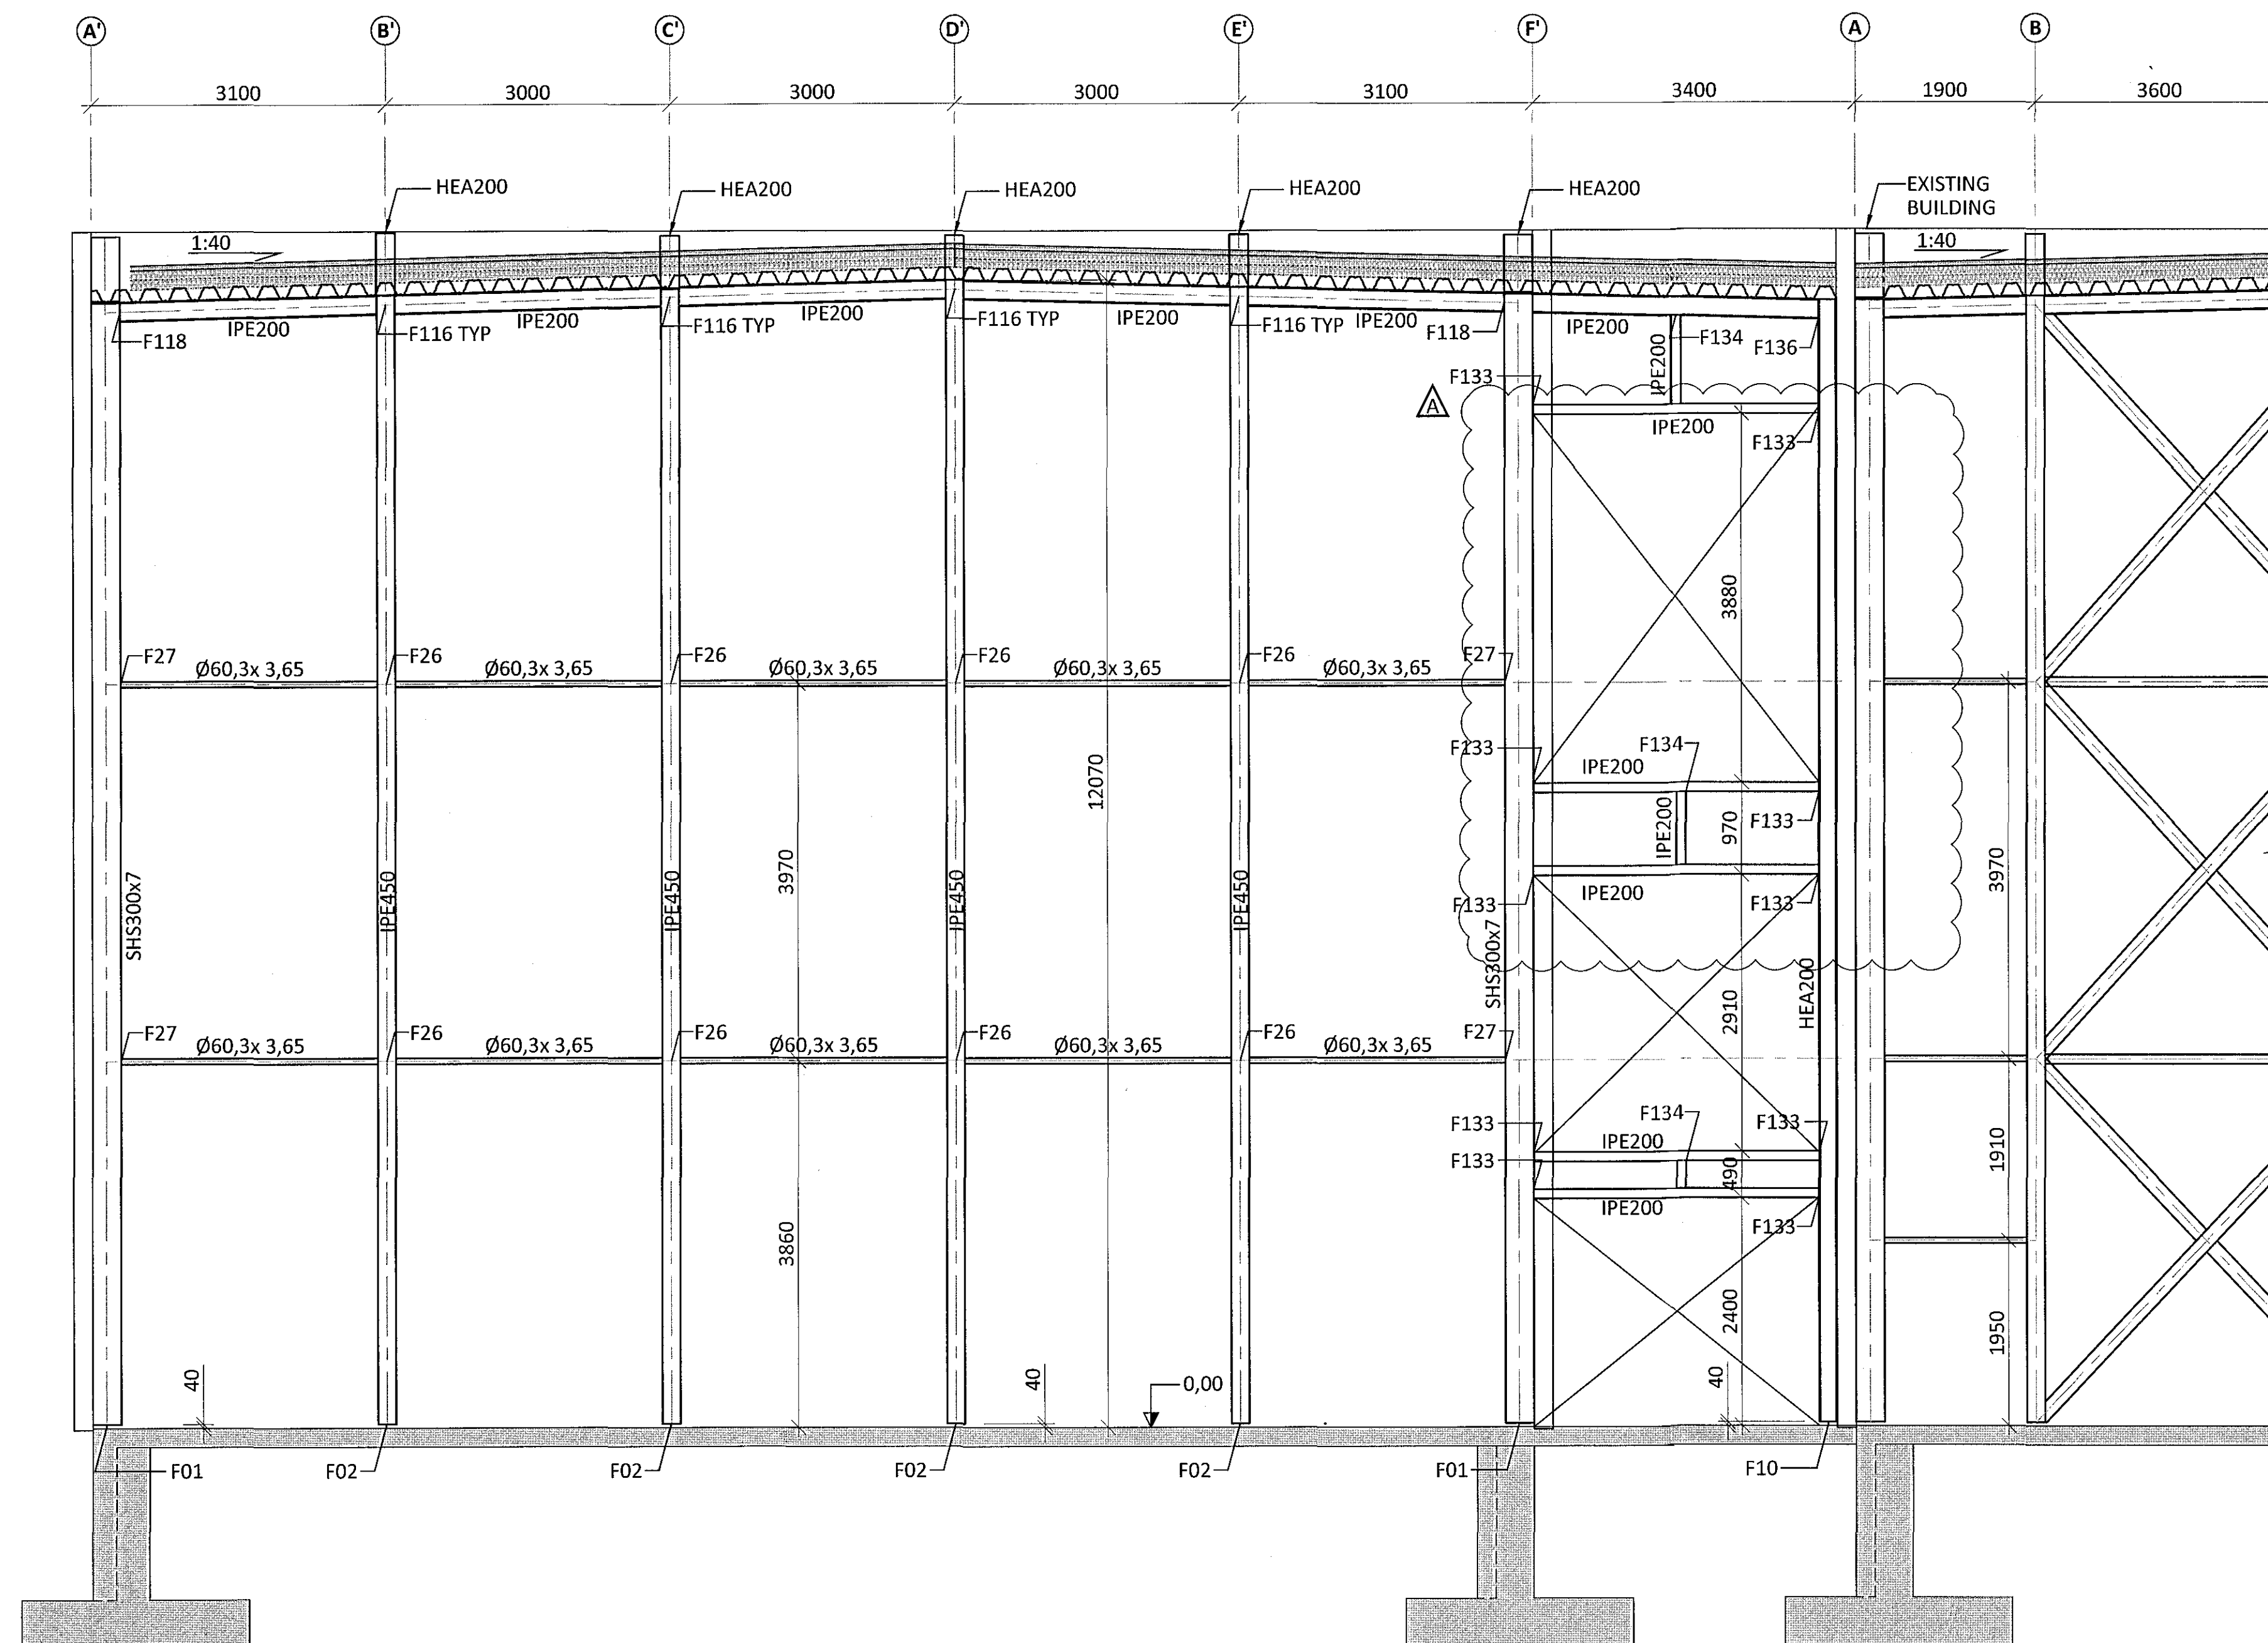

*Ólafur* 04.05.17-3915

REV.	DATE	DESCRIPTION	APPR.
A	11.05.17	WINDOW ORIENTATION CHANGED	

**ferill**

**FLUGVELLIR 1** HAFNARFIRÐI  
FLIGHT SIMULATOR BUILDING  
STEEL STRUCTURE  
WALLS  
ELEVATION GRIDLINE 1

APPROVED: *Paul Ólafsson* 04.05.17-3879

DESIGNED	CHECKED	DATE	REV. DATE
PÓ thori@ferill.is	SB	04.04.17	11.05.17
SCALE	PROJECT No.	DWG. No.	REV.
1:50	14014	1 - 2512	A