


21/6/16 15:06:25

ÁRITUN BYGGINGARFULLTRÚA

Samþykkt þann
30. júní 2016
Byggingarfulltrúi

SJÁ FRAMHALD Á TEIKNINGU -3-1012

LYKILMYND:

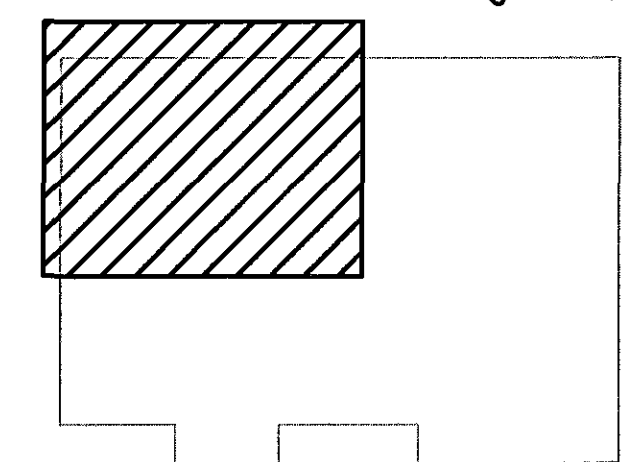

ÁRITUN AÐALFRAMHOLDAR: *[Signature]*
Kt. 220584-4388

ALMENNAR SKÝRINGAR SJÁ TEIKNINGU NR. -3-001

A	21.06.16	REYNDARTEIKNING	<i>[Signature]</i>
BR.	DAGS.	BREYTING	



FLATAHRAUN 13 HAFNARFJÖRÐUR
NÝBYGGING KRÓNUVERSLUN
HITA- OG ÞRIFAKERFI
RÚMMYND
1.HLUTI

SAMPYKKT:		KT. 270760-4229	
HÖNNUÐUR	YERIFARID	DAGS. UTG.	DAGS. BREYT.
GP	gummi@ferill.is	DAG	13.11.15
MKV. (A1)	1:50	VERKNR.	14048
		TEIKN. NR.	3 - 1011
		BREYT.	A