

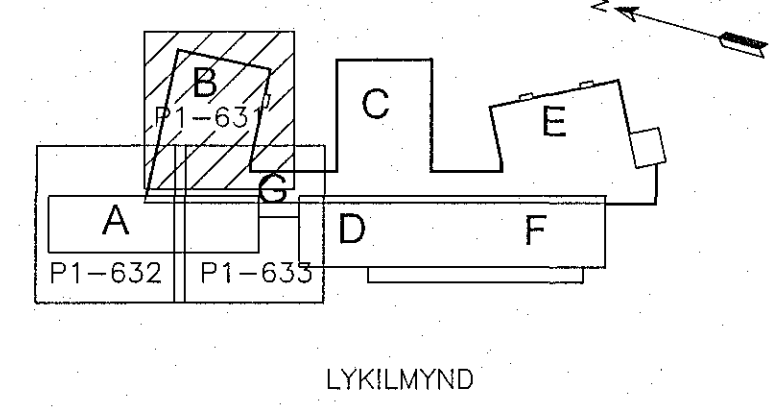


PRENTAD: 2. júní 2015 18:51:52

1 2 3 4 5 6 7 8 9 10 11 12

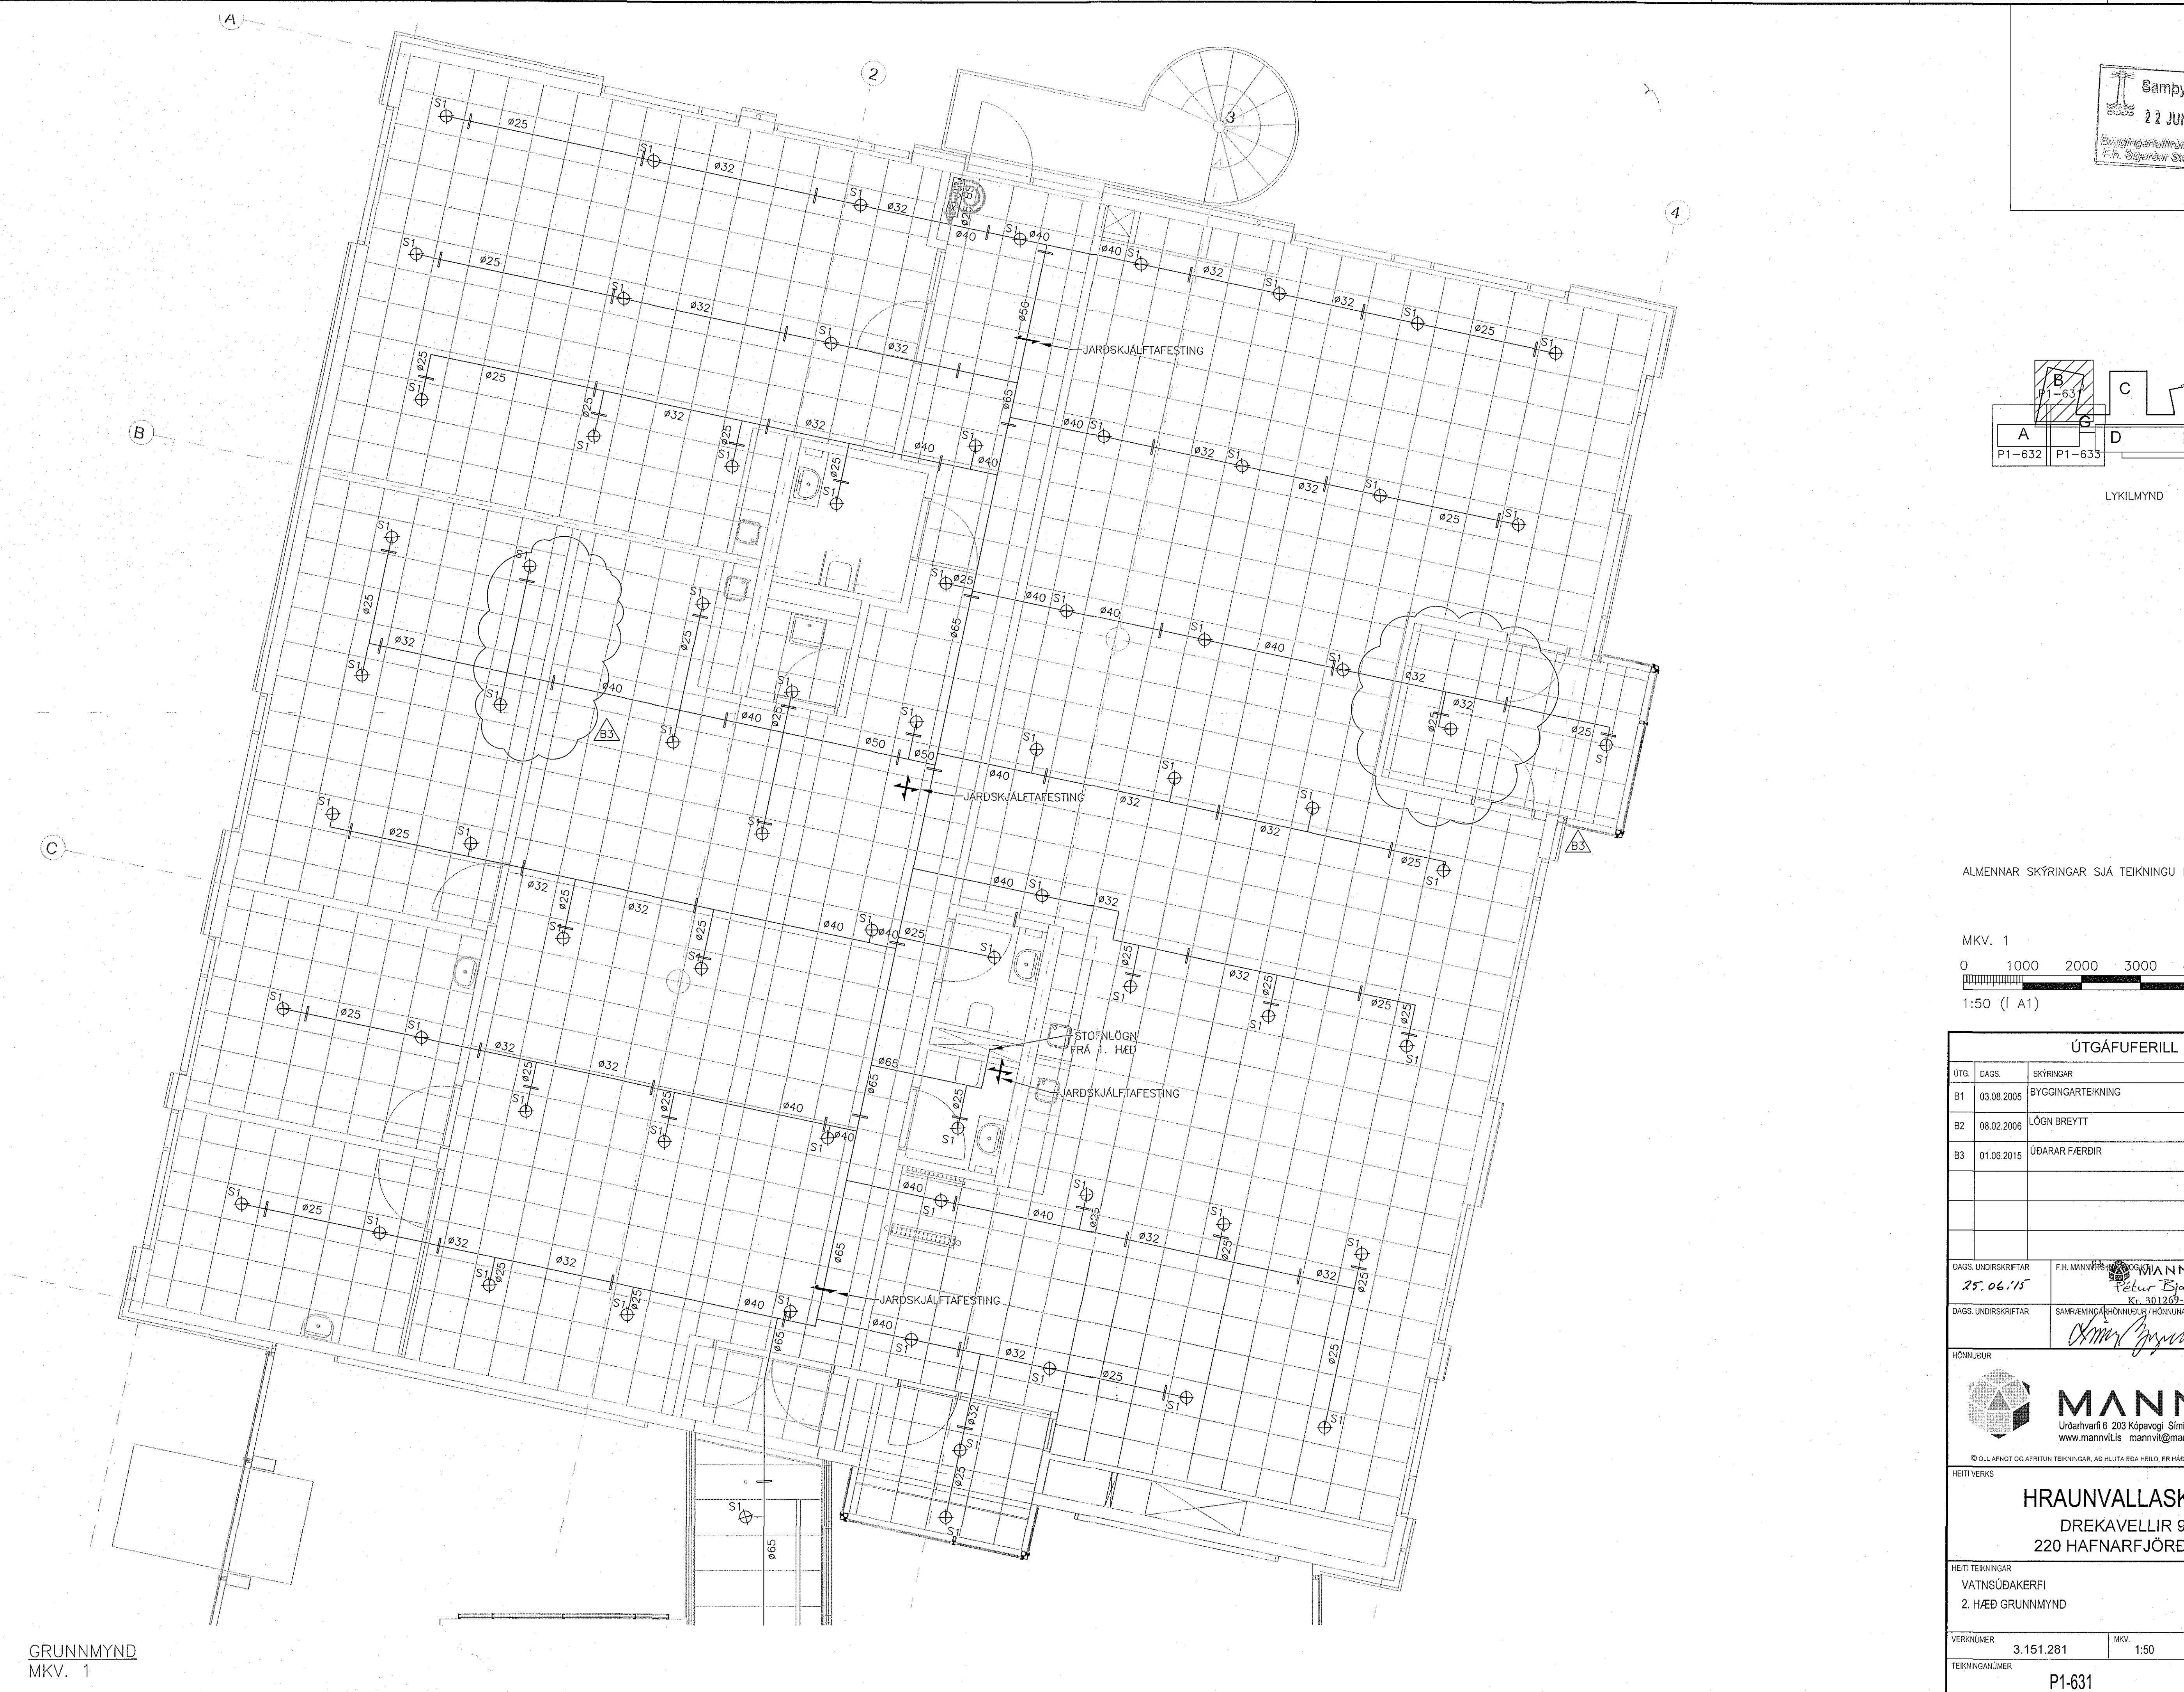

ALMENNAR SKÝRINGAR SJÁ TEIKNINGU P0-601

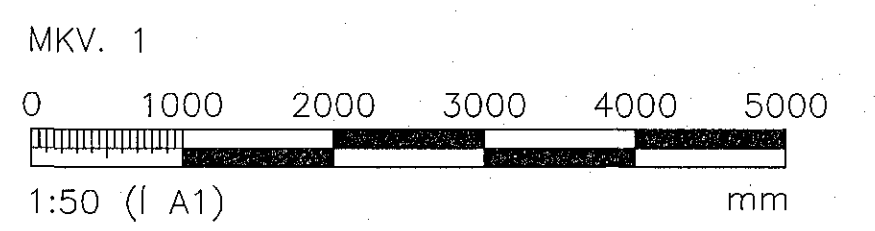

ÚTGÁFUFERILL					
UTG.	DAGS.	SKÝRINGAR	HAÐNAG.	YFIRF.	SAMP.
B1	03.08.2005	BYGGINGARTEIKNING	PB	RGS	LÁ
B2	08.02.2006	LÖGN BREYTT	PB	RGS	LÁ
B3	01.08.2015	ÚÐARAR FERDIR	PB	SÍP	PB

DAGS. UNDRISKRIFTAR: 25.06.15 F.H. MANNVIT M. Pálur Bjarnman K.r. 301269-3589

DAGS. UNDRISKRIFTAR: SAMRÆMINGARHÖNNUNDIR / HÖNNUNARSTJÓRI (NAFN OG KT.)

HÖNNUNUR

**MANNVIT**  
 Lindarhvarfi 6 203 Kópavogi Sími: 422 3000 Fax: 422 3001  
 www.mannvit.is mannvit@mannvit.is Kl: 430572-0169

HEITI VERKS  
**HRAUNVALLASKÓLI**  
 DREKAVELLIR 9  
 220 HAFNARFJÖRÐUR

HEITI TEIKNINGAR  
 VATNSÚÐAKERFI  
 2. HÆÐ GRUNNMÝND

VERKINGUMÉR	3.151.281	MKV.	1:50	STÆND	A1
TEIKNINGANUMÉR	P1-631			UTGÁFA	B3

GRUNNMÝND  
 MKV. 1

TOLVUSKÝRÁ: S:\9-vr1151-Hafnarfjörður\20157 TEIKNINGAR-PPL\LAGNRP1-431-633.dwg