


ÚTGÁFUERILL				
ÚTGÁFA	DAGI	SKYRINGAR	BR. AF	SAMB.
OKT.08		REYNDARTEIKNING		
B	30.05.15	Breytingar stofum og kennslurýmum	SJ	MK

DAGS UNDRISPRÉTTAR: *Magnús Kristbergsson*
 NAFNI OG KT. SAMRÆMINGARHÓNDUÐAR: *Magnús Kristbergsson*
 UNDRISPRÉTT SAMRÆMINGARHÓNDUÐAR: *Magnús Kristbergsson*

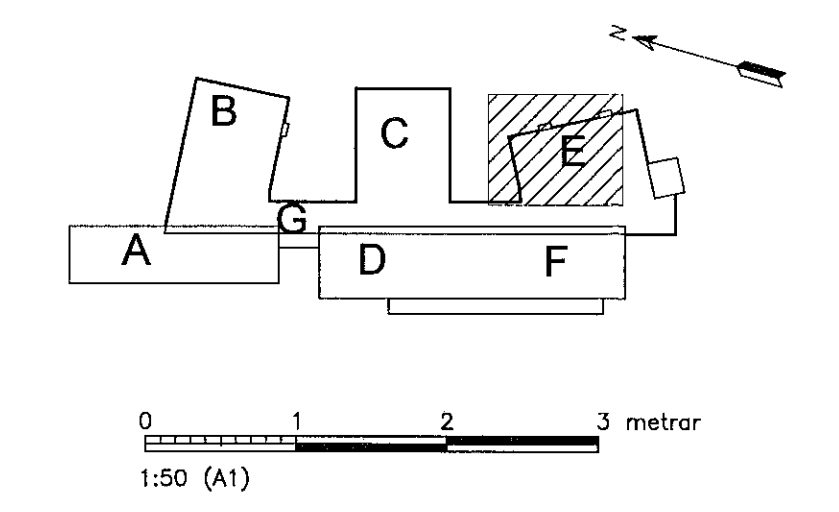

Verkfræðistofa Jóhanns Indriássonar ehf
 Síomúli 1, 108 Reykjavík
 Sími 598 7315, Fax 598 6987, Netfang vj@vj.is, Veffang www.vj.is

HRETTI VERKS:
HRAUNVALLASKÓLI
 DREKAVÖLLUM 9
 HAFNARFIRÐI

HRETTI TEIKNINGAR:
 RAFLAGNIR LÁGSPENNUTEIKNINGAR
 LAMPA- OG RENNUPLAN 3. HÆÐ E1-309
 2.-3. ÁFANGI

MAK 1:50 A1 1:100 A3	VERKNI: S401	SKULÁNGRANIR: ODNK	ÚTGÁFA: B
HAFNAR: OJS/SJ	TEIKNAR: IM	VERFAÐI:	NR. TEIKNINGAR: E1-309
NAFTI OG KT. SAMRÆMINGAR: MAGNÚS KRISTBERGSSON 080257 3689	UNDRISPRÉTT SAMRÆMINGAR: <i>Magnús Kristbergsson</i>	BLAÐNÖMUR: 133	