


Samþykkt þann  
11 SEP 2017  
Byggingarhluturinn í Hestvegi  
F.H. Sigurður Steinar Jónsson

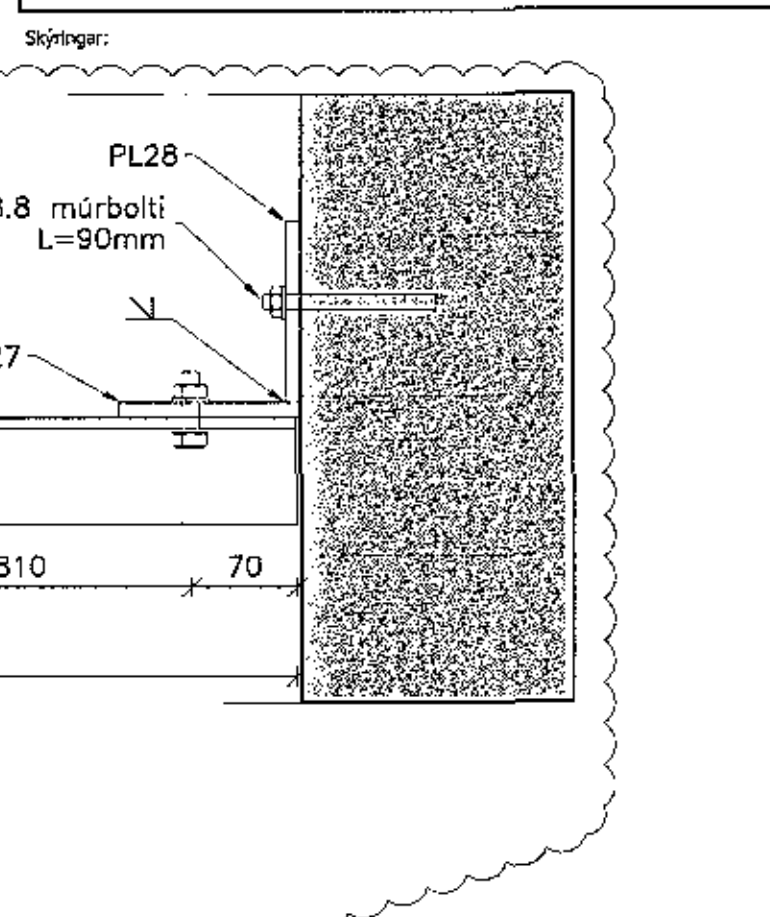

2	Ymsar breytingar	16.08.17	HJE
1	Frámkvæmdateikning	15.12.16	HJE
Δ	Breytingar:	Dags:	HÖ:

**HNIT** VERKFRÆÐISTOFA  
Hás ednáaraut. Stú. 101 Reykjavík. Sími: 570-0500 Fax: 570-0503 www.hnit.is

Manna: AMG Teikna: JHG Vörð: HJE  
Tölvafrók: B(29)01\_STÁLGRIND.DWG  
Númer: 1311675479 Dags: 15.12.2016  
Samþykkt: Haukur Örn

Ásvellir, íþróttamiðstöð Hauka Salur 2

Burðarþol Stálgrind

Verk nr.: 16229 Framið. blátt: A1 Teikn. nr.:  
Mkv: 1:50 1:5

**B(29)01 2**