



ARITUN BYGGINGARFULLTRÚA
1703047 04.10.2017

Sambýkkt bann
20 OCT 2017


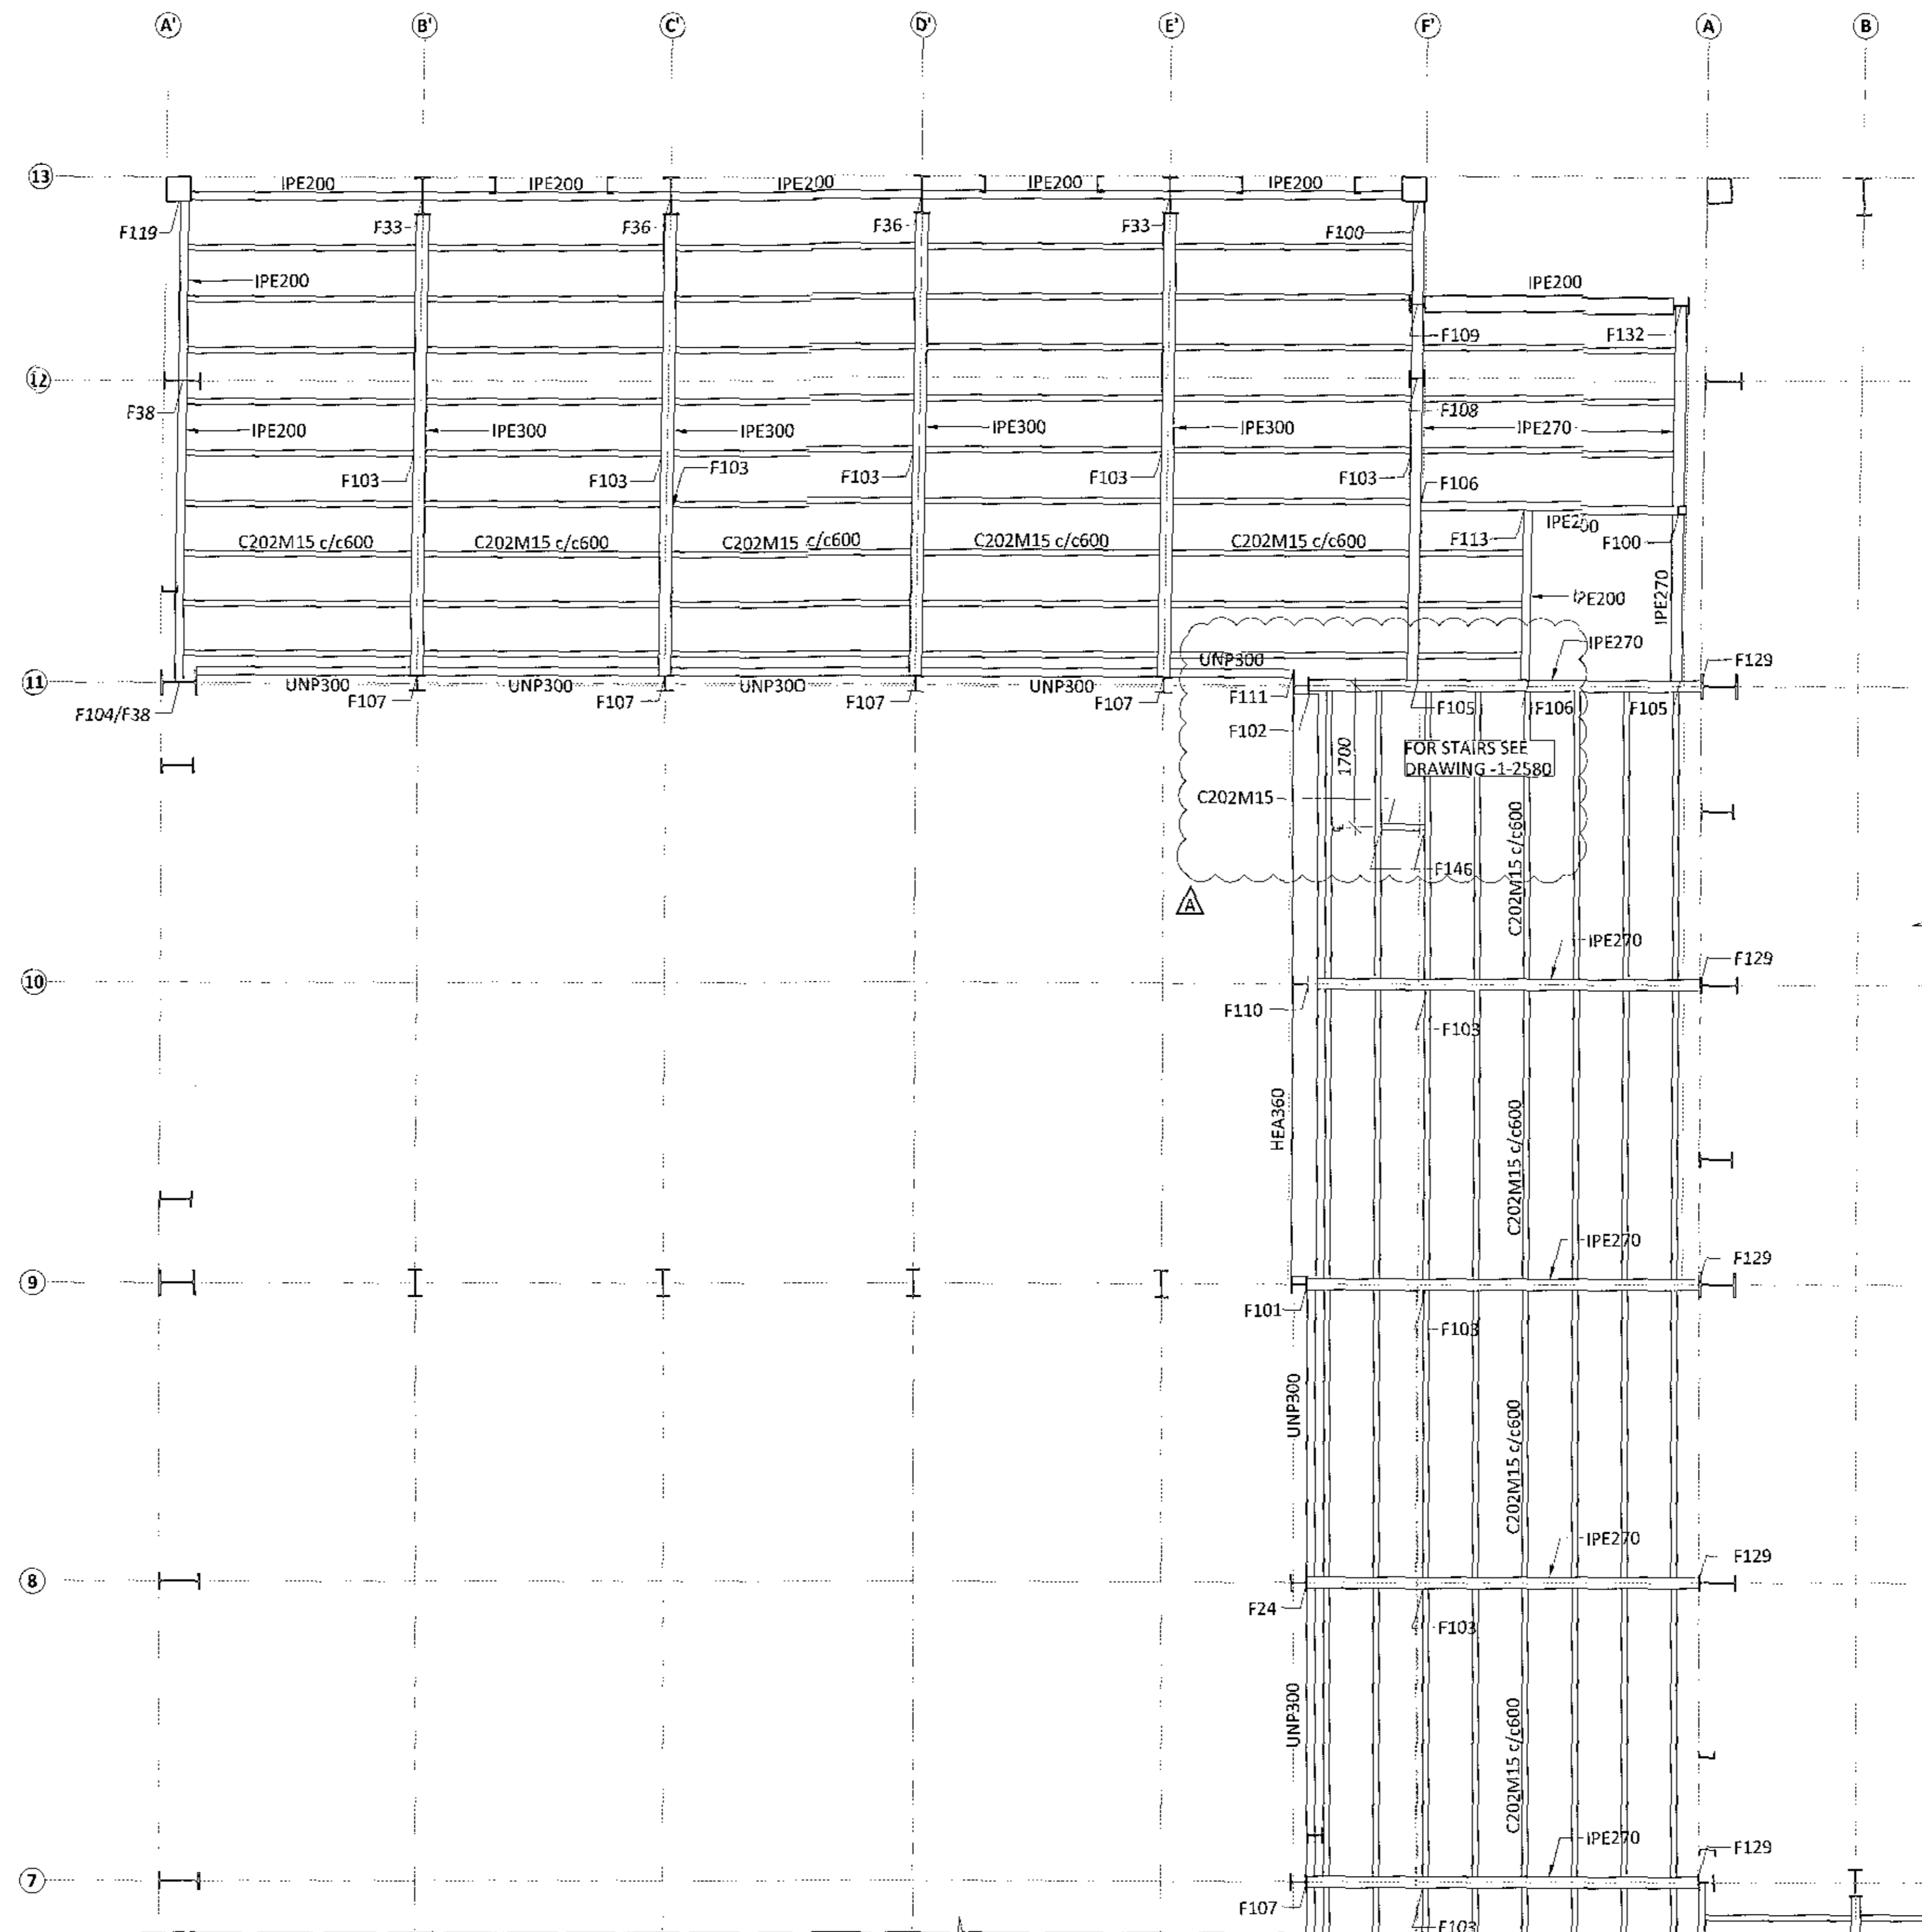

- GENERAL NOTES:
- ALL UNITS ARE mm
 - ALL ELEVATIONS ARE m
 - ALL STEEL SHALL BE ACCORDING TO EN 1993-1-1:2005
 - EXECUTION OF STEEL STRUCTURE SHALL BE ACCORDING TO EN 1090-2:2008
 - STEEL GRADE OF MEMBERS SHALL GENERAL BE S235 EXCEPT CROSS BRACING (SHS100x5) SHALL BE STEEL GRADE S355
 - ALL BOLTS SHALL BE IN CLASS 8.8
 - SURFACE TREATMENT OF ALL STEEL SHALL BE ACCORDING TO CORROSION CATEGORY C3. STEEL SHALL BE PAINTED WITH PRIME COAT AND ON TOP OF THAT TWO LAYERS OF APPROPRIATE PAINT OF DARK GRAY COLOR (RAL 7016, GLOSS 35-40%) MINIMUM THICKNESS SHALL BE 100µm. PAINT SYSTEM SHALL BE APPROVED BY FERILL
 - C-SECTIONS ACCORDING TO METSEL PRODUCTION

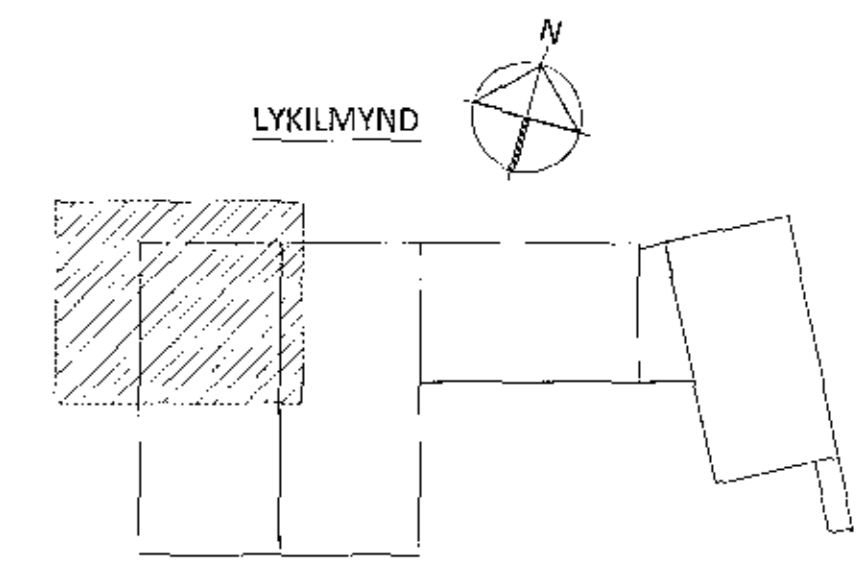

ARITUNARÁÐGAFINGARSTJÓRN
EJAFER
KT. 01/2513018

A 26.09.17 BITA FYRIR STIGA BÆTTI VIÐ			
BR.	DAGS.	BREYTING	SAMD.

ferill
VERKFRÆÐ STÓFA

FLUGVELLIR 1 HAFNARFIRDI
NÝBYGGING

BURÐARVIRKI
PLATA YFIR 2. HÆÐ
GRUNNMYND

SAÐSTJÓRN: *[Signature]* 260172-3873

HÖNNUNUR PO	YFIRFARID SB	DAGS. ÚTGA. 04.04.17	DAGS. BREYT. 26.09.17
SKYF. 1:50	VERURUR 14014	TEIKN. NÚM. 1-1206	BREYT. A

Ferill ehf. Mörkin 1 108 Reykjavík Sími: 575 1000 Fax: 575 1001 www.ferill.is