


1703087 07.10.2017

Samþykkt þann
20 OCT 2017
Þýðingartulltrúinn í Hafnarfirði
F.n. Sigurður Steinar Jónsson

ELEVATION VIEW GRIDLINE 1
SCALE: 1:50

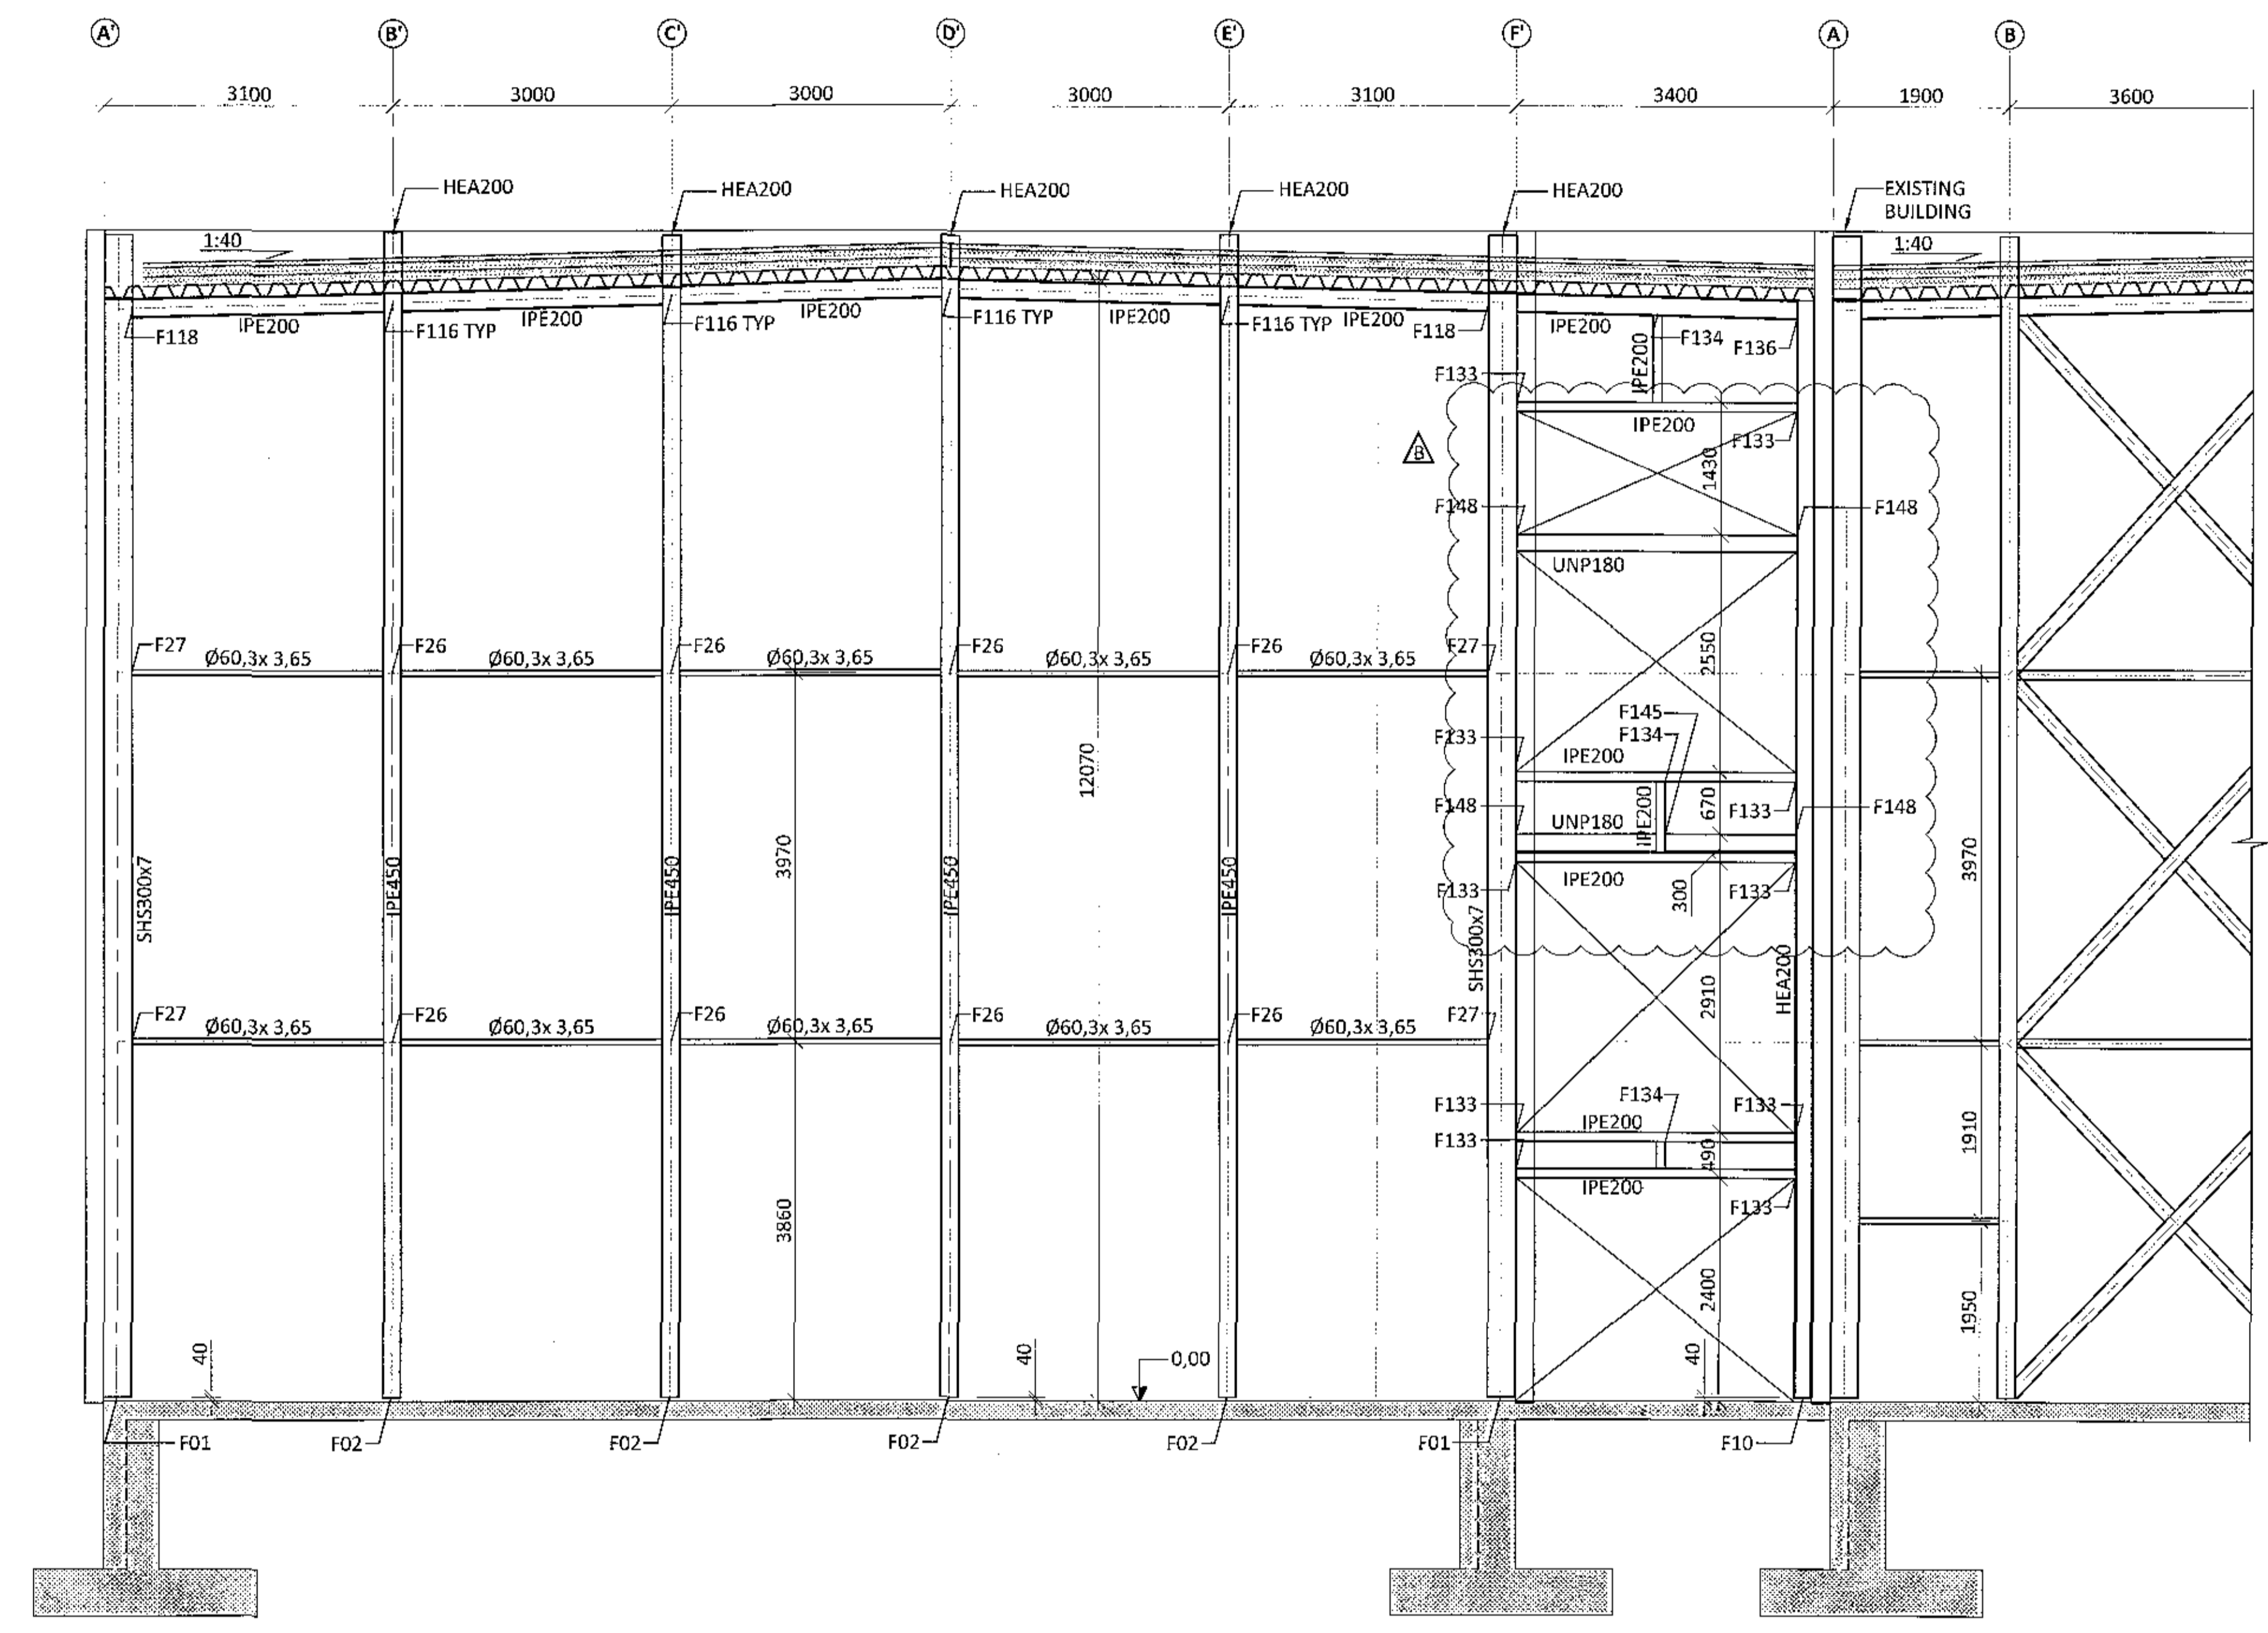

Opfer 01.10.2017

REV.	DATE	DESCRIPTION	APPR.
B	26.09.17	BEAMS ADDED	
A	11.05.17	WINDOW ORIENTATION CHANGED	

ferill

FLUGVELLIR 1 HAFNARFIRÐI
FLIGHT SIMULATOR BUILDING
STEEL STRUCTURE
WALLS
ELEVATION GRIDLINE 1

APPROVED: *[Signature]* ID No. *[Signature]*

DESIGNED	CHECKED	DATE	REV. DATE
DÓ thari@ferill.is	SB	04.04.17	26.09.17
SCALE	PROJECT No.	DWG. No.	REV.
1:50	14014	1 - 2512	B

Ferill ehf. Mörkin 1, 108 Reykjavík, Iceland. Tel: +354 575 1600 www.ferill.is