



Sampykkt þann
14 NOV 2017
Byggingarfulltrúinn í Hafnarfirdi
F.h. Sigurður Steinar Jónsson

MÖTTEKID:
ÚTI **INN**
A R K I T E K T A R
BALDUR Ó. SVAVARSSON
ARKITEKT EAFI SAMMÁK
120337 5149

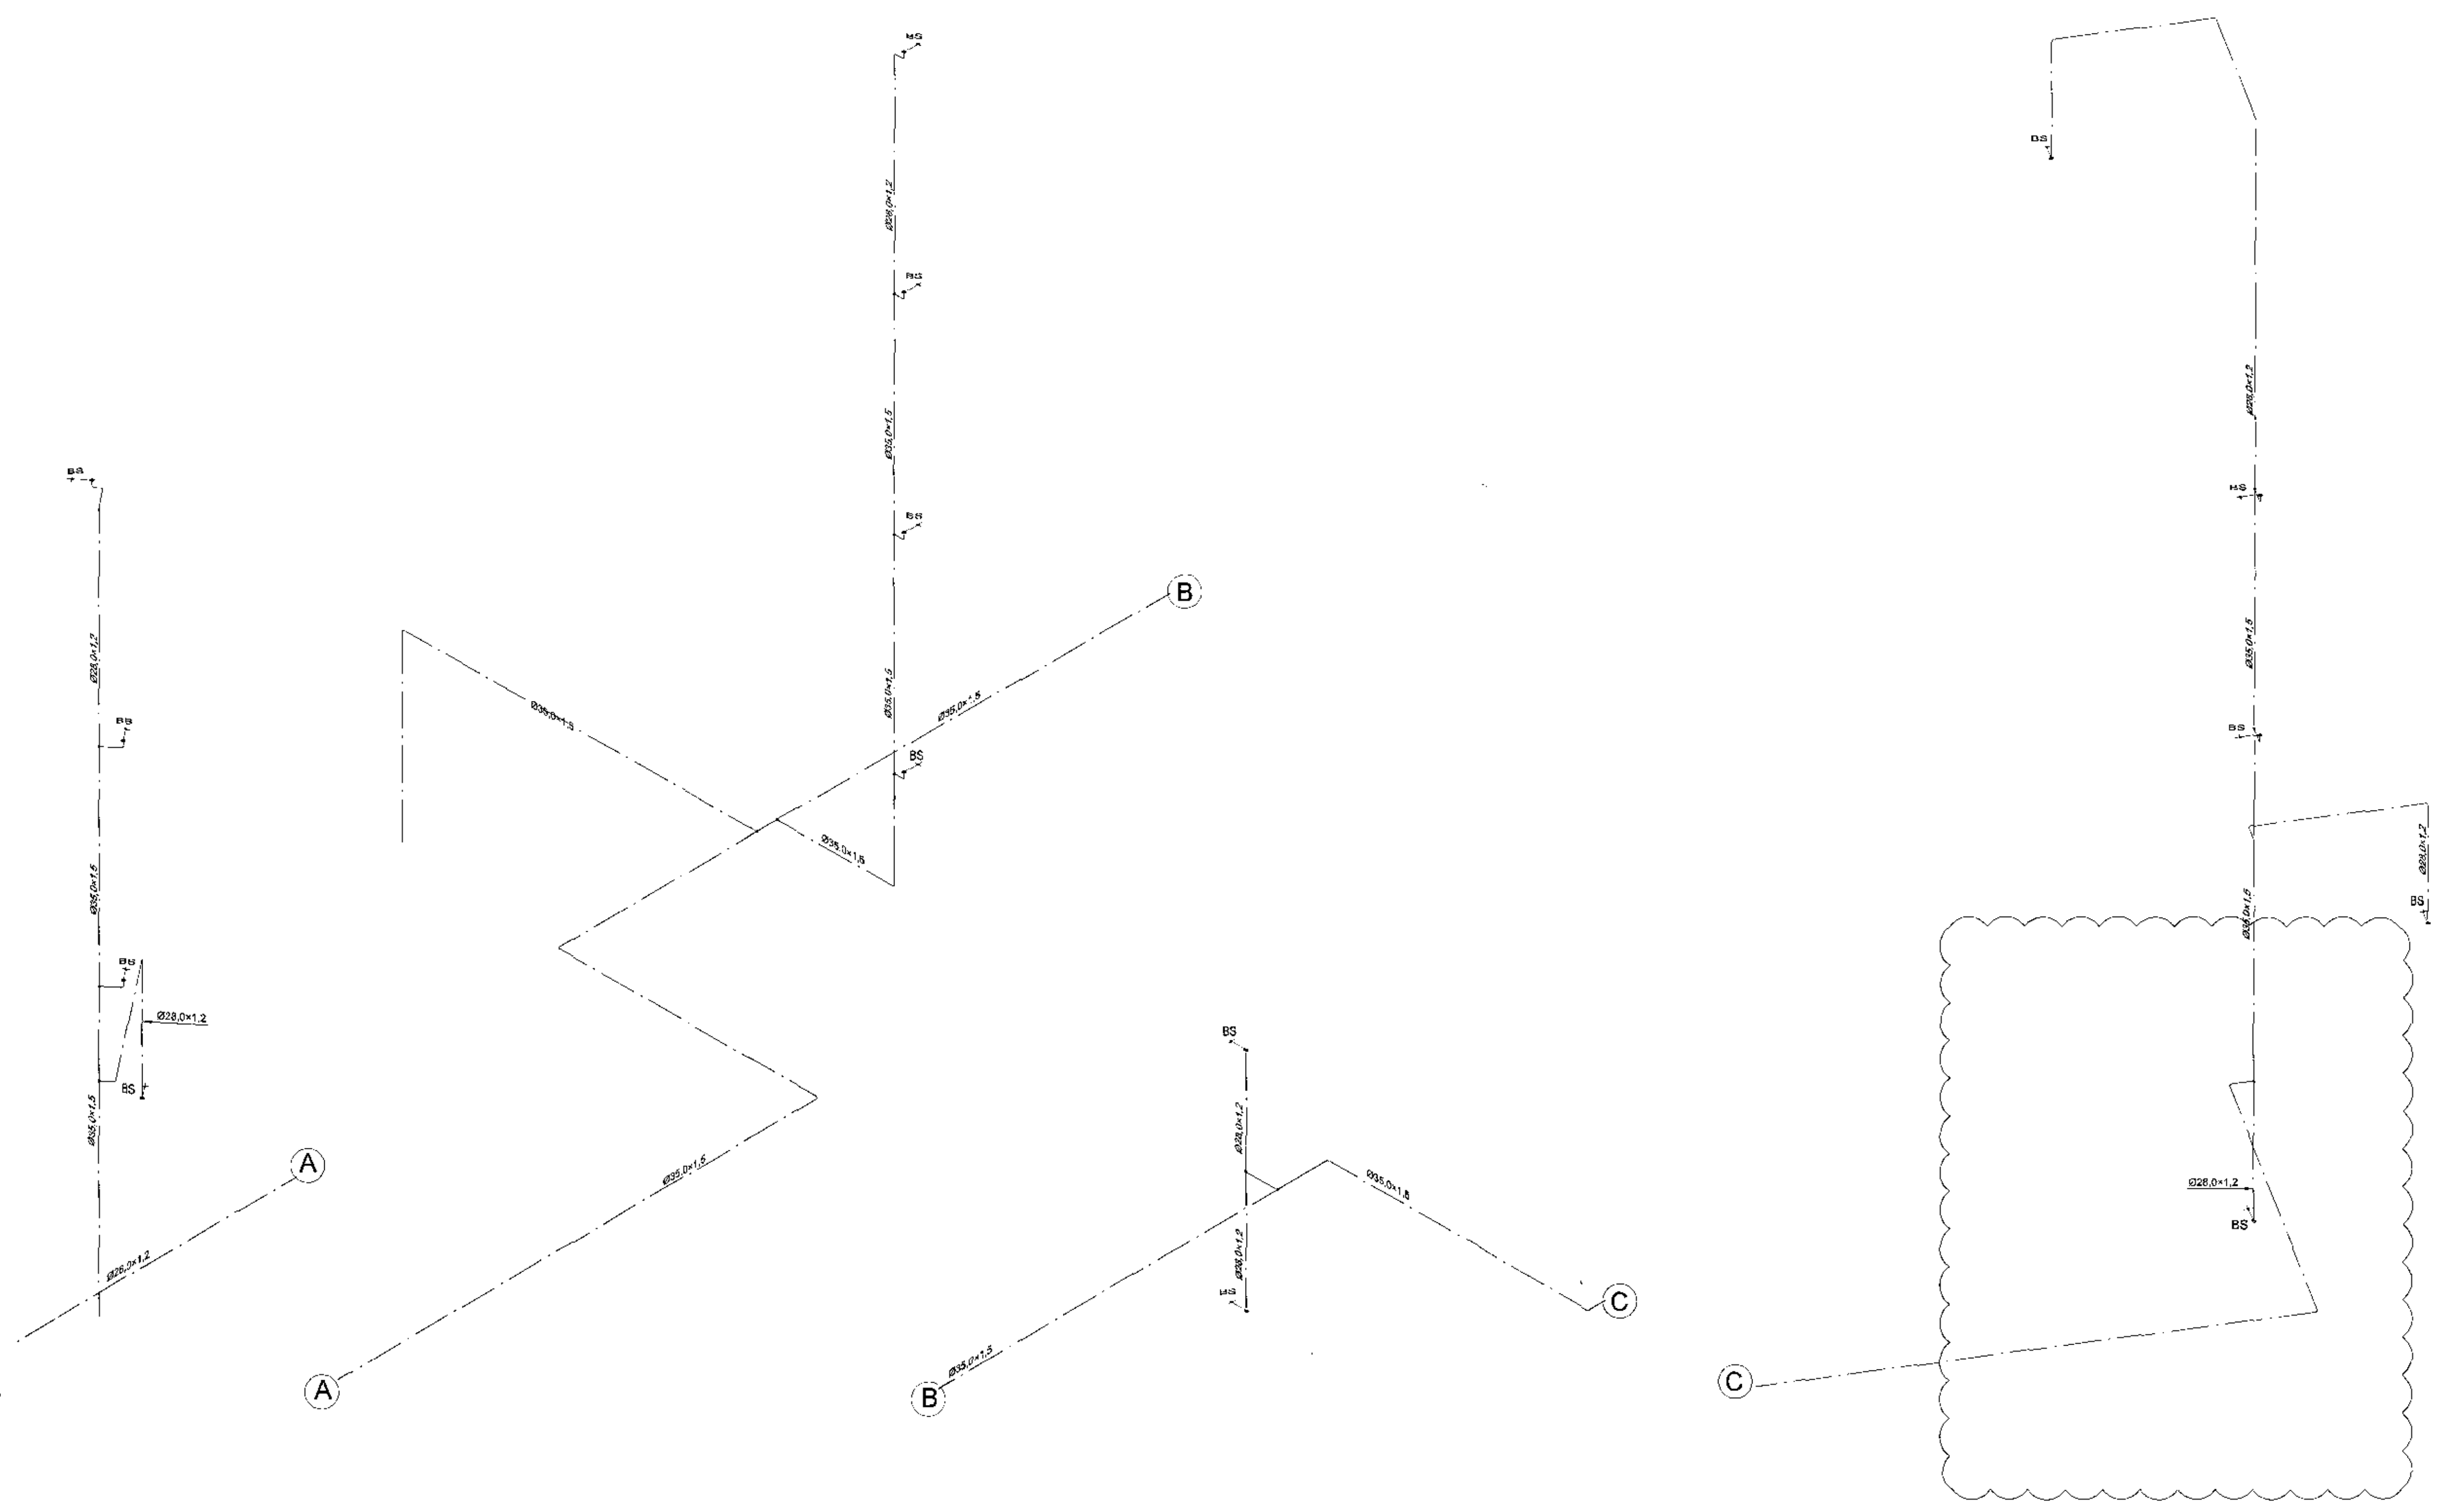

DALSHRAUN 3

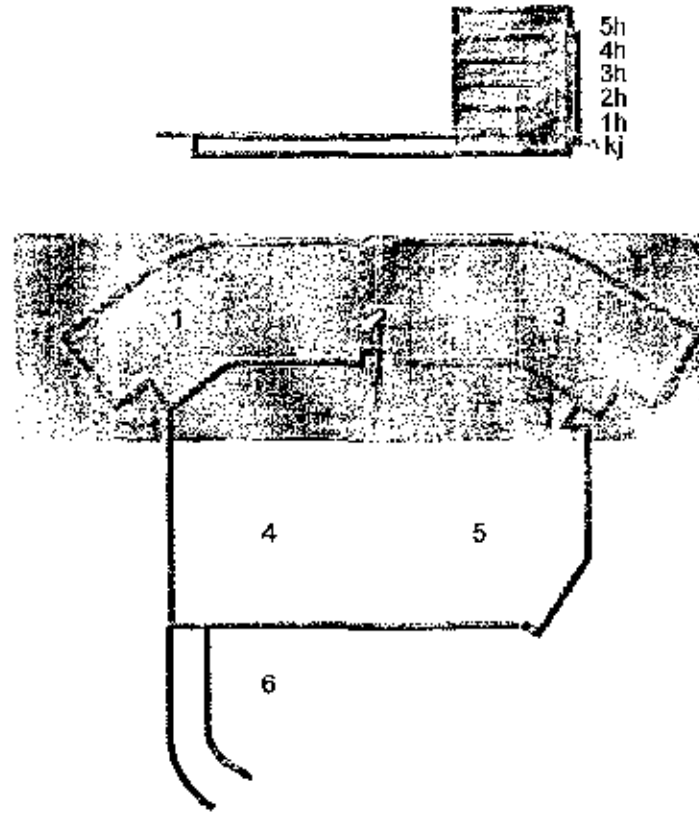

B 09.09.17 Breytingar á Mígnum PDE/SAG
A 23.05.16 Brunalagga ferðar BS/SAG
Útg. Dags. Skýring Hannabryttir/ab



VERKFRÆÐISTOFA

BÆJARHRAUN 20 • 220 HAFNARFJÖRÐUR - KENNIT. 710768-2899
vsb@vsb.is • Sími 565 8800 • Fax 565 9610 • www.vsb.is

Ákuttur aðilar
Sveinn Aki Sverrisson
Kt. 230655 5809 • sv@vsb.is

Verkið
DALSHRAUN 3
HAFNARFIRÐI

Verkið
Lagnir
Brunalagnir
Rúmmynd stammar

Hannab	Teiknad	Yfirvörð	Kvartí	Stöð
BIB	BIB	SÁS	-	/A1
Dags.	Verkefni	Teikning	Útgáfa	B
20.06.2013	07244	P3 902		

V:\00707244\107244-Dalshraun 3\Bunna\07244-P3_01.dwg