



ARITUN BYGGINGARFULLTRUA  
 Sími 544 1100  
 20. des. 2017  
 Byggingarfulltrú  
 (1/12)

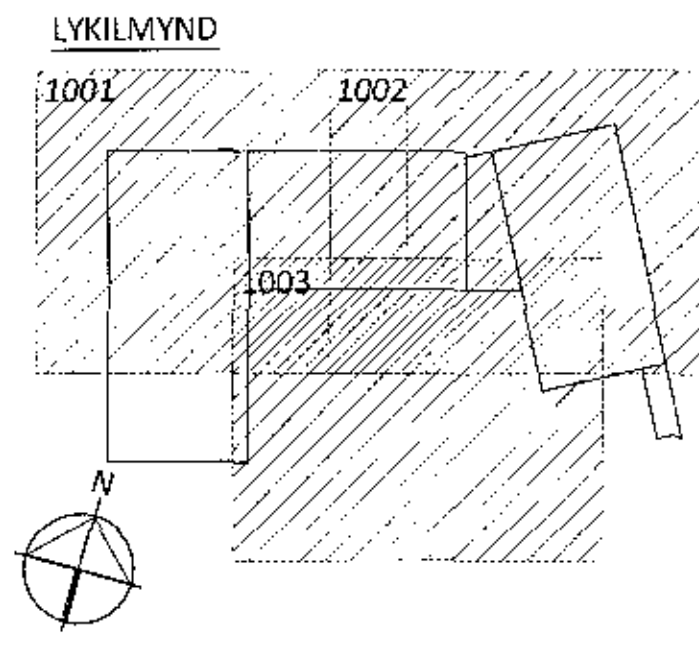

ARITUN BYGGINGARFULLTRUA KT. 041231-2017  
 ALEMNNAR SKÝRINGAR SJÁ TEIKNINGU 6-A000

A 30.11.17 SNIÓBRÆÐSLU BÆTT VID OG ELDRI ADLÖGUDAG		
BR.	DAGS.	BREYTING

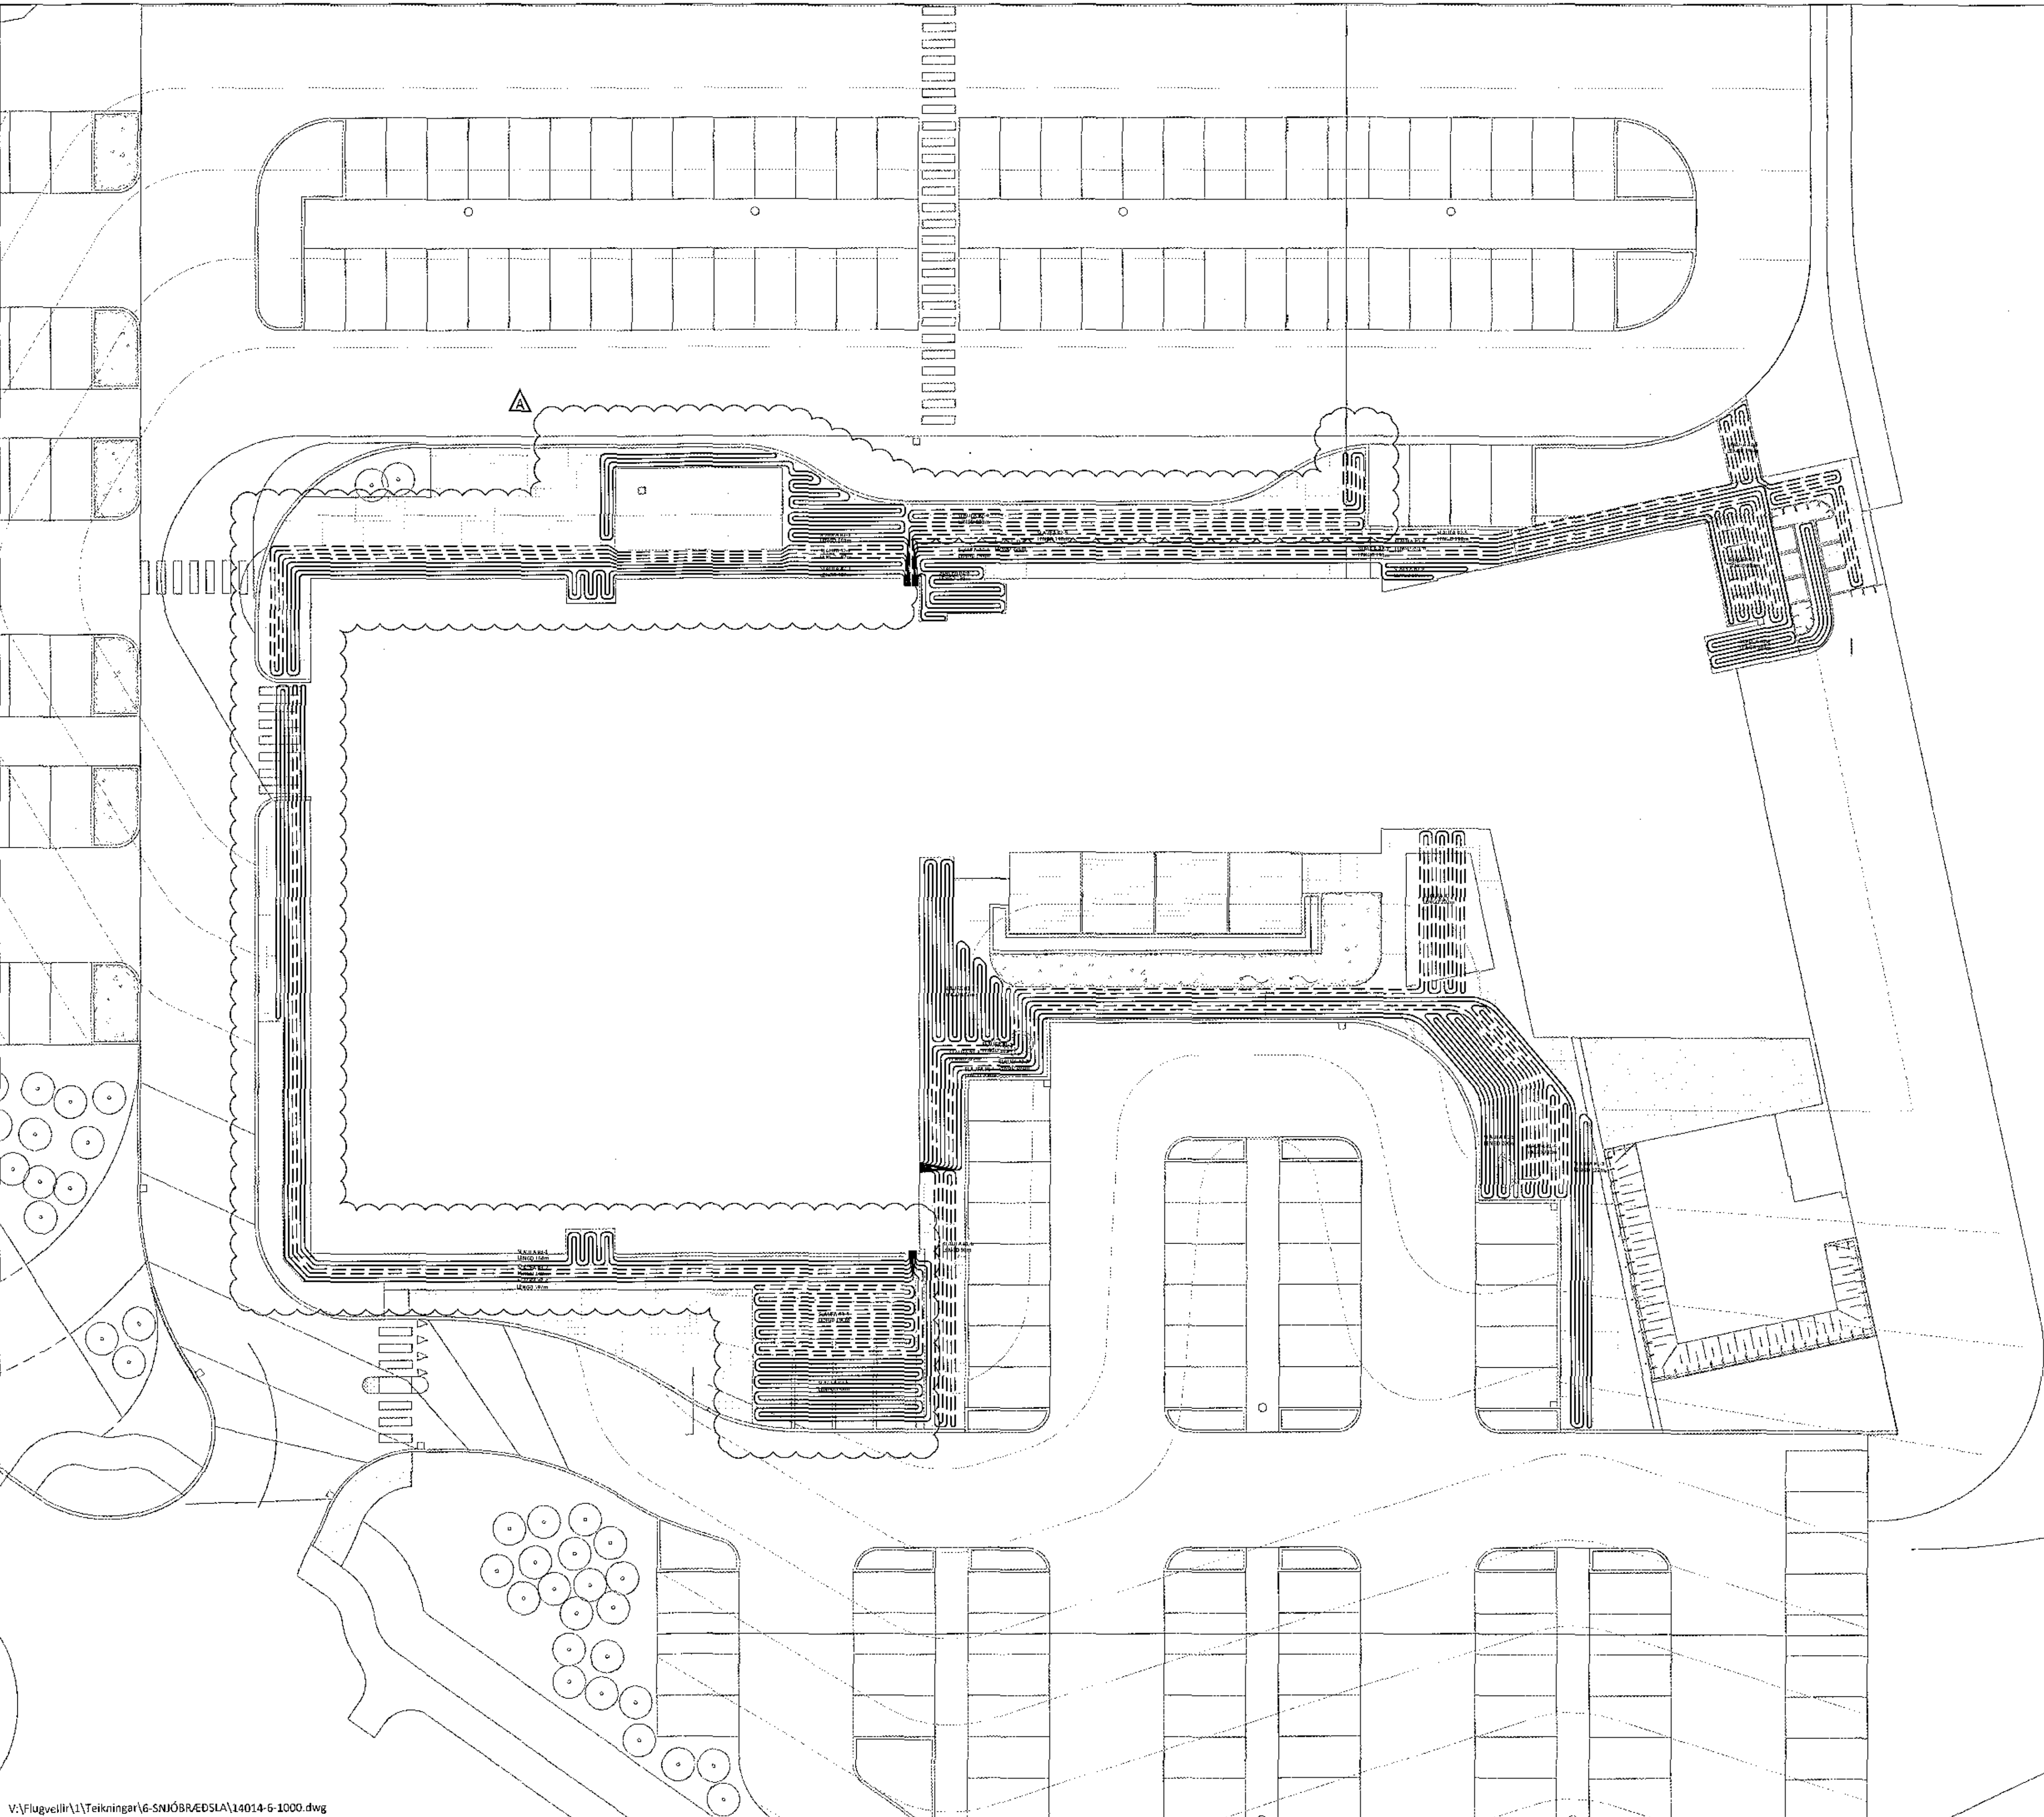

**FLUGVELLIR 1** HAFNARFIRDI  
 NÝBYGGING  
 SNIÓBRÆÐSLA  
 LÖB  
 YFIRLISTMYND - GRUNNMYND

TÖNNUNDIR HPV hjalti@ferill.is MKV. 1:200	YFIRFARIB PAG VERKNR. 14014	DAGS. UTG. 20.01.16 TEIKN. NR. 6 - 1000	DAGS. BREYT. 30.11.17 BREYT. A
--	--------------------------------------	--	---