PLATA YFIR 1. HÆÐ - GRUNNMYND M1:50

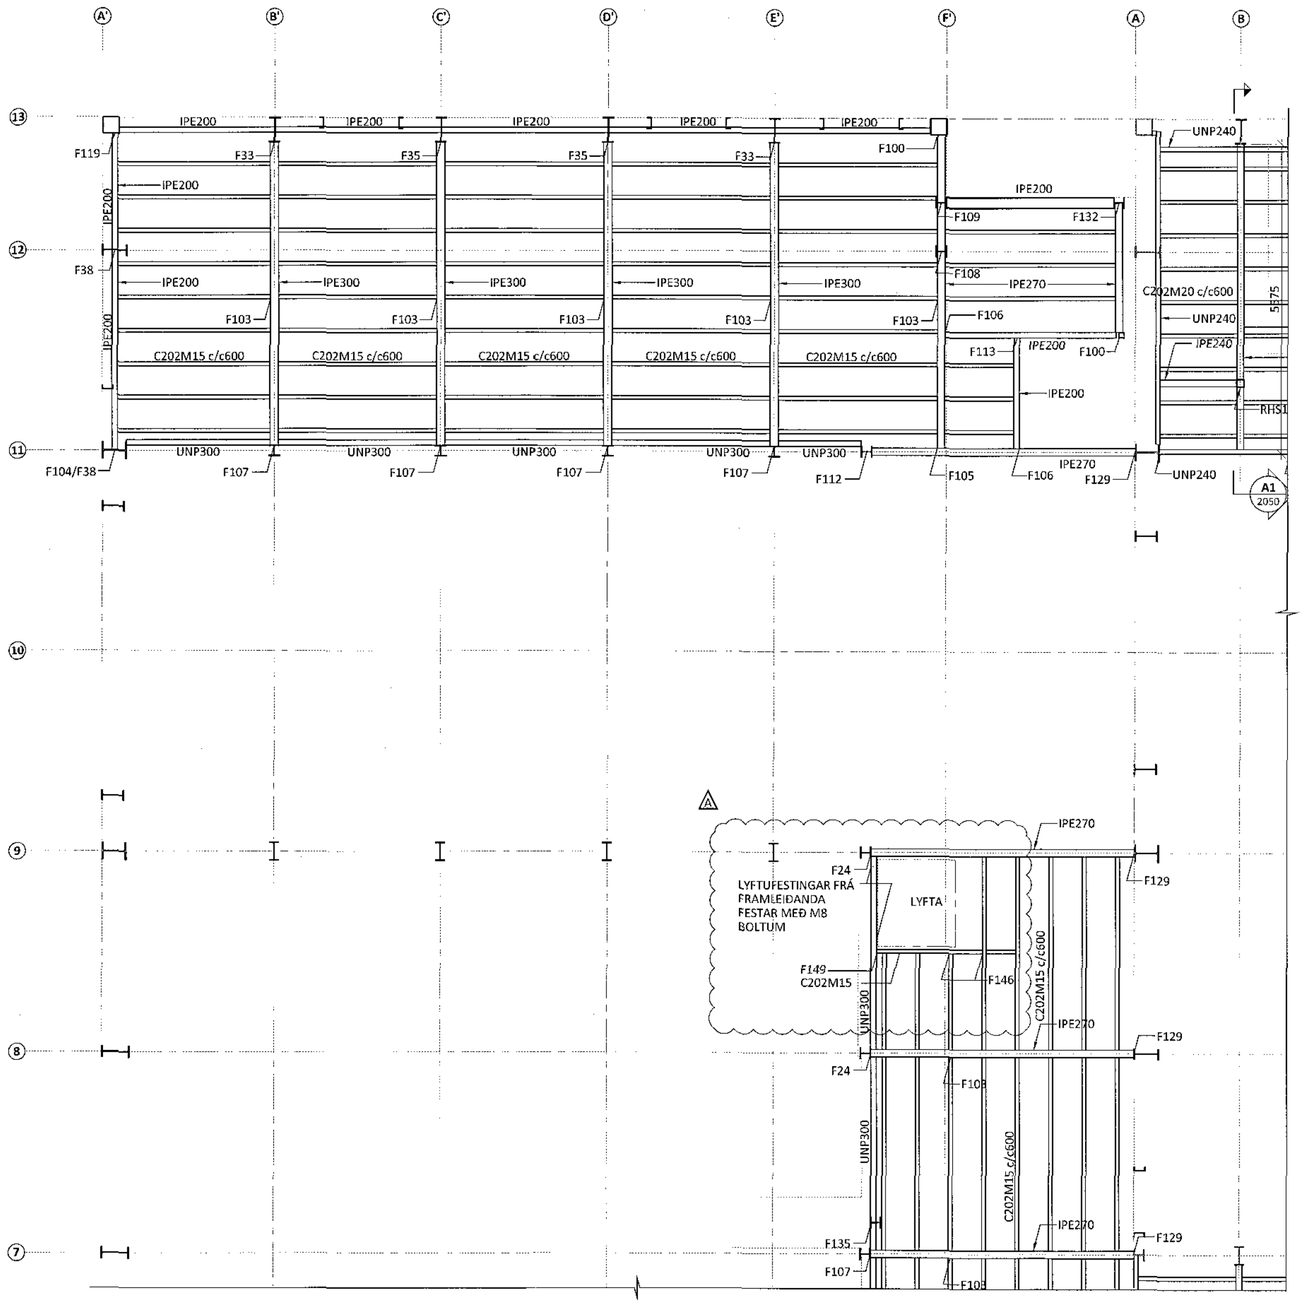

ÁRITUN BYGGINGARFULLTRÚA

20. des. 2017

GENERAL NOTES:

- ALL UNITS ARE mm
- ALL ELEVATIONS ARE m
- ALL STEEL SHALL BE ACCORDING TO EN 1993-1-1:2005
- EXECUTION OF STEEL STRUCTURE SHALL BE ACCORDING TO EN 1090-2-2008
- STEEL GRADE OF MEMBERS SHALL GENERAL BE S235 EXCEPT CROSS BRACING (SHS100x5) *SHALL BE STEEL GRADE S355*
- ALL BOLTS SHALL BE IN CLASS 8.8
- SURFACE TREATMENT OF ALL STEEL SHALL BE ACCORDING TO CORROSIVITY CATEGORY C3. STEEL SHALL BE PAINTED WITH PRIME COTE AND ON TOP OF THAT TWO LAYERS OF APPROPRIATE PAINT OF DARK GRAY COLOR (RAL 7016, GLOSS 35-40%) MINIMUM THICKHNESS SHALL BE 100µm. PAINT SYSTEM SHALL BE APPROVED BY FERILL.
- C-SECTIONS ACCORDING TO METSEL PRODUCTION

LYKILMYND

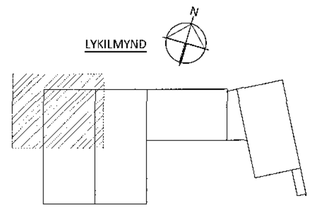

ÁRITUN ÁÐALHÖNNUÐAR: 04/251-2019

BR.	DAGS.	BREYTING	SAMP.
A	27.11.17	LYFTU BÆTT VIÐ	

ferill VERKFRÆÐISTOFA

FLUGVELLIR 1 HAFNARFIRÐI
NÝBYGGING
BURÐARVIRKI
PLATA YFIR 1. HÆÐ
GRUNNMYND

SAMÞYKKT: KT.

HÖNNUÐUR	YFIRFARIÐ	DAGS. ÚTG.	DAGS. BREYT.
ÞÓ thorri@ferill.is	SB	04.04.17	27.11.17
MKV.	VERKNR.	TEIKN. NR.	BREYT.
1:50	14014	1 - 1106	A

Ferill ehf Mörkin 1 108 Reykjavík Sími: 575 1600 Fax: 575 1601 www.ferill.is

V:\Flugvellir\1\Teikningar\1-BURÐARÞOL\14014-1-1100.dwg