
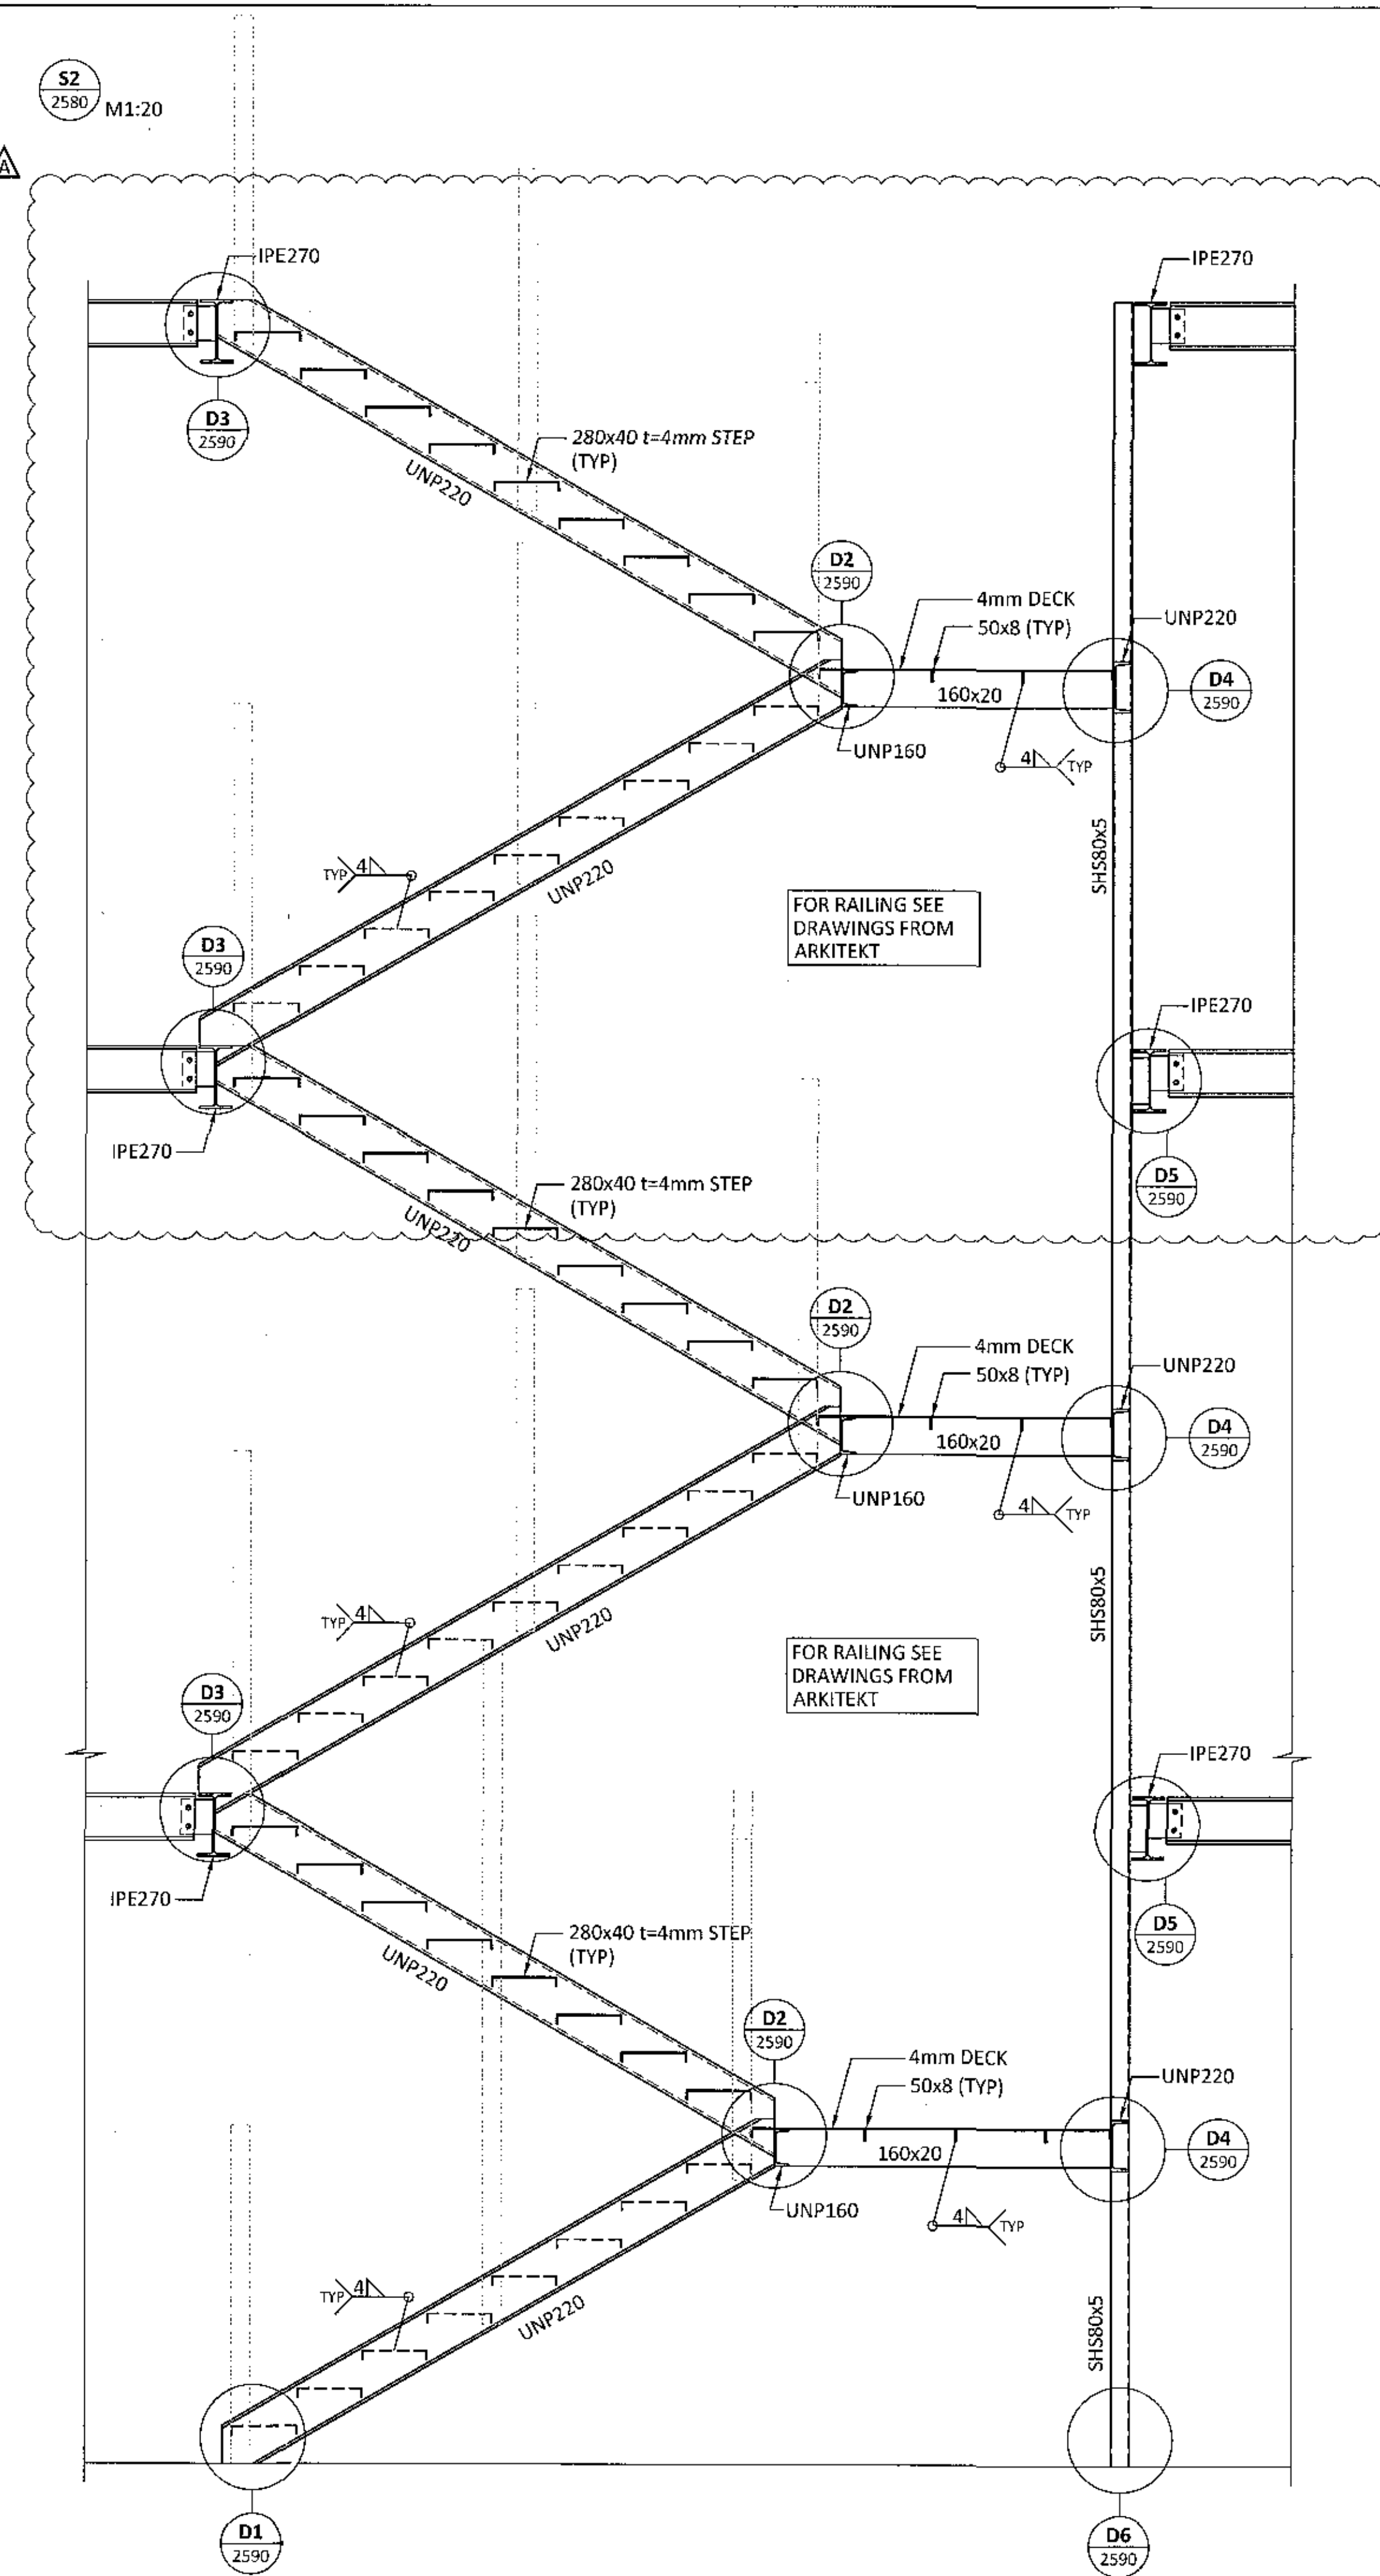


ARITUN BYGGINGARFULLTUDA
 28. des. 2017
 14/19

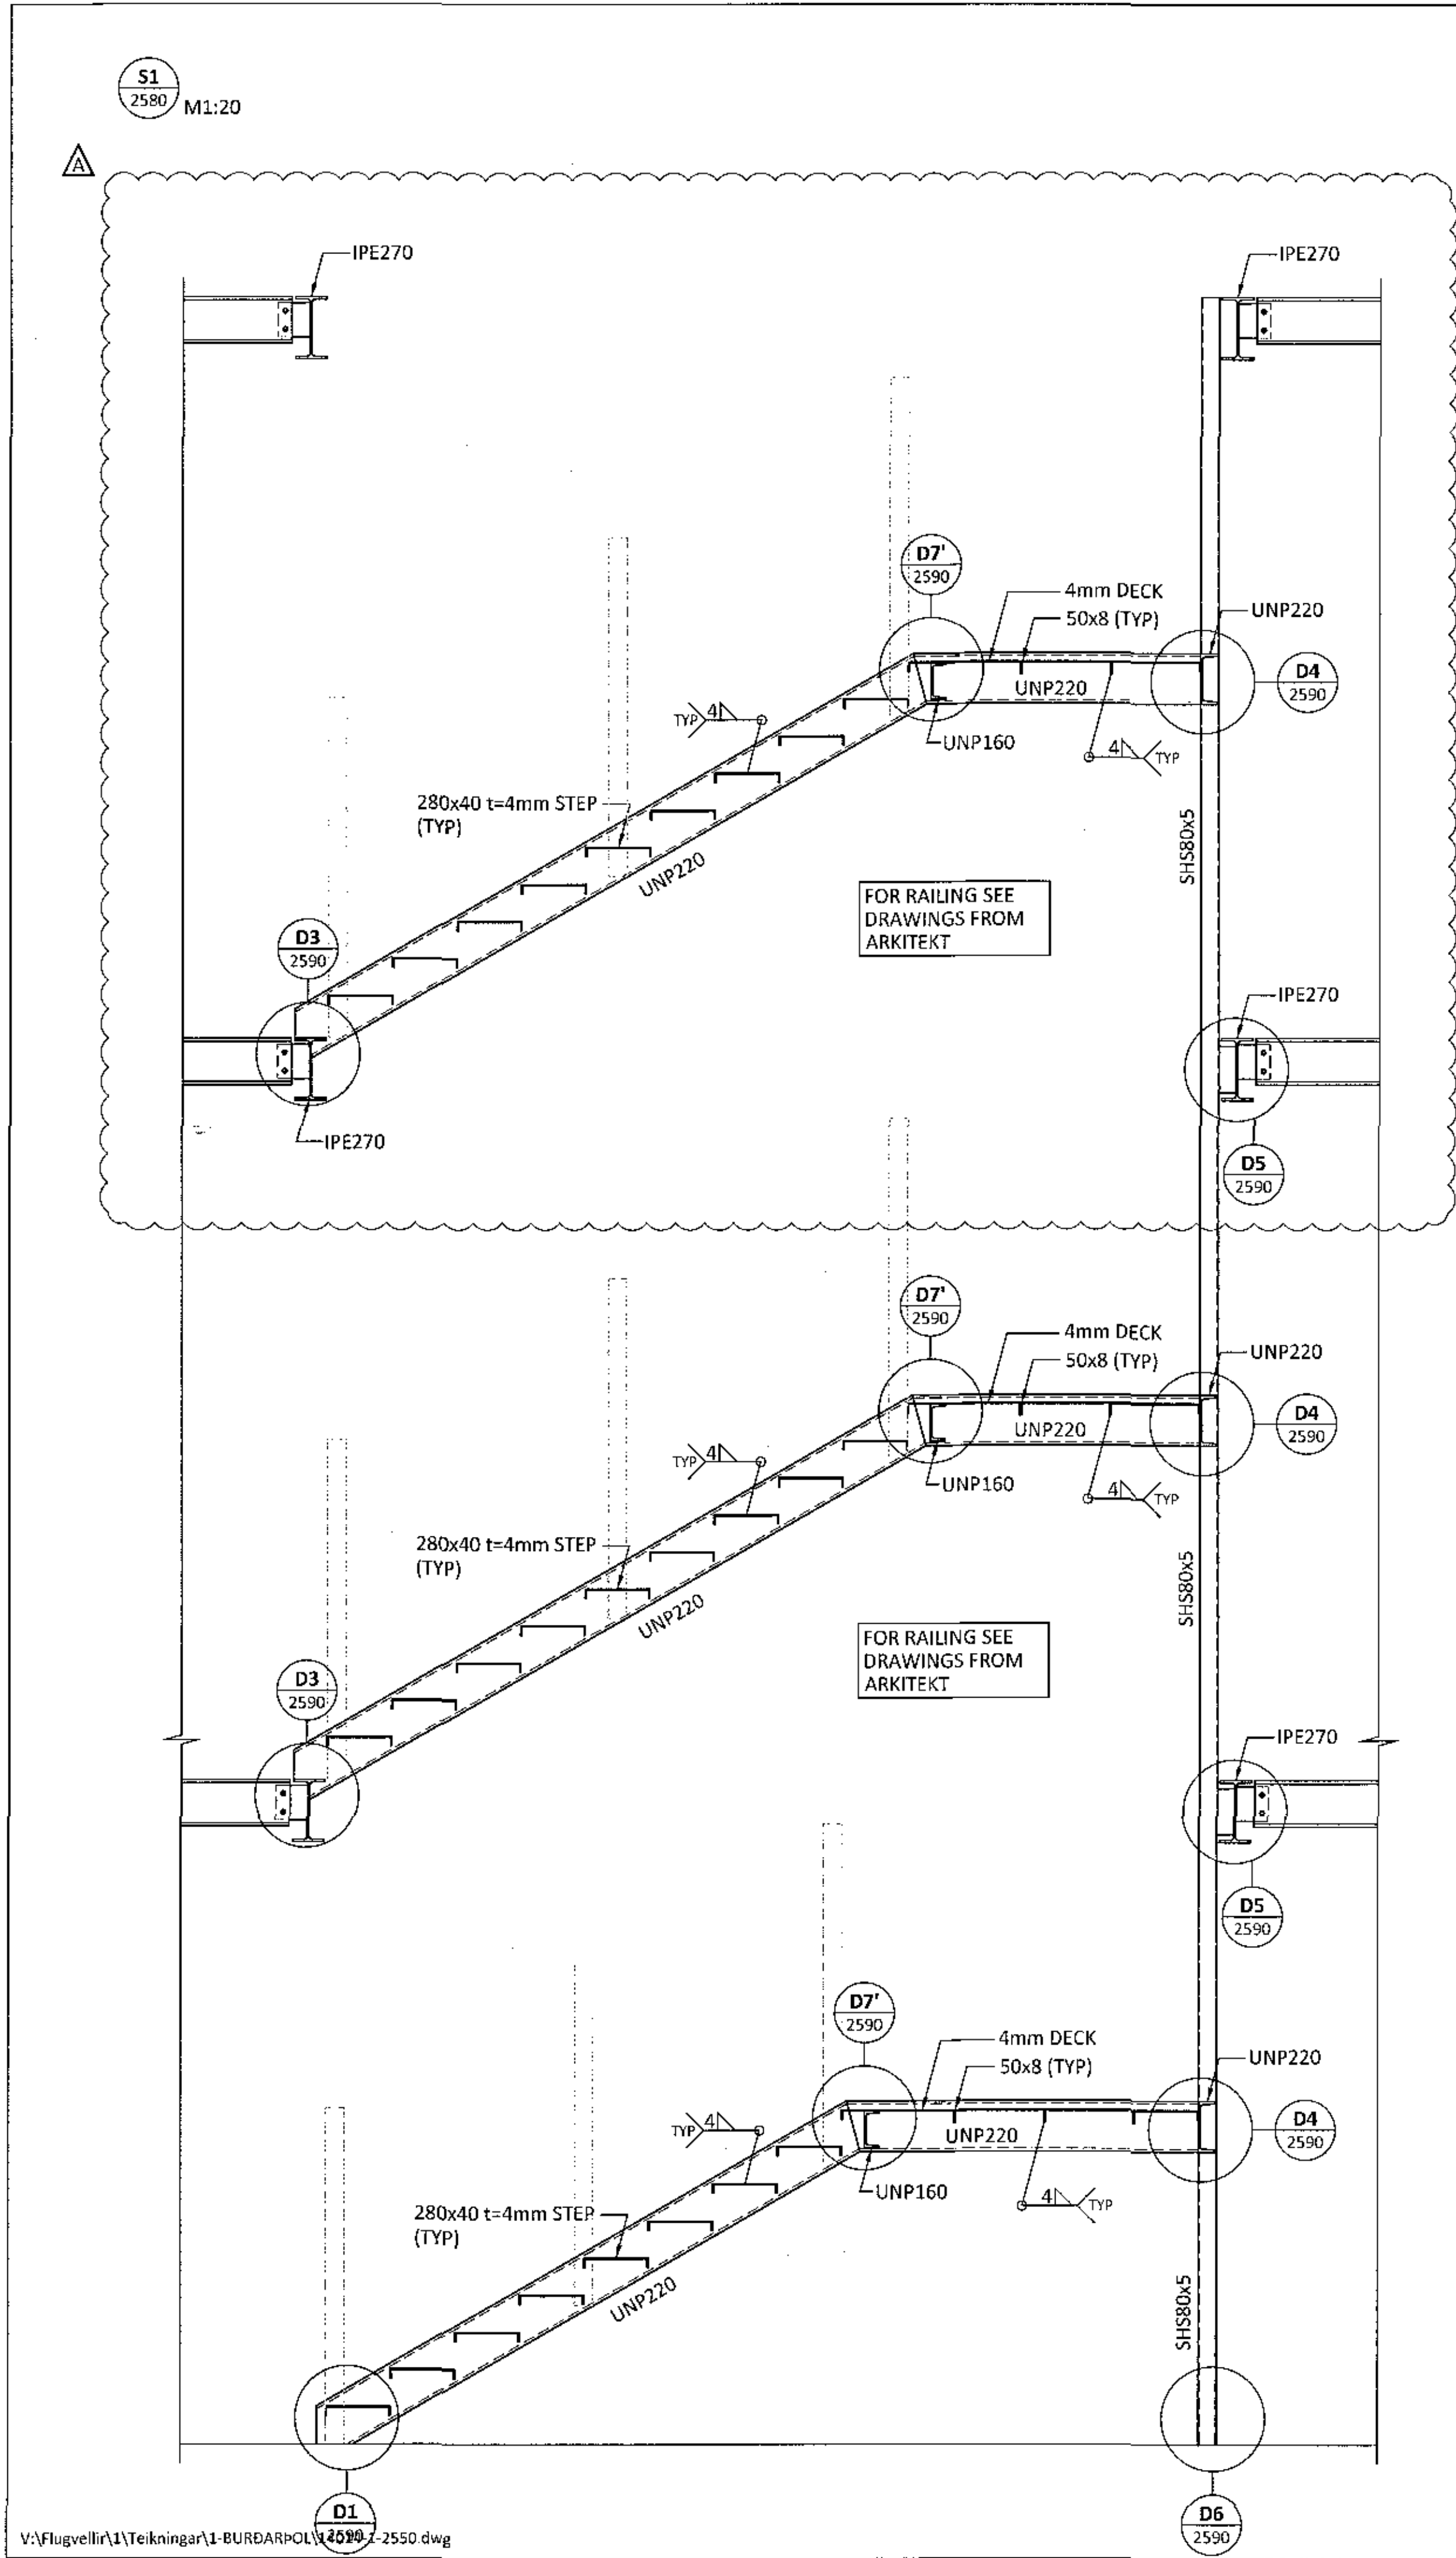

V:\Flugvellir\1\Teikningar\1-BURDARPOL\2590-2550.dwg

ARITUN BYGGINGARFULLTUDA

27.11.17 GEYMSLULOFTI BÆTT VID

ferill
VERKFRÆÐISTOFA

FLUGVELLIR 1 HAFNARFIRDI
 FLIGHT SIMULATOR BUILDING
 STEEL STRUCTURE
 STAIRS
 SECTIONS

HÖNNUÐUR	VERFARID	DAGS. LIT.	DAGS. BREYT.
PÓ	SB	26.09.17	27.11.17
MKV.	VERNR.	TEK.NR.	BREYT.
1:20	14014	1 - 2581	A

Ferill ehf. Mörkin 1, 108 Reykjavík. Sími: 575 1600. Fax: 575 1601. www.ferill.is