


ÁRTUN BYGGINGARFULLTRIA
 1703047 29.11.2017
 21. des. 2017
 Byggingarfulltría



ÁRTUN ÁBYGGINGARFULLTRIA
 01.12.2019

A 22.11.17 LÖGNUM BÆTT VÍÐ			
BR.	DAGS.	BREYTING	SAMP.

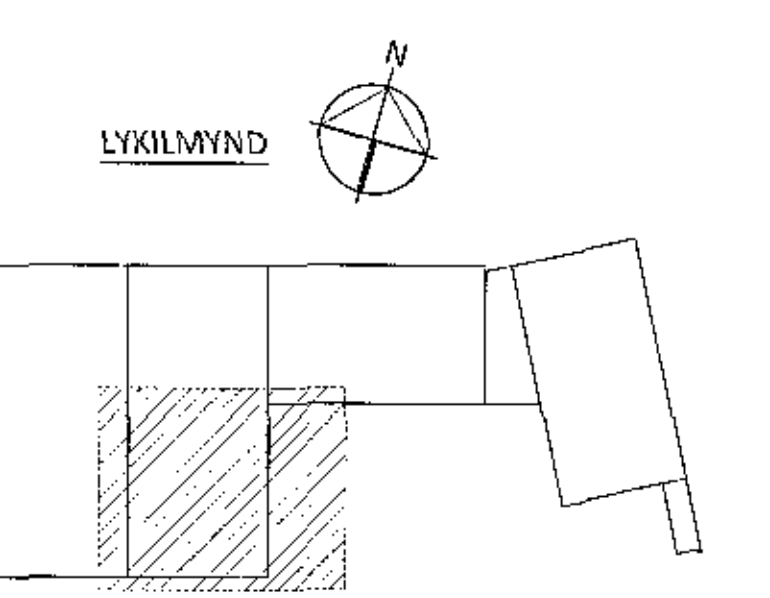

FLUGVELLIR 1 HAFNARFIRÐI
 NÝBYGGING
 HITA- OG PRIFAKERFI
 2. HÆÐ
 GRUNNMYND

SAMPRÆKTA			
Ólaf Gunnarsson KT. 270760-4229		HAG	
HÖNNUNUR	YFIRFARID	DAGS. UTG.	DAGS. BREYT.
HDV bjalti@ferill.is	DAG	08.08.14	22.11.17
MKV.	VERKNR.	TEKNI. NH.	BREYT.
1:50	14014	3-1202	A