
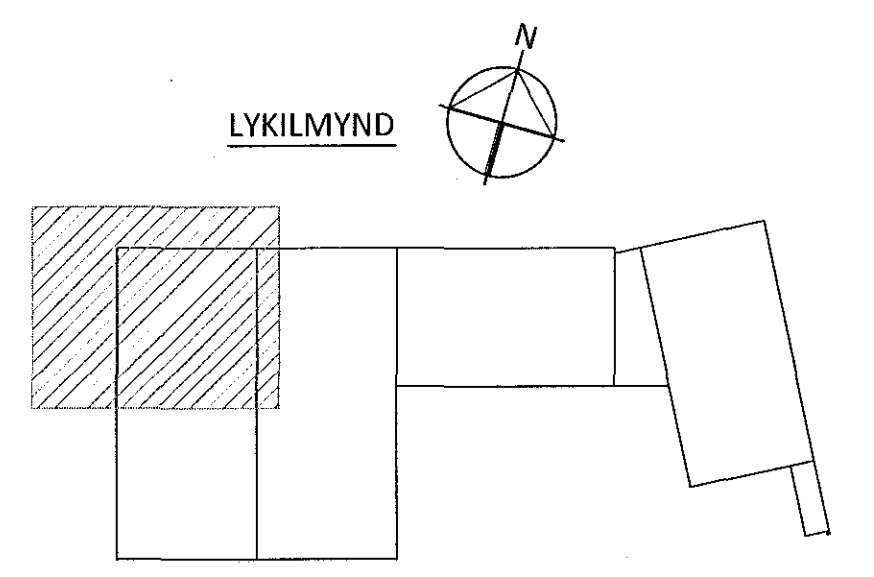


93.18 1404182

1. HÆÐ - GRUNNMYND M1:50

ÁRITUN BYGGINGARFULLTRÚA

Samþykkt þann
13. mars 2018
Byggingarfulltrúi *[Signature]*

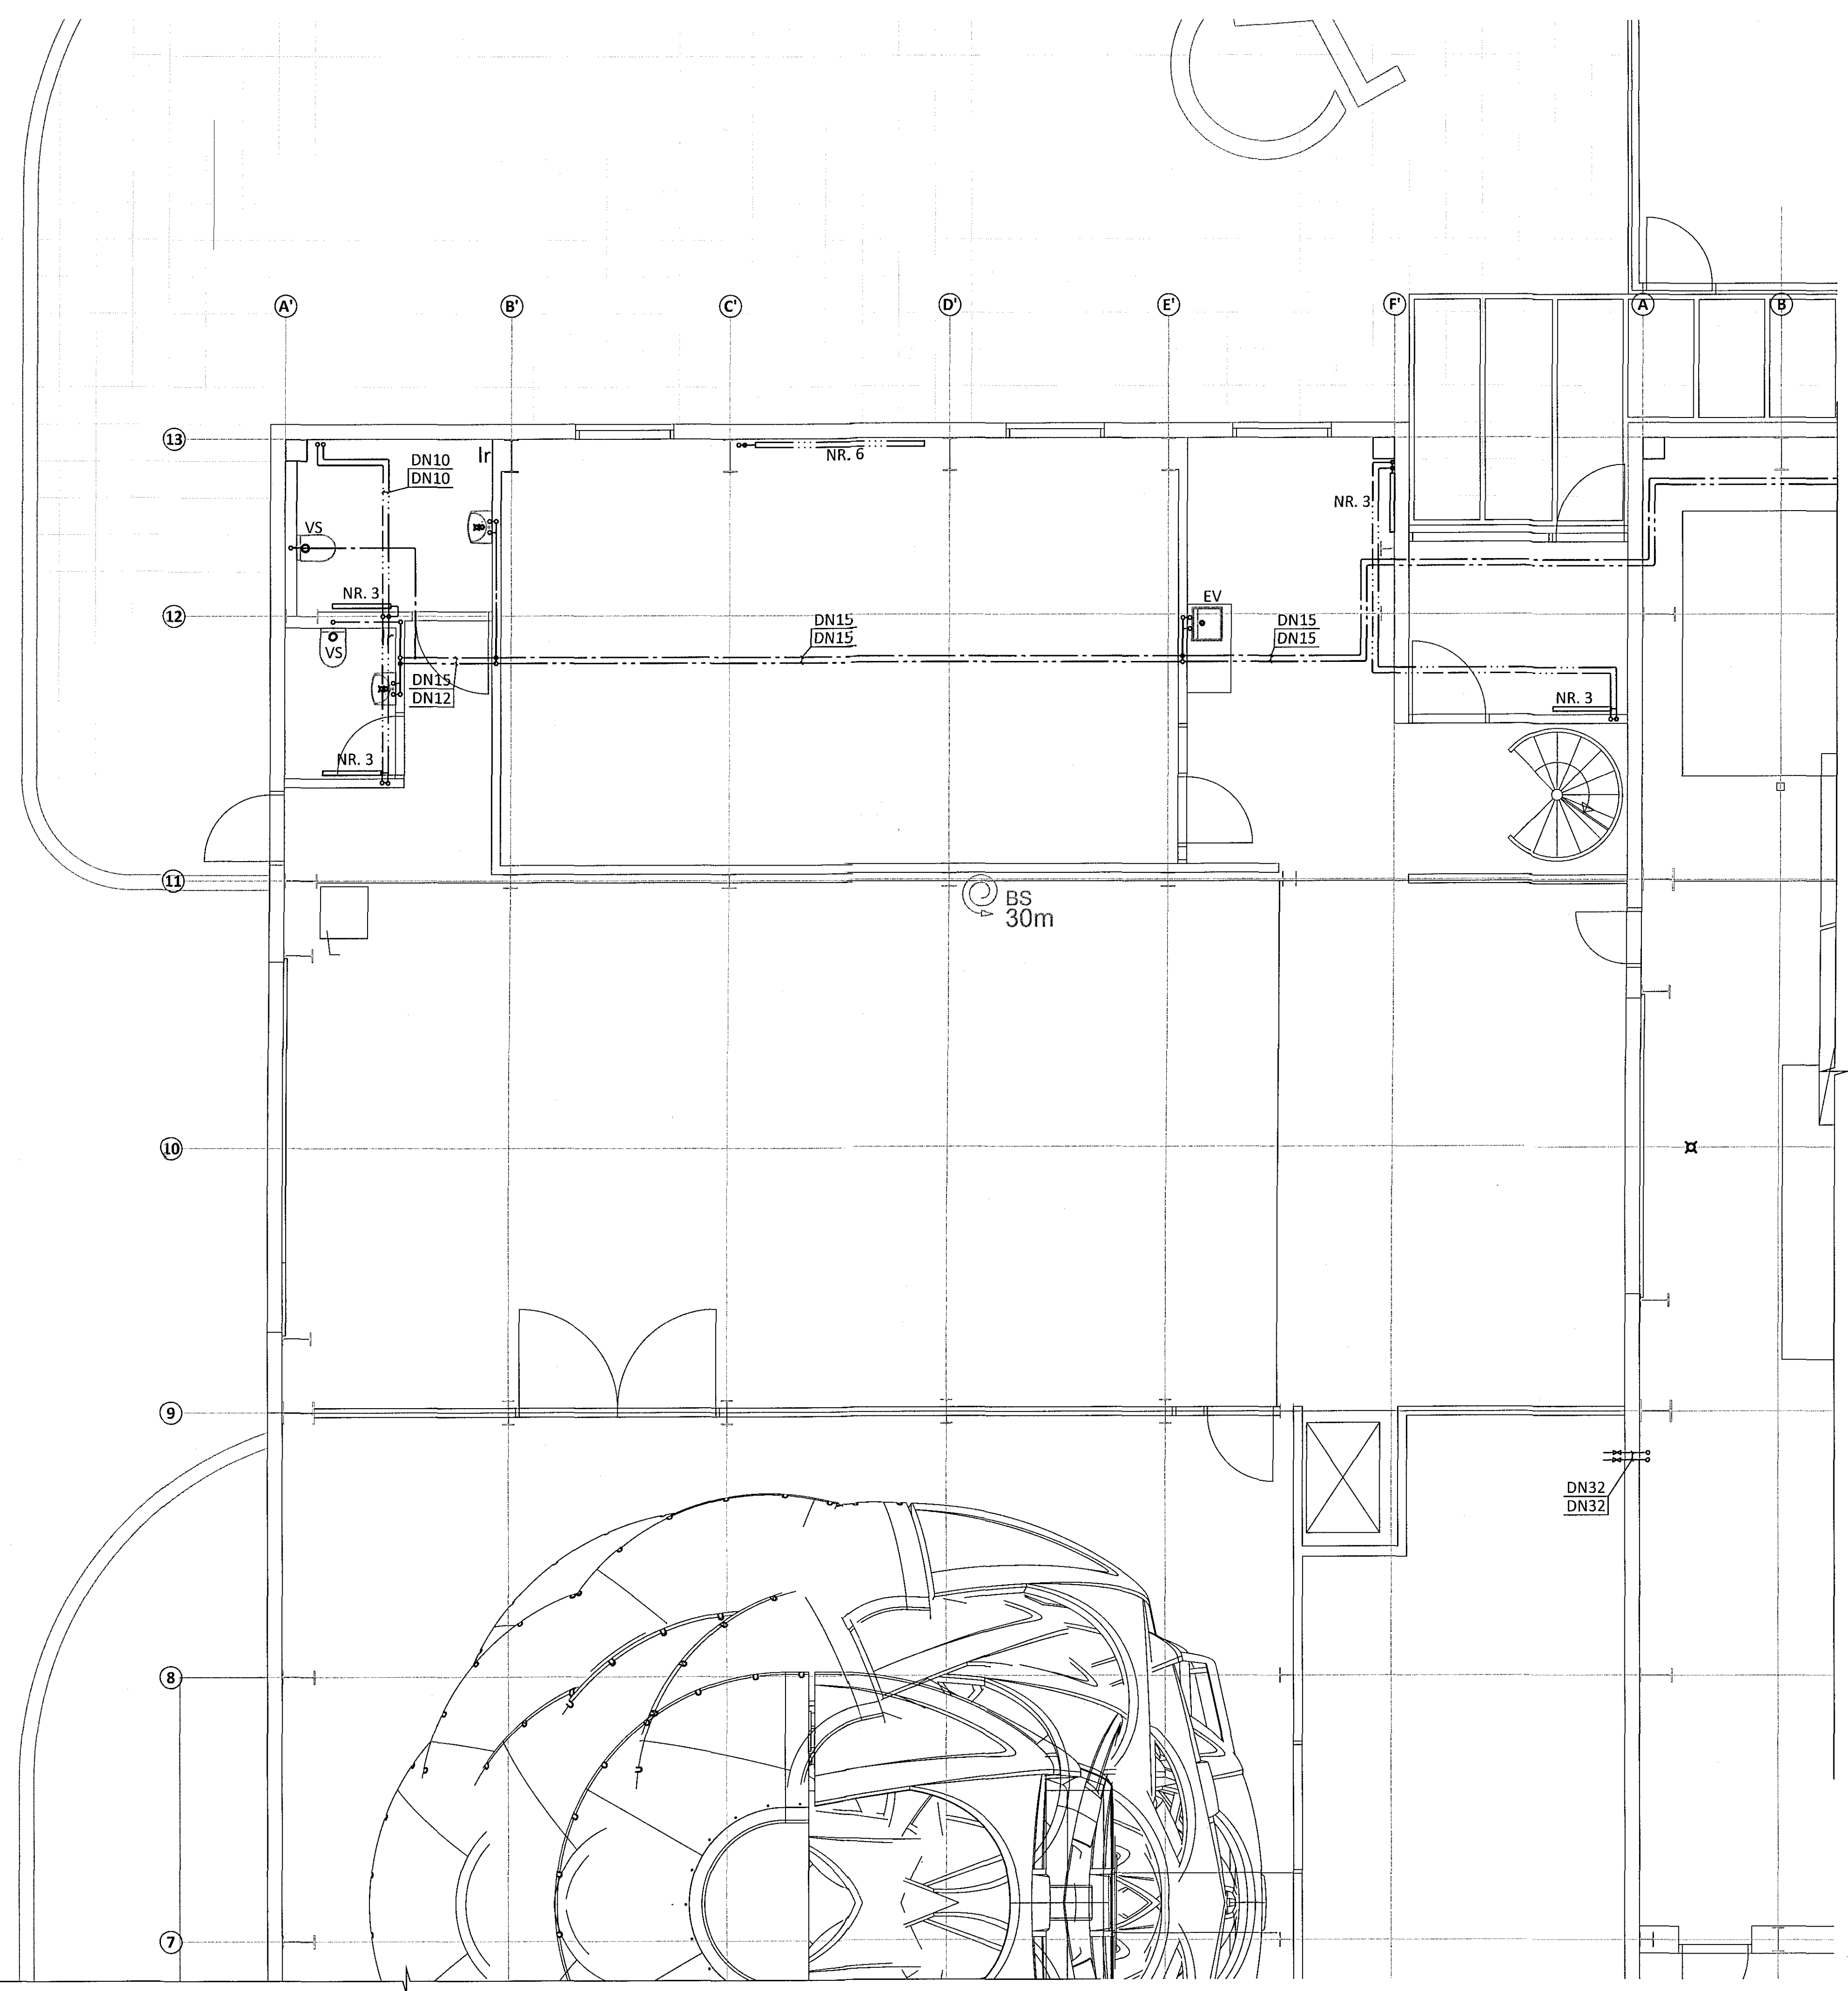

ÁRITUN AÐALHÖFUNDARNA KT. 04/02/2017

B	28.02.18	REYNDARTEIKNING	
A	11.01.18	OFNUM BÆTT VID	
BR.	DAGS.	BREYTING	SAMP.



FLUGVELLIR 1 HAFNARFIRDI
NÝBYGGING
HITA- OG PRIFAKERFI
1. HÆÐ
GRUNNMYND

SAMPYKKE: *[Signature]* KT. 170760-4229

HÖNNUÐUR	YFIRFARID	DAGS. ÚTG.	DAGS. BREYTL.
HPV hjalti@ferill.is	PAG	22.11.17	28.02.18
MKV.	VERKNR.	TEK.NR.	BREYTL.
1:50	14014	3-1108	B

Ferill ehf. Mörkin 1 108 Reykjavík Sími: 575 1600 Fax: 575 1601 www.ferill.is